

**LEGEND**  
 SEE GENERAL LEGEND, SHEET 4

	PROPOSED ROLLED CURB AND GUTTER
	PROPOSED WALK
	PROPOSED WALK BY OTHERS
	PROPOSED WATER LATERAL
	PROPOSED SANITARY LATERAL
	PROPOSED STORM LATERAL
	PROPOSED WATER MAIN
	PROPOSED SANITARY MAIN
	PROPOSED STORM MAIN
	PROPOSED C/L OF CONSTRUCTION
	PROPOSED C/L OF RIGHT OF WAY
	PROPOSED MONUMENT BOX
	PROPOSED BOTTOM OF FOOTER ELEVATION
	PROPOSED ASPHALT PAVEMENT

**GARNETT CIRCLE WATER MAIN FITTING SCHEDULE**

ITEM	STATION	OFFSET
8" WATER MAIN PLUG	27+09.00	20.50' RT.
8" LINE VALVE	27+27.82	20.50' RT.
6" HYD. ASSEMBLY, TYPE B	27+36.74	18.00' RT.
8" LINE VALVE	27+44.40	20.50' RT.
45° BEND	28+66.71	20.50' RT.

**PROPOSED STRUCTURE TABLE**

Structure Name	Structure Details
CB-BH	000T CB 3A STA. 28+30.60, 13.00' LT 28+40.70, 12.06' LT RIM = 1092.91 1092.84 12" PVC Pipe INV (S) = 1088.65 1088.37 12" PVC Pipe INV (N) = 1088.65 1088.37
CB-BI	000T CB 3A STA. 28+39.72, 13.00' RT 28+40.12, 12.03' RT RIM = 1092.91 1092.88 12" PVC Pipe INV (N) = 1088.65 1088.77

**GARNETT CIRCLE CONNECTION SCHEDULE**

UNIT	CONNECTION AT MAIN	RISER HEIGHT	LATERAL TERMINATION LENGTH
117	SAN 25+89.37, 38.76' LT.	—	25+84.64, 59.02' LT. 27.11
118	SAN 26+09.00, 21.28' LT.	—	26+13.33, 48.57' LT. 27.64
119	SAN 26+78.17, 10.34' LT.	—	26+82.18, 40.00' LT. 29.95
120	SAN 27+47.01, 4.44' LT.	—	27+47.87, 40.00' LT. 35.57
44	SAN 28+16.49, 6.31' LT.	—	28+14.14, 40.00' LT. 33.77
44	ST 28+10.91, 14.51' LT.	—	28+09.13, 40.00' LT. 25.55
44	WAT 28+26.42, 20.50' RT.	—	28+26.41, 40.00' LT. 60.50
44	SAN 28+81.07, 15.56' LT.	—	28+72.90, 54.43' LT. 41.48
45	ST 28+50.14, 0.66' LT.	—	28+68.65, 54.43' LT. 54.35
45	WAT 28+54.43, 20.50' RT.	—	28+47.20, 43.25' LT. 64.16
45	SAN 28+99.41, 30.10' LT.	—	28+97.66, 59.75' LT. 29.86
45	ST 28+88.69, 12.09' RT.	—	28+91.82, 59.58' LT. 71.78

**NOTE:**  
 ANY SERVICE LATERAL CROSSING WATER MAIN SHALL MAINTAIN 18" MINIMUM CLEARANCE.  
 ALL WATER MAIN PIPE JOINTS WITHIN AREAS OF FILL MUST BE RESTRAINED.

**NOTE:**  
 LOT 43 TO BE BUILT AFTER  
 TEMPORARY CUL-DE-SAC REMOVED.  
 CURBING FROM STATION 28+38.80, 13FT RIGHT TO 29+81.63, 13FT RIGHT WILL BE INSTALLED DURING PHASE II. WARP ASPHALT AT CATCH BASIN TO PROTECT.

**STORM SEWER**  
 REFER TO GENERAL NOTES SHEET 5 FOR GENERAL NOTES.  
 ALL RCP PIPE SHALL BE CLASS 4 PER ODOT 706.02  
 ALL HDPE PIPE SHALL BE SMOOTH LINED PER ODOT 707.33  
 ALL PVC PIPE SHALL BE SDR 35 PER ODOT 707.45

**Underground Utilities**



2 Working Days Before You Dig  
 Call 800-362-2764 (Toll Free)  
 Ohio Utilities Protection Service

Non-members Must Be Called Directly  
 Call 800-925-0988 (Toll Free)  
 Oil & Gas Producers Utility Protection Service

**NOTE:**  
 ALL OIL AND GAS WELL REMOVALS, PLUGGING/CAPPING, AND ABANDONMENTS SHALL BE IN ACCORDANCE WITH ALL ASSOCIATED REGULATIONS FOR SUCH REMOVALS, INCLUDING BUT NOT LIMITED TO, ODNR, LOCAL, STATE, AND FEDERAL.  
 EXISTING HIGH PRESSURE GAS MAIN SHALL BE LOCATED AND PROTECTED PRIOR TO AND THROUGHOUT CONSTRUCTION.

**AS-BUILT LEGEND**

	DESIGNED WATER VALVE
	DESIGNED HYDRANT
	ASBUILT ELECTRIC PULLBOX
	ASBUILT WATER VALVE
	ASBUILT HYDRANT
	STORM ASBUILT LATERAL TERMINATION
	SANITARY ASBUILT LATERAL TERMINATION
	WATER ASBUILT LATERAL TERMINATION

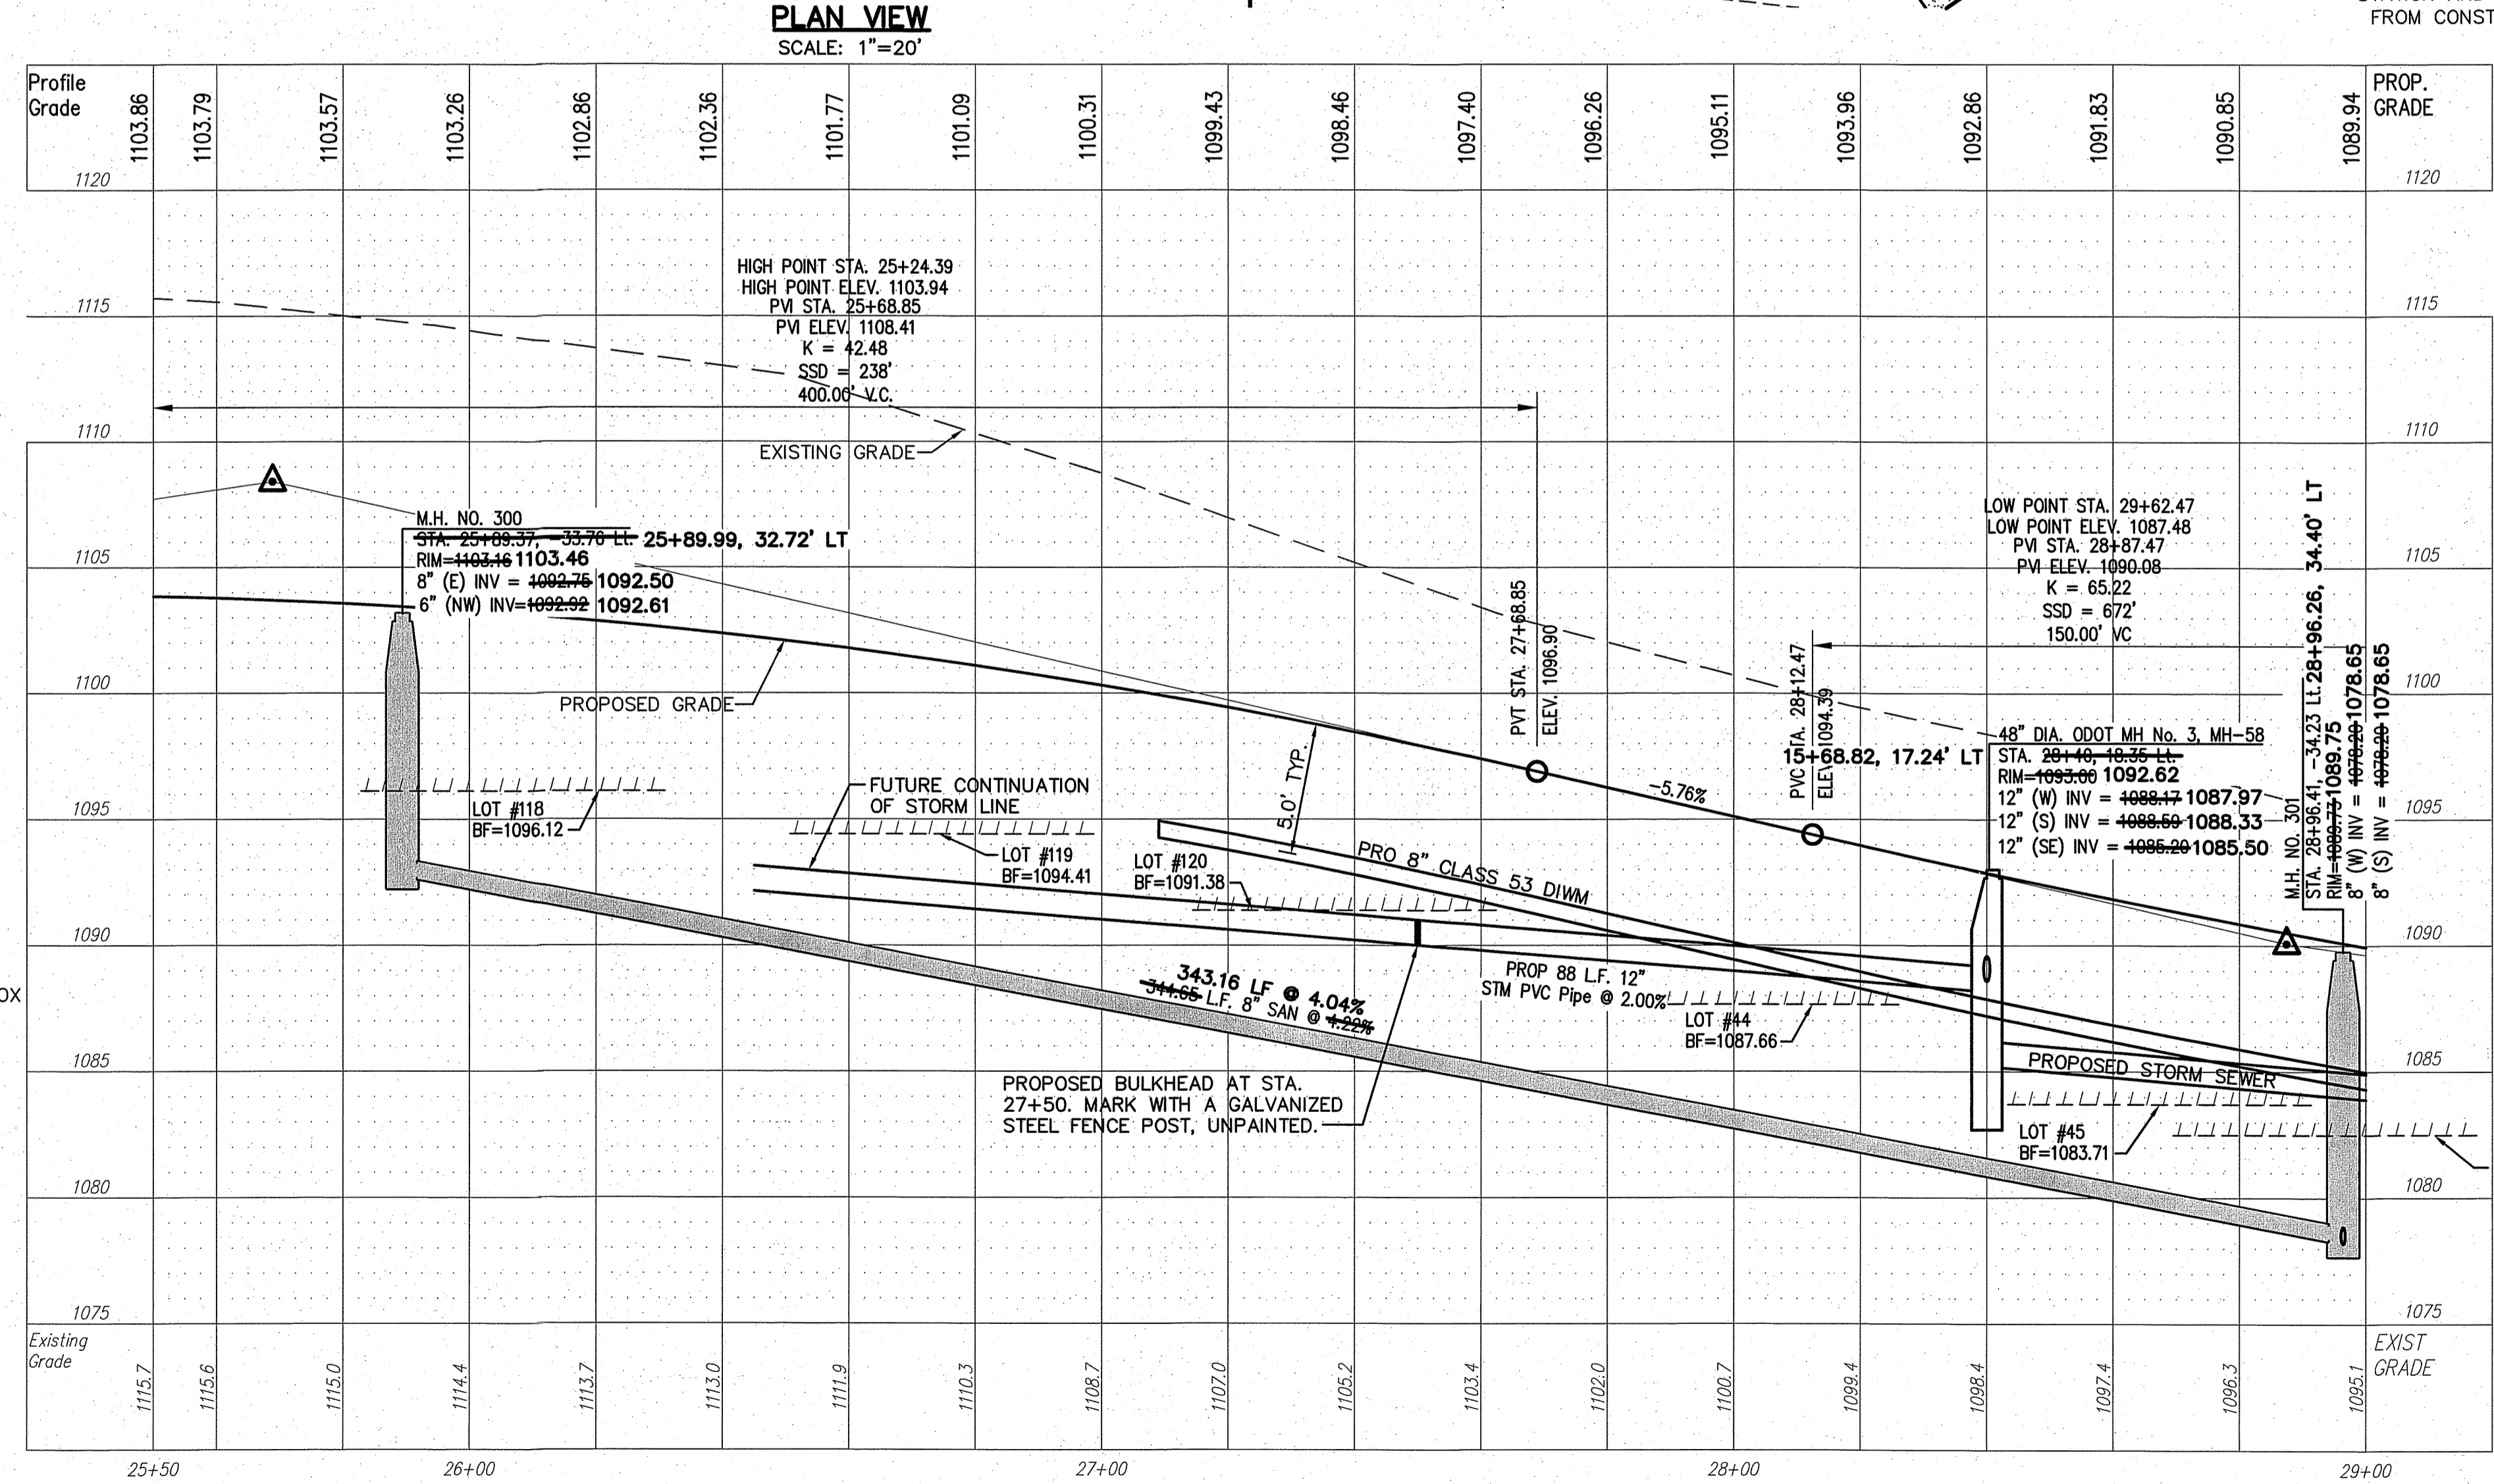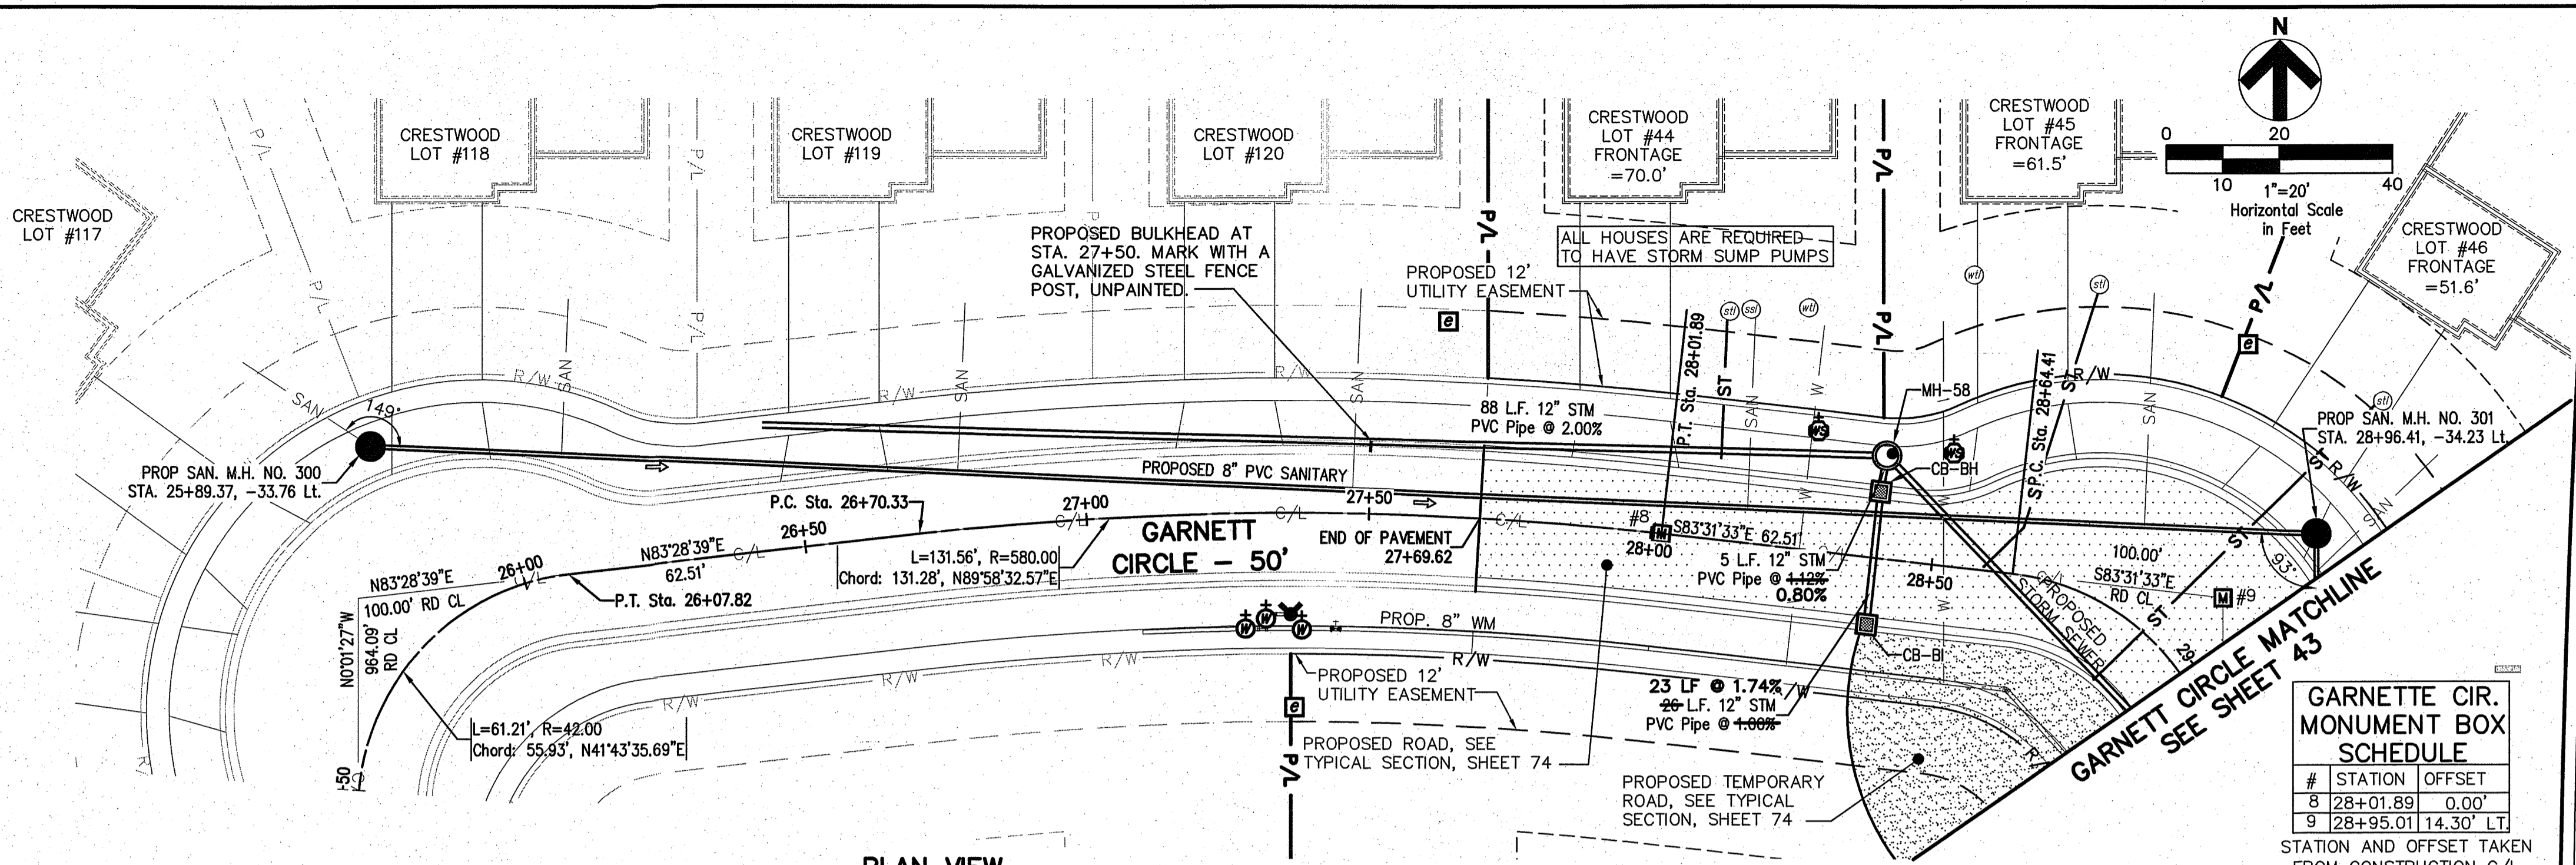

**GARNETT CIR. MONUMENT BOX SCHEDULE**

#	STATION	OFFSET
8	28+01.89	0.00'
9	28+95.01	14.30' LT

STATION AND OFFSET TAKEN FROM CONSTRUCTION C/L

REV.	DATE	DESCRIPTION
12/8/14		BRIDGE PLAN REVISIONS

THE PRESERVE AT MILLER'S FARM  
 SE CORNER OF SR 18 AND MEDINA LINE RD  
 COPLEY, OHIO 44321

**PLAN AND PROFILE**  
 GARNETT CIRCLE

**ISSUED FOR:**

PERMIT	06-02-14
BID	06-02-14
CONSTRUCTION	09-16-14
AS-BUILT	02-26-15

**PROJECT MANAGER** MAL    **DESIGNER** KB

**JOB NO.**  
 2013258.00

**42/81**