

**LEGEND**  
 SEE GENERAL LEGEND, SHEET 4

	PROPOSED ROLLED CURB AND GUTTER
	PROPOSED WALK
	PROPOSED WALK BY OTHERS
	PROPOSED WATER LATERAL
	PROPOSED SANITARY LATERAL
	PROPOSED STORM LATERAL
	PROPOSED WATER MAIN
	PROPOSED SANITARY MAIN
	PROPOSED STORM MAIN
	PROPOSED C/L OF CONSTRUCTION
	PROPOSED C/L OF RIGHT OF WAY
	PROPOSED MONUMENT BOX
	PROPOSED BOTTOM OF FOOTER ELEVATION
	PROPOSED ASPHALT PAVEMENT
	PROPOSED WATER EASEMENT
	PROPOSED DRAINAGE ACCESS EASEMENT
	PROPOSED SANITARY ACCESS EASEMENT

**CONCORD DR. MONUMENT BOX SCHEDULE**


#	STATION	OFFSET
23	150+00.00	0.00'
24	150+46.34	0.00'
25	150+86.39	0.00'

STATION AND OFFSET TAKEN FROM CONSTRUCTION C/L

**PROPOSED STRUCTURE TABLE**

Structure Name	Structure Details
CB-O	ODOT CB No. 3 STA. 151+75.11, 13.00' LT RIM = 1066.32 1065.44 12" PVC INV (SW) = 1061.05 1061.05 12" PVC INV (NE) = 1061.05 1061.05
CB-P	ODOT CB No. 3 STA. 151+75.11, 15.00' RT RIM = 1066.32 1065.30 11.86' RT 12" PVC INV (NE) = 1061.05 1061.55
CB-Q	ODOT CB No. 3 STA. 150+30.03, 74.20' LT RIM = 1066.42 1066.47 33.75' LT 12" PVC INV (SW) = 1062.77 1062.94
CB-R	ODOT CB No. 3 STA. 150+29.30, 34.26' RT RIM = 1066.16 1066.54 12" PVC INV (NE) = 1062.66 1063.01

**NOTE:**  
 ANY SERVICE LATERAL CROSSING WATER MAIN SHALL MAINTAIN 18" MINIMUM CLEARANCE.  
 ALL WATER MAIN PIPE JOINTS WITHIN AREAS OF FILL MUST BE RESTRAINED.

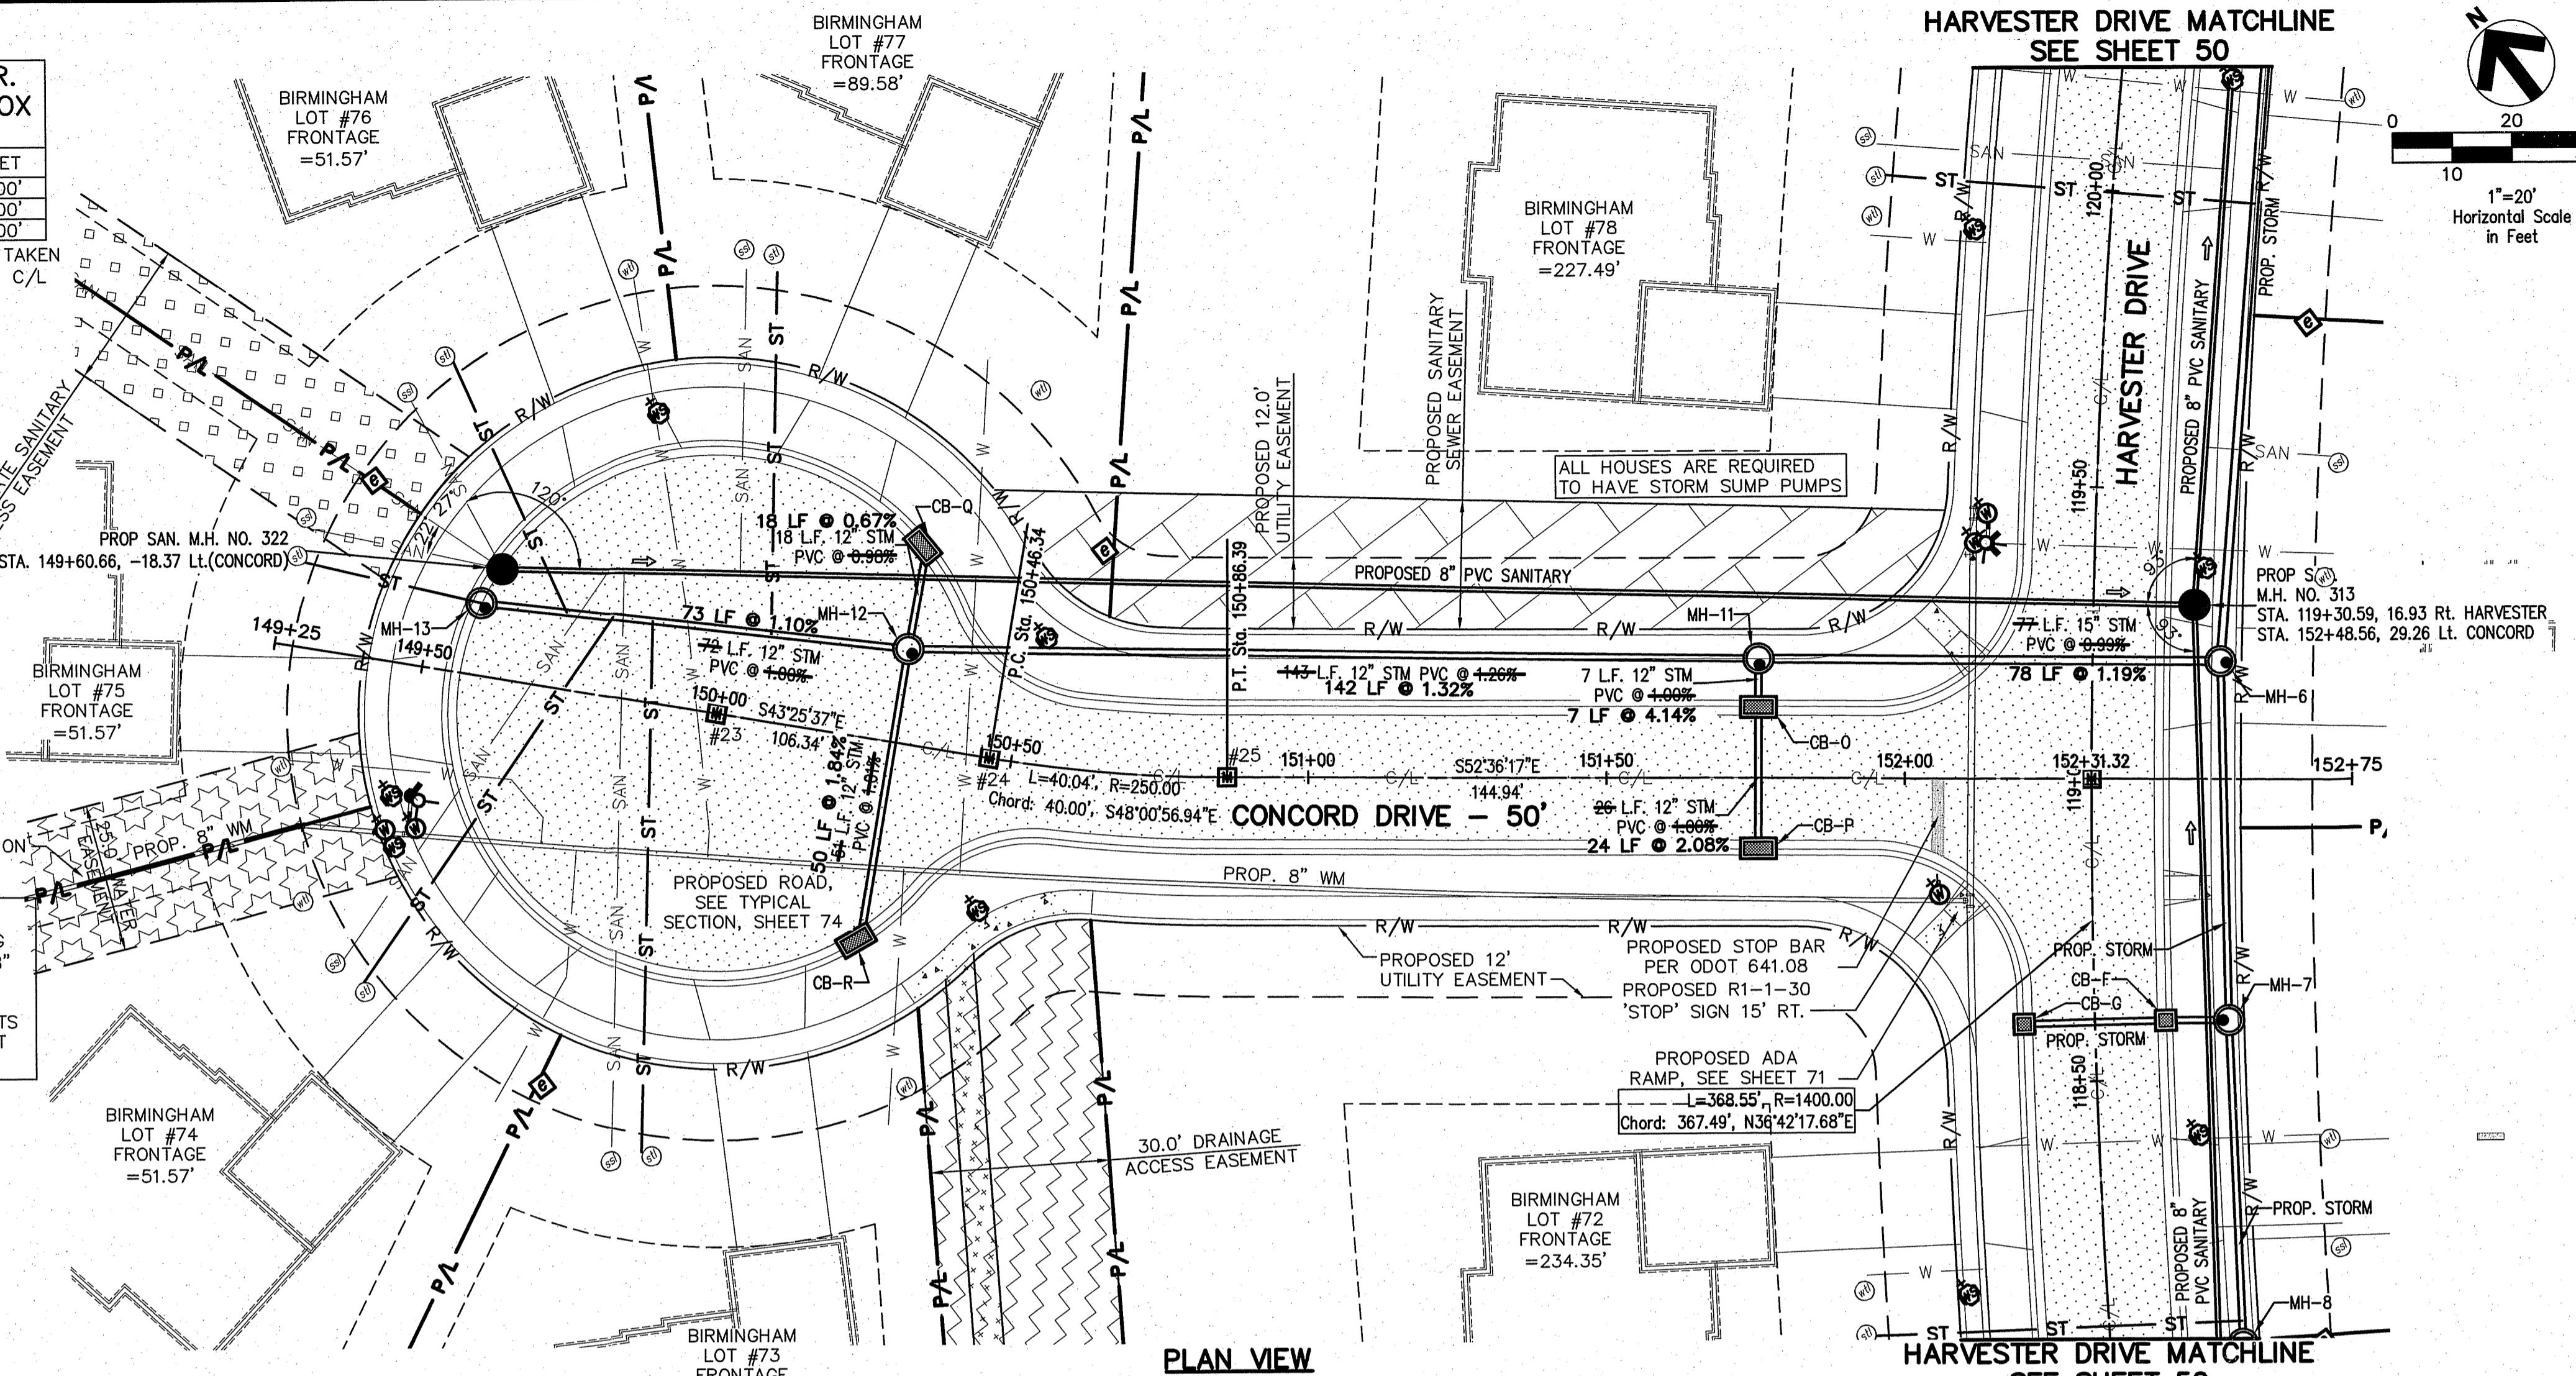

**CONCORD DRIVE WATER MAIN FITTING SCHEDULE**

ITEM	STATION	OFFSET
8" LINE VALVE	149+68.49	28.63' RT.
6" HYD. ASSEMBLY, TYPE B	149+72.89	21.75' RT.
8" LINE VALVE	152+27.16	20.54' RT.


**AS-BUILT LEGEND**

	DESIGNED WATER VALVE
	DESIGNED HYDRANT
	ASBUILT ELECTRIC PULLBOX
	ASBUILT WATER VALVE
	ASBUILT HYDRANT
	STORM ASBUILT LATERAL TERMINATION
	SANITARY ASBUILT LATERAL TERMINATION
	WATER ASBUILT LATERAL TERMINATION

**STORM SEWER**  
 REFER TO GENERAL NOTES SHEET 5 FOR GENERAL NOTES.  
 ALL RCP PIPE SHALL BE CLASS 4 PER ODOT 706.02  
 ALL HDPE PIPE SHALL BE SMOOTH LINED PER ODOT 707.33  
 ALL PVC PIPE SHALL BE SDR 35 PER ODOT 707.45

**CONCORD DRIVE CONNECTION SCHEDULE**

UNIT	CONNECTION AT MAIN	RISER HEIGHT	LATERAL TERMINATION	LENGTH
77	SAN 150+00.00, 23.92' LT.	-	149+92.96, 74.67' LT.	51.25
ST	150+06.93, 14.70' LT.	-	149+98.13, 74.98' LT.	60.92
WAT	150+44.50, 19.92' RT.	-	150+35.33, 68.16' LT.	86.47
SAN	149+80.84, 21.21' LT.	-	149+34.36, 74.79' RT.	96.94
ST	149+86.95, 13.66' LT.	-	149+39.44, 75.00' RT.	89.53
WAT	150+35.19, 20.80' RT.	-	150+39.56, 63.72' RT.	43.14
ST	149+60.66, 18.37' LT.	-	149+40.07, 45.09' LT.	33.74
WAT	150+02.36, 24.02' RT.	-	149+46.33, 52.39' LT.	47.37
SAN	149+78.23, 20.84' LT.	-	149+74.38, 70.49' LT.	98.69
ST	149+80.24, 13.31' LT.	-	149+44.90, 50.88' RT.	79.09
WAT	149+80.24, 13.31' LT.	-	149+48.73, 54.50' RT.	74.95
ST	149+80.48, 23.36' LT.	-	149+75.90, 70.31' RT.	45.50
SAN	149+60.66, 18.37' LT.	-	149+27.69, 9.92' LT.	33.04
ST	149+58.15, 12.17' LT.	-	149+26.38, 14.50' LT.	31.81
WAT	149+74.44, 26.11' RT.	-	149+27.53, 19.30' RT.	53.10
SAN	149+60.66, 18.37' LT.	-	-	397.00

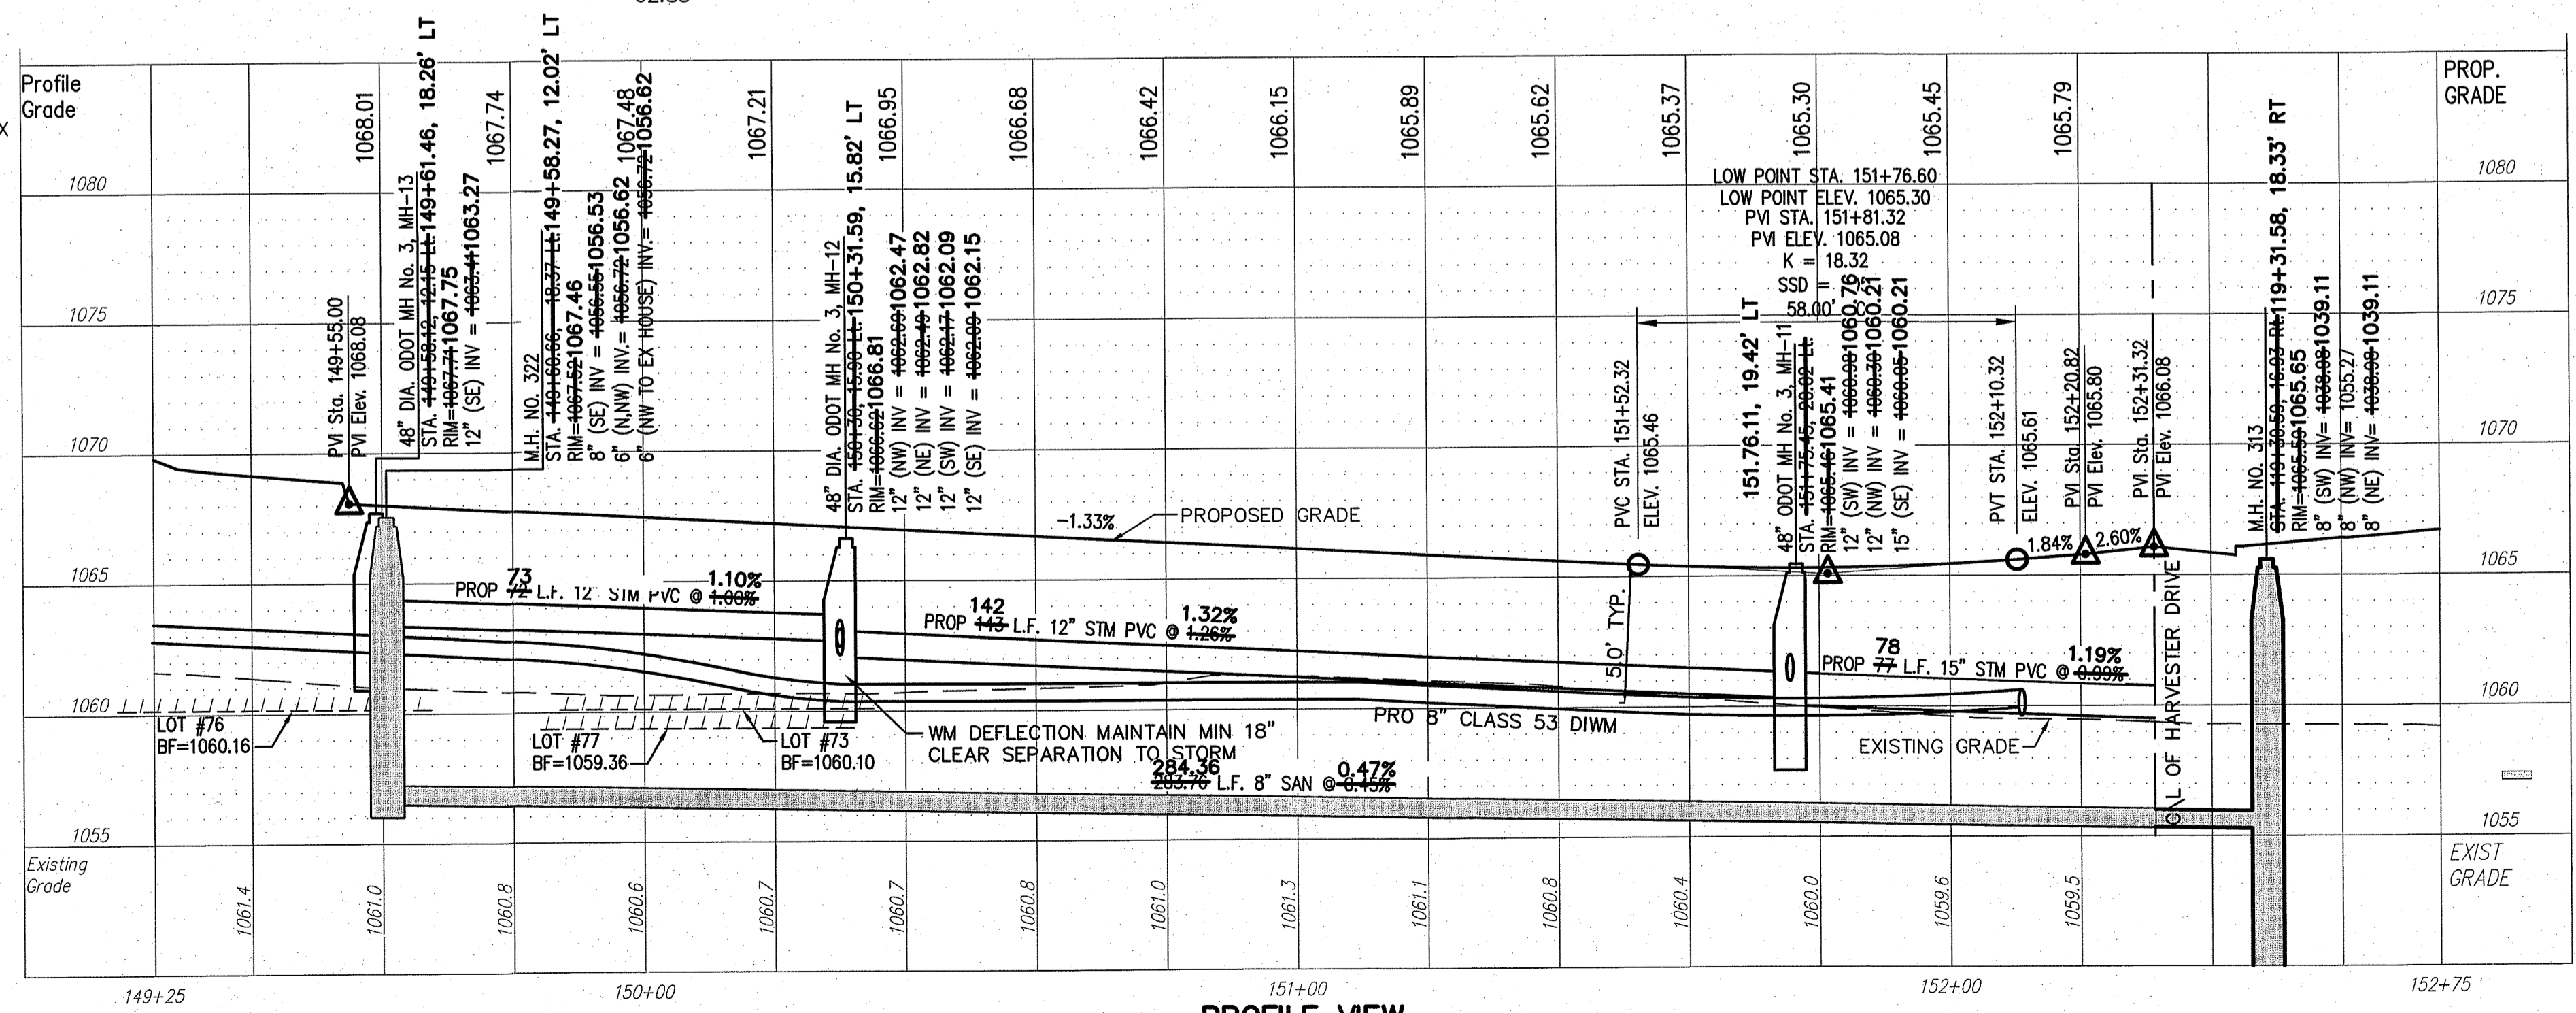

**PROFILE VIEW**  
 HORIZONTAL SCALE: 1"=20'  
 VERTICAL SCALE: 1"=5'

REVISIONS

REV.	DATE	DESCRIPTION
1	12/19/14	BRIDGE PLAN REVISIONS

**THE PRESERVE AT MILLER'S FARM**  
 SE CORNER OF SR 18 AND MEDINA LINE RD  
 COPLEY, OHIO 44321

**PLAN AND PROFILE**  
**CONCORD DRIVE**

ISSUED FOR:

PERMIT	06-02-14
BID	06-02-14
CONSTRUCTION	09-16-14
AS-BUILT	02-26-15

PROJECT MANAGER: MAL  
 DESIGNER: KB

JOB NO.  
**2013258.00**

**52/81**