

PLAN VIEW
SCALE: 1"=20'

LEGEND
SEE GENERAL LEGEND, SHEET 4
 PROPOSED DRAINAGE ACCESS EASEMENT

- AS-BUILT LEGEND**
- DESIGNED WATER VALVE
 - DESIGNED HYDRANT
 - ASBUILT ELECTRIC PULLBOX
 - ASBUILT WATER VALVE
 - ASBUILT HYDRANT
 - STORM ASBUILT LATERAL TERMINATION
 - SANITARY ASBUILT LATERAL TERMINATION
 - WATER ASBUILT LATERAL TERMINATION

NOTE:
 ANY SERVICE LATERAL CROSSING WATER MAIN SHALL MAINTAIN 18" MINIMUM CLEARANCE.
 ALL WATER MAIN PIPE JOINTS WITHIN AREAS OF FILL MUST BE RESTRAINED.

SANITARY CONNECTION SCHEDULE


UNIT	CONNECTION	RISER HEIGHT	HOUSE STUB	LENGTH
163	111+74.82, 7.07' LT 5"		111+74.49, 63.13' LT	56.07'
134	112+41.43, 6.20' LT 6"		112+41.56, 14.08' RT	20.87'
165	113+36.31, 8.01' LT 5"		113+36.18, 64.57' LT	56.56'
164	112+55.69, 7.54' LT 8"		112+55.35, 66.12' LT	56.62'

STORM SEWER
 REFER TO GENERAL NOTES SHEET 5 FOR GENERAL NOTES.
 ALL RCP PIPE SHALL BE CLASS 4 PER ODOT 706.02
 ALL HDPE PIPE SHALL BE SMOOTH LINED PER ODOT 707.33
 ALL PVC PIPE SHALL BE SDR 35 PER ODOT 707.45

Underground Utilities

2 Working Days Before You Dig
 Call 800-362-2764 (Toll Free)
 Ohio Utilities Protection Service
 Non-members Must Be Called Directly
 Call 800-925-0988 (Toll Free)
 Oil & Gas Producers Utility Protection Service

NOTE:
 ALL OIL AND GAS WELL REMOVALS, PLUGGING/CAPPING, AND ABANDONMENTS SHALL BE IN ACCORDANCE WITH ALL ASSOCIATED REGULATIONS FOR SUCH REMOVALS, INCLUDING BUT NOT LIMITED TO, ODNR, LOCAL, STATE, AND FEDERAL.
 EXISTING HIGH PRESSURE GAS MAIN SHALL BE LOCATED AND PROTECTED PRIOR TO AND THROUGHOUT CONSTRUCTION.

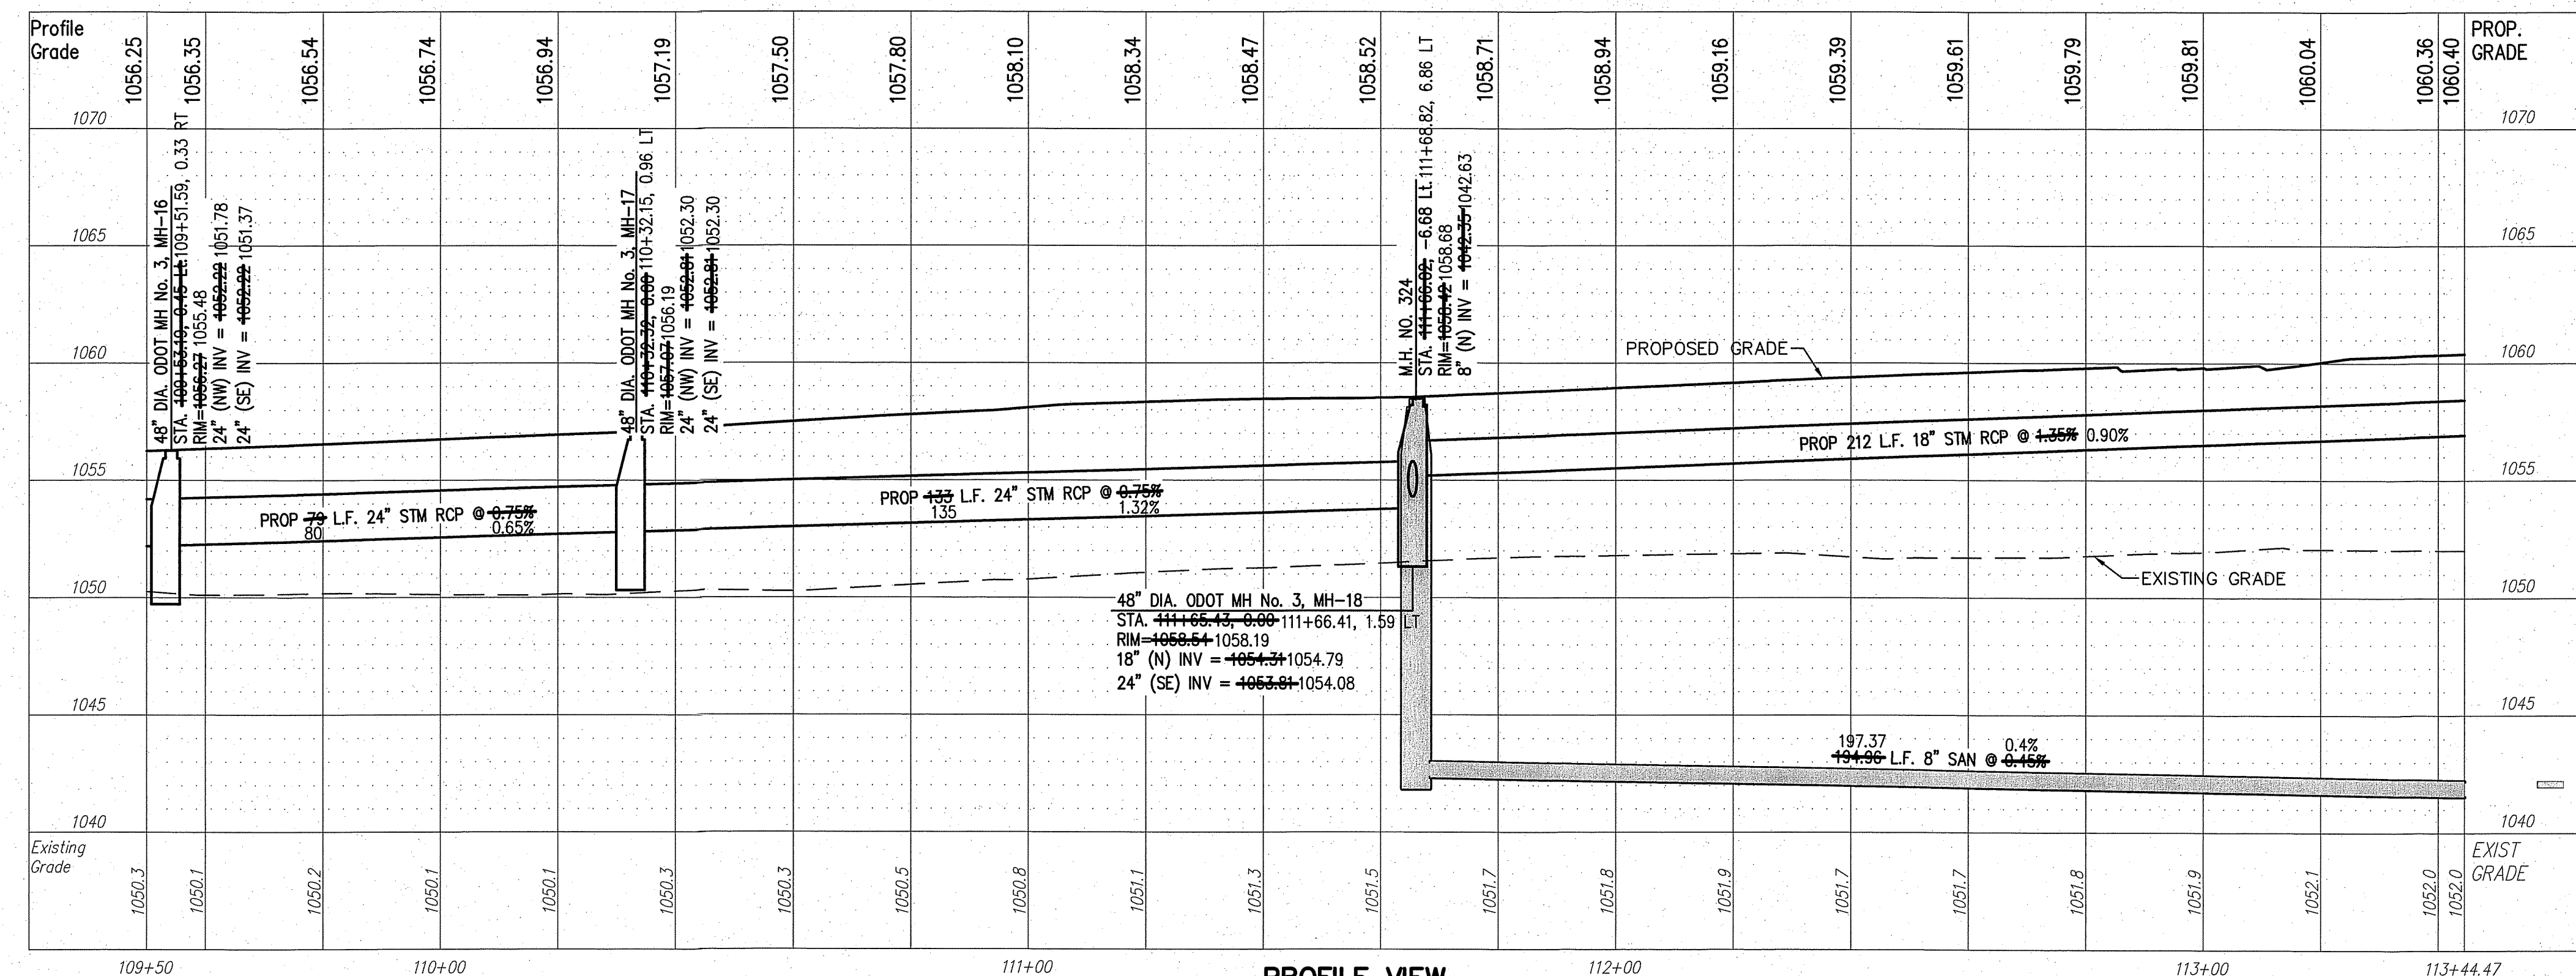

PROFILE VIEW
HORIZONTAL SCALE: 1"=20'
VERTICAL SCALE: 1"=5'

SEE SHEET 49 FOR CONTINUATION OF HARVESTER DRIVE

REV.	DATE	DESCRIPTION
12/8/14		BRIDGE PLAN REVISIONS

THE PRESERVE AT MILLER'S FARM
 SE CORNER OF SR 18 AND MEDINA LINE RD
 COPLEY, OHIO 44321

PLAN AND PROFILE
UTILITY

ISSUED FOR:

PERMIT	06-02-14
BID	06-02-14
CONSTRUCTION	09-16-14
AS-BUILT	02-26-15

PROJECT MANAGER	DESIGNER
MAL	KB

JOB NO.
2013258.00

56/81