

**GARNETT CIR. MONUMENT BOX SCHEDULE**

#	STATION	OFFSET
1	25+77.21	14.30 LT
2	26+70.33	0.00

STATION AND OFFSET TAKEN FROM CONSTRUCTION C/L

CONTROL POINT #2634  
 8" REBAR W/CAP "CONTROL"  
 Northing : 536240.951'  
 Easting : 2192397.111'  
 Elevation : 1127.17'  
 \*SEE SHEET 02 FOR LOCATION OF ALL BENCHMARKS

**STORM SEWER**  
 REFER TO GENERAL NOTES SHEET 04 FOR GENERAL NOTES.  
 ALL RCP PIPE SHALL BE CLASS 4 PER ODOT 706.02  
 ALL HDPE PIPE SHALL BE SMOOTH LINED PER ODOT 707.33  
 ALL PVC PIPE SHALL BE SDR 35 PER ODOT 707.45

**PROPOSED STRUCTURE TABLE**

Structure Name	Structure Details
CB-BJ	ODOT CB 3A STA. 26+44.13, -13.00 Lt. STA. 26+44.49, -12.22 Lt. RIM = 1102.26 12" PVC Pipe INV (N)=1098.26 4" CPP Pipe INV (NW)=1099.04

**AS-BUILT NOTE**  
 AS-BUILT RIM ELEVATIONS SHOWN WERE SHOT AT THE FLOW LINE OF THE BASIN.

**LEGEND**  
 SEE GENERAL LEGEND, SHEET 03

- PROPOSED ROLLED CURB AND GUTTER
- PROPOSED WALK
- PROPOSED WALK BY OTHERS
- PROPOSED WATER LATERAL
- PROPOSED SANITARY LATERAL
- PROPOSED STORM LATERAL
- PROPOSED WATER MAIN
- PROPOSED SANITARY MAIN
- PROPOSED STORM MAIN
- PROPOSED C/L OF CONSTRUCTION
- PROPOSED C/L OF RIGHT OF WAY
- PROPOSED MONUMENT BOX
- PROPOSED BOTTOM OF FOOTER ELEVATION
- PROPOSED ASPHALT PAVEMENT
- PROPOSED DRAINAGE ACCESS EASEMENT
- PHASE 1 DRAINAGE ACCESS EASEMENT

**GARNETT CIRCLE CONNECTION SCHEDULE**

UNIT	CONNECTION AT MAIN	LATERAL TERMINATION	LENGTH	INVERT*	RISER HT
116	SAN 25+31.75, 17.65' LT.	25+37.32, 48.60' LT.	31.45	1093.30	3'
	ST 25+51.30, 35.47' LT.	25+51.80, 53.99' LT.	18.55	1099.78	
	WAT 25+35.06, 22.24' RT.	25+47.24, 51.77' LT.	75.13		
117	SAN INSTALLED DURING PHASE 1				
	ST 25+90.58, 40.58' LT.	25+86.93, 58.57' LT.	19.66	1097.27	
	WAT 25+88.29, 26.29' RT.	25+79.14, 59.88' LT.	86.53		
118	SAN INSTALLED DURING PHASE 1				
	ST 26+06.17, 28.42' LT.	26+08.49, 50.02' LT.	21.92	1096.69	
	WAT 26+27.60, 20.89' RT.	26+27.33, 42.21' LT.	63.10		
119	SAN INSTALLED DURING PHASE 1				
	ST 26+74.36, 18.10' LT.	26+77.46, 40.00' LT.	22.14	1092.27	
	WAT 26+95.68, 21.09' RT.	26+94.87, 40.00' LT.	61.09		
120	SAN INSTALLED DURING PHASE 1				
	ST 27+42.34, 12.67' LT.	27+43.19, 40.00' LT.	27.34	1090.92	
	WAT 27+56.76, 20.02' RT.	27+57.22, 39.85' LT.	59.87		
121	SAN 25+06.64, 17.51' LT.	25+06.64, 40.00' RT.	57.50	1089.96	
	ST 25+00.64, 22.50' LT.	25+00.64, 40.00' RT.	62.50	1099.42	

\* INVERT AT THE LATERAL TERMINATION

**Underground Utilities**

2 Working Days Before You Dig  
 Call 800-362-2764 (Toll Free)  
 Ohio Utilities Protection Service

Non-members Must Be Called Directly  
 Call 800-925-0988 (Toll Free)  
 Oil & Gas Producers Utility Protection Service


**NOTE:**  
 ALL OIL AND GAS WELL REMOVALS, PLUGGING/CAPPING, AND ABANDONMENTS SHALL BE IN ACCORDANCE WITH ALL ASSOCIATED REGULATIONS FOR SUCH REMOVALS, INCLUDING BUT NOT LIMITED TO, ODNR, LOCAL, STATE, AND FEDERAL.  
 EXISTING HIGH PRESSURE GAS MAIN SHALL BE LOCATED AND PROTECTED PRIOR TO AND THROUGHOUT CONSTRUCTION.

**NOTE:**  
 ANY SANITARY SERVICE LATERAL CROSSING WATER MAIN SHALL MAINTAIN 18" MINIMUM CLEARANCE.  
 ALL WATER MAIN PIPE JOINTS WITHIN AREAS OF FILL MUST BE RESTRAINED.


**GARNETT CIRCLE WATER MAIN FITTING SCHEDULE**

ITEM	STATION	OFFSET
22.5" BEND	25+41.53	22.62' RT.
45" BEND	26+03.37	21.39' RT.
TIE INTO EXISTING WATERMAIN	27+22.71	20.50' RT.

GARNETT CIRCLE MATCHLINE SEE SHEET 15

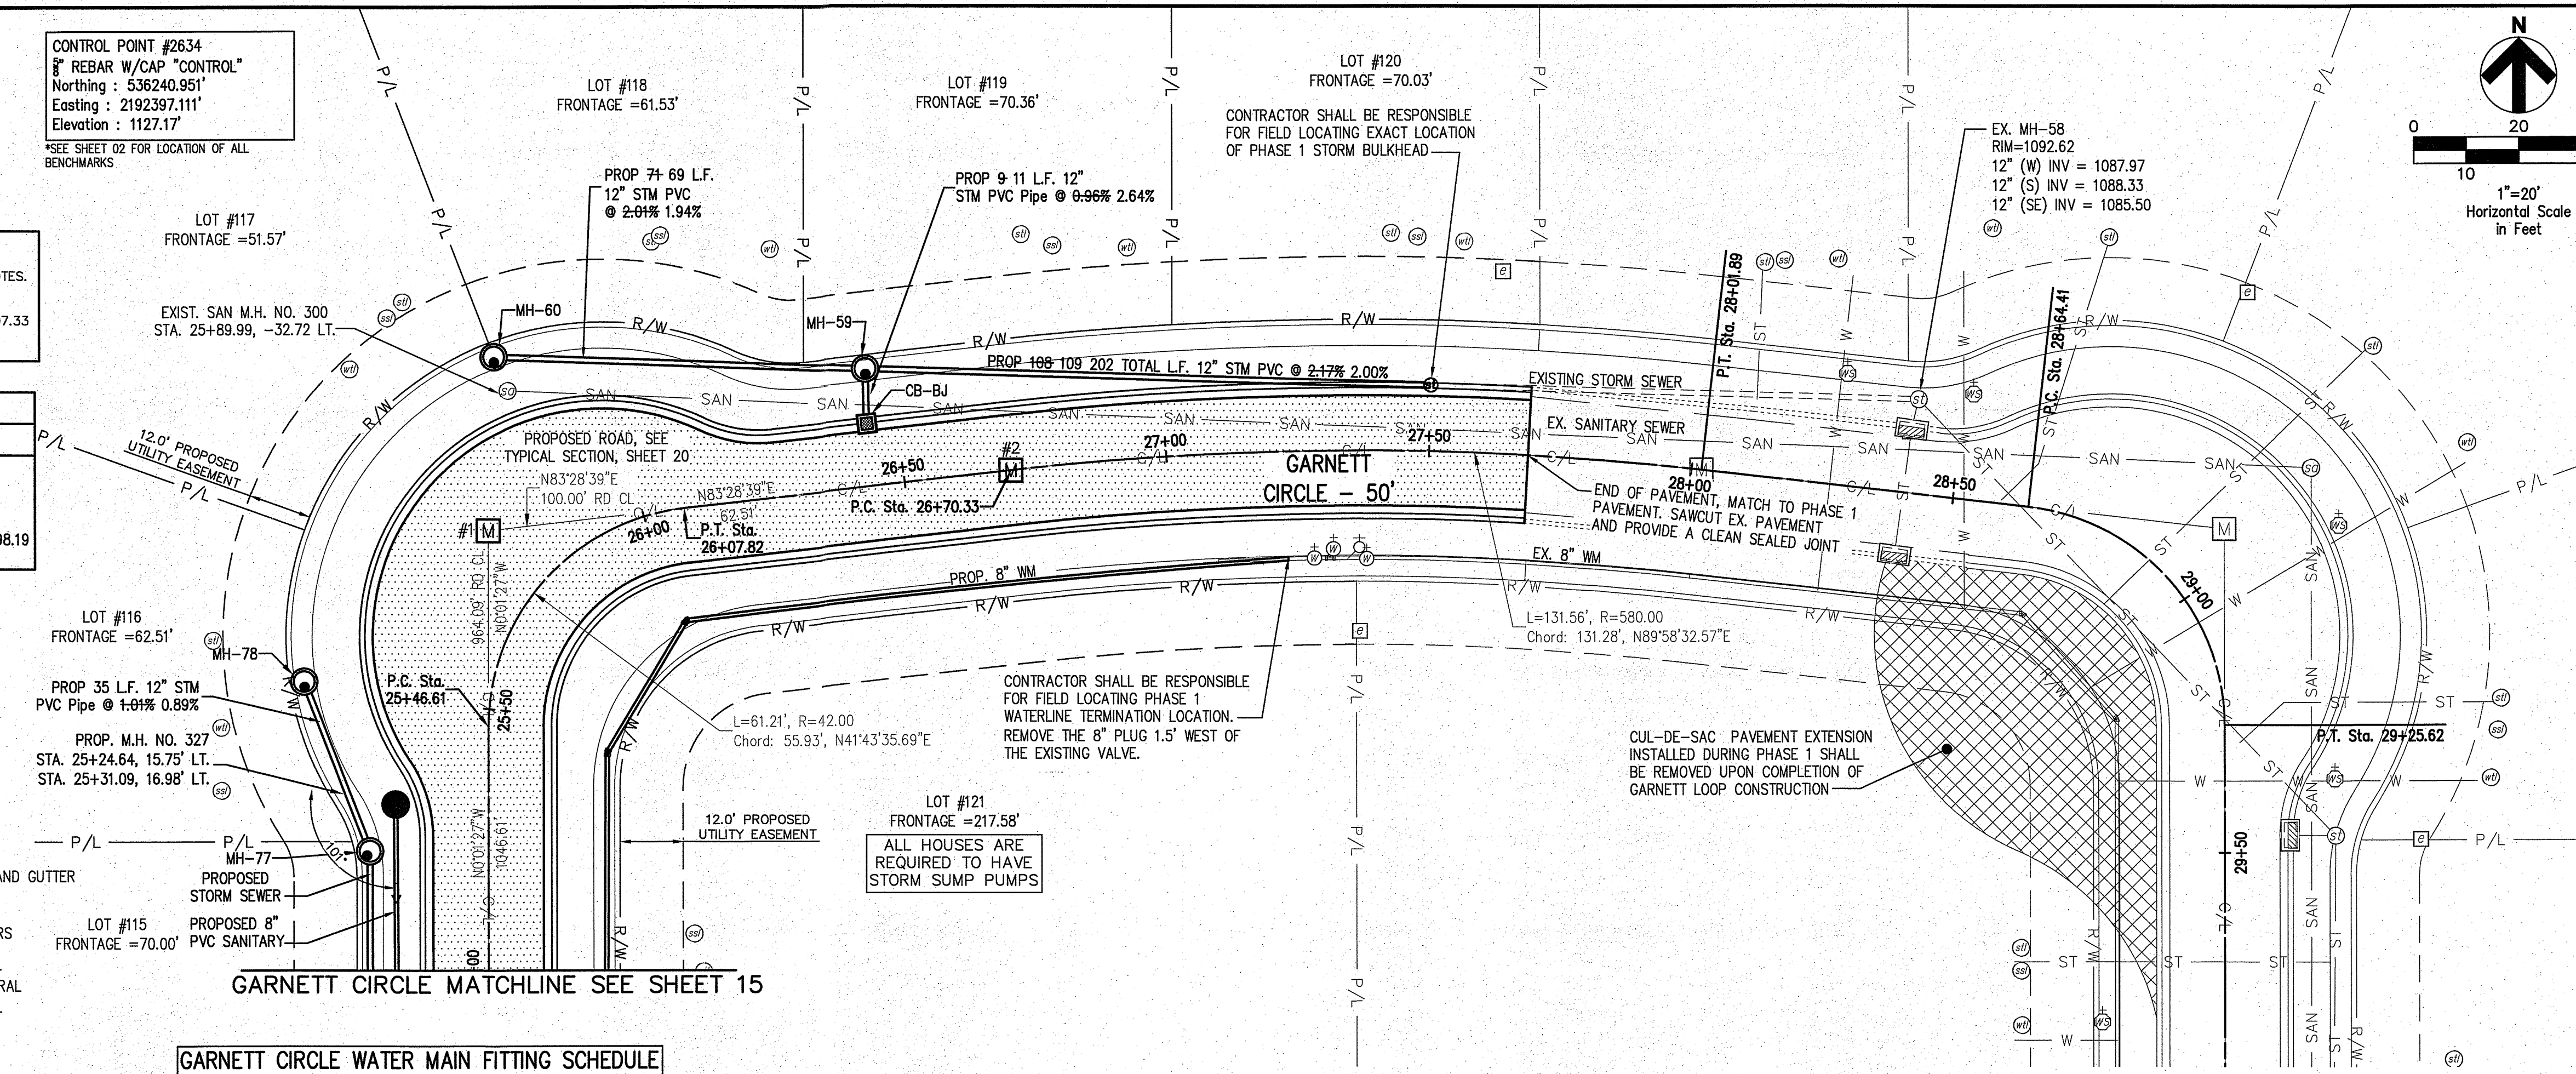

PLAN VIEW  
 SCALE: 1"=20'

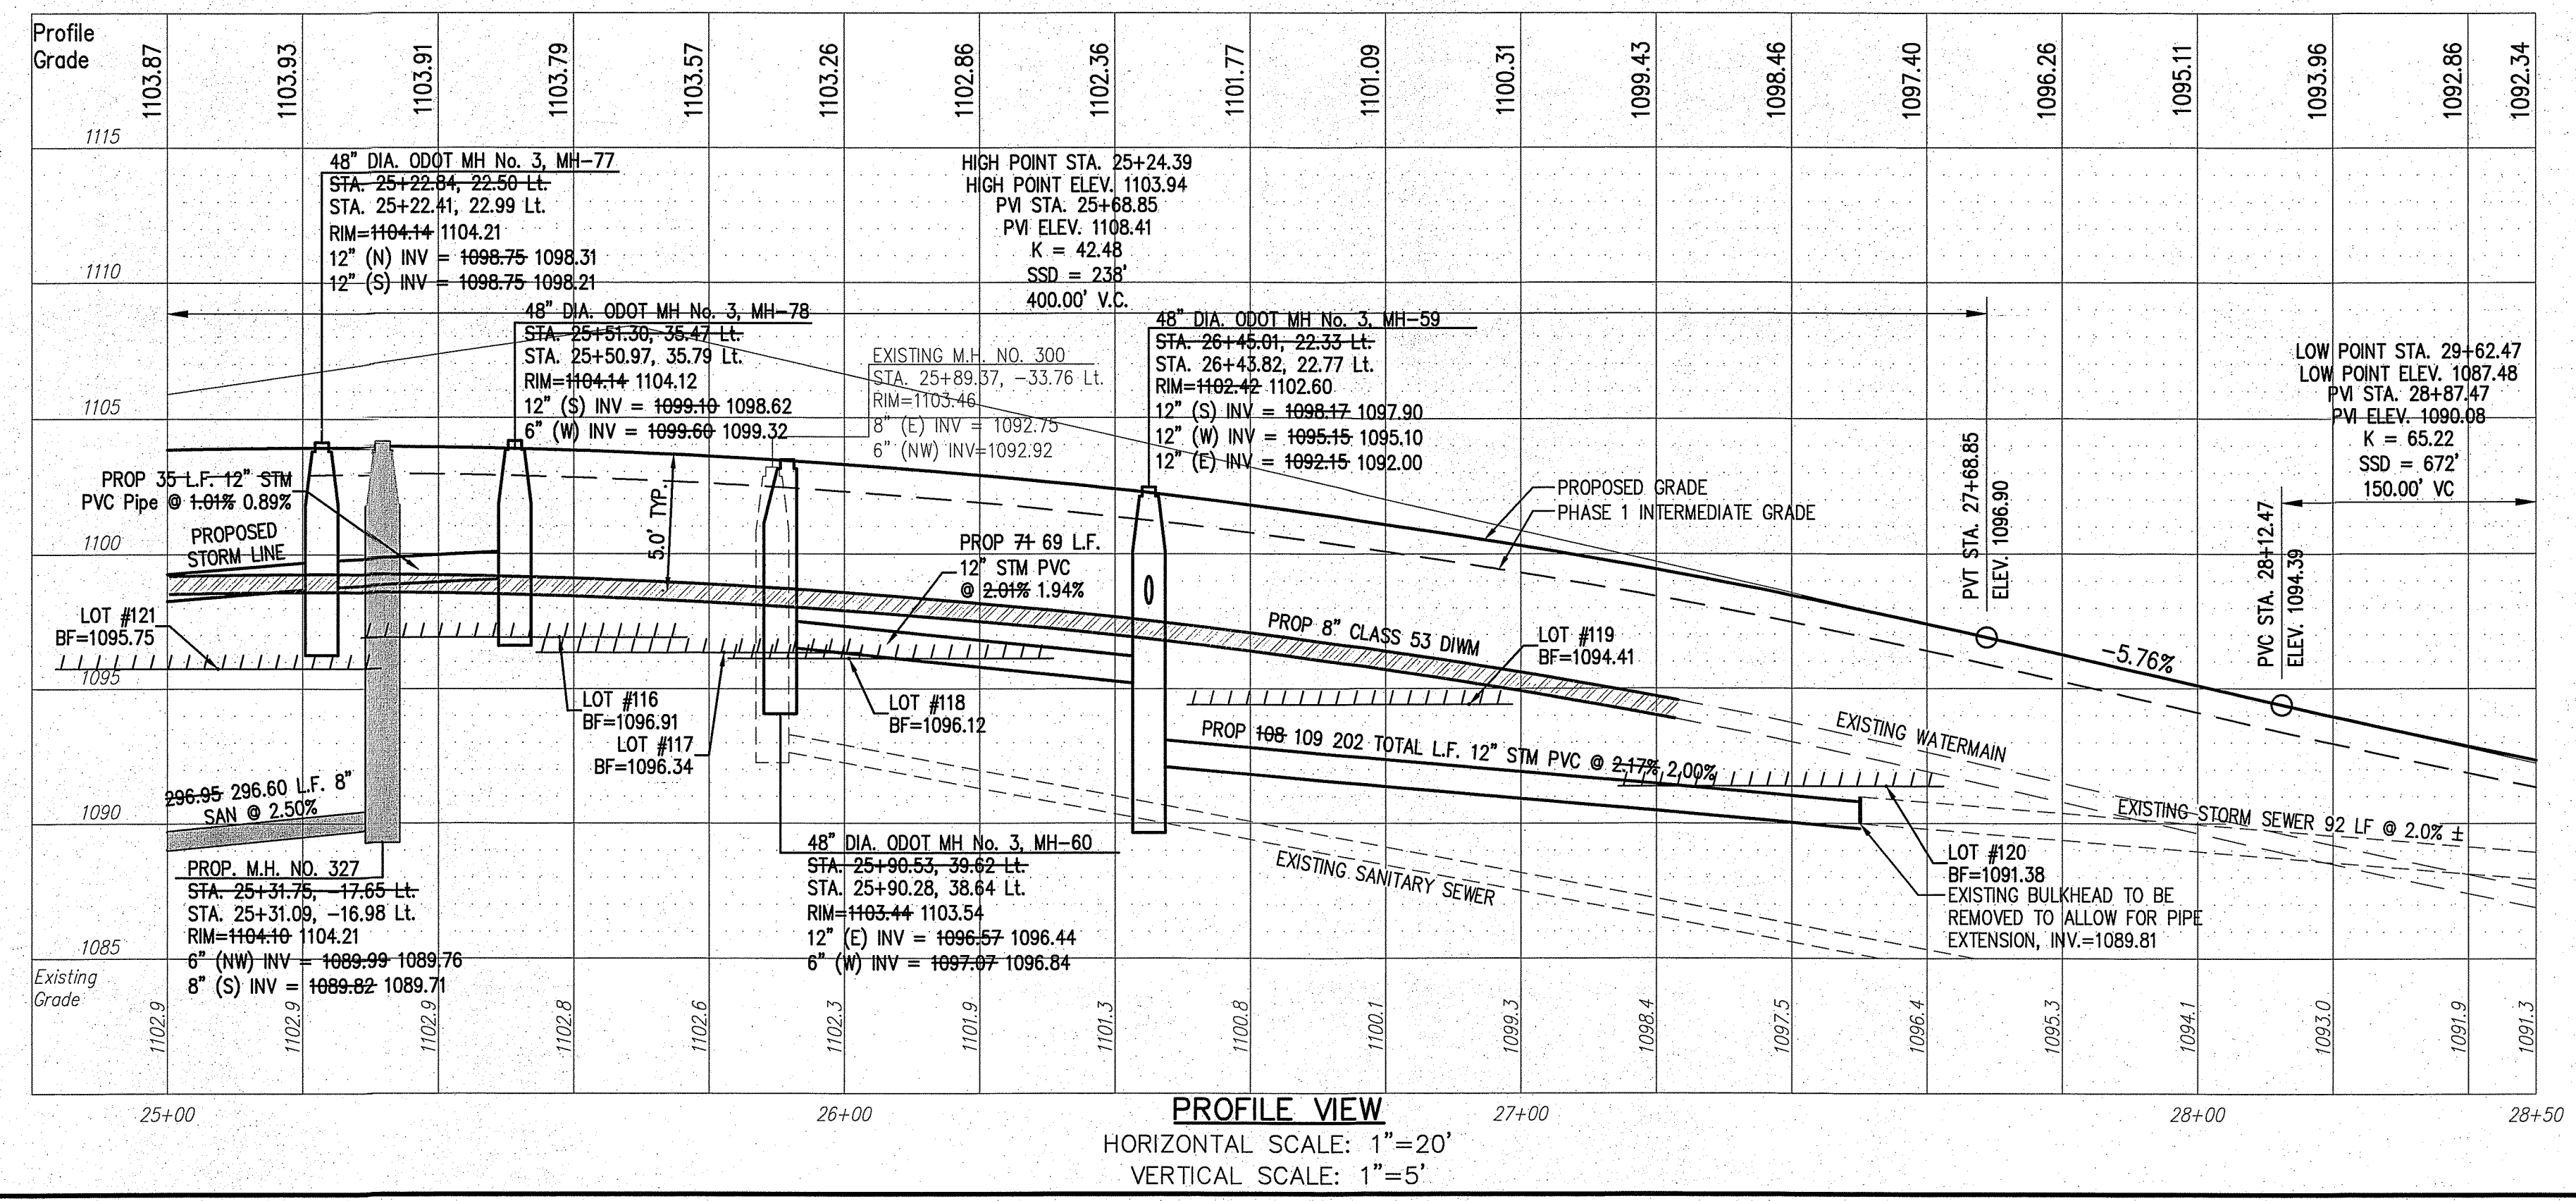

PROFILE VIEW  
 HORIZONTAL SCALE: 1"=20'  
 VERTICAL SCALE: 1"=5'

REV.	DATE	DESCRIPTION
01	07/17/15	REVISED PER COUNTY COMMENTS
	07/30/15	DOES REVISED COMMENTS
	8/20/15	REVISED PER COUNTY COMMENTS

THE PRESERVE AT MILLER'S FARM  
 PHASE 2  
 SE CORNER OF SR 18 AND MEDINA LINE RD  
 COPLEY, OHIO 44321

PLAN AND PROFILE  
 GARNETT CIRCLE

ISSUED FOR:

PERMIT	
BID	
CONSTRUCTION	
AS-BUILT	

PROJECT MANAGER: MAL  
 DESIGNER: ALF

JOB NO.  
**2013258.02**

**16/21**