

LEGEND

SEE GENERAL LEGEND, SHEET 04

[Symbol]	PROPOSED ROLLED CURB AND GUTTER
[Symbol]	PROPOSED WALK
[Symbol]	PROPOSED WALK BY OTHERS
[Symbol]	PROPOSED WATER LATERAL
[Symbol]	PROPOSED SANITARY LATERAL
[Symbol]	PROPOSED STORM LATERAL
[Symbol]	PROPOSED WATER MAIN
[Symbol]	PROPOSED SANITARY MAIN
[Symbol]	PROPOSED STORM MAIN
[Symbol]	PROPOSED C/L OF CONSTRUCTION
[Symbol]	PROPOSED C/L OF RIGHT OF WAY
[Symbol]	PROPOSED MONUMENT BOX
[Symbol]	PROPOSED BOTTOM OF FOOTER ELEVATION
[Symbol]	PROPOSED ASPHALT PAVEMENT
[Symbol]	EXISTING DRAINAGE ACCESS EASEMENT

BENCHMARK #2
 RAILROAD SPIKE IN POLE
 ELEVATION = 1101.95'
 SEE SHEET 02 FOR LOCATION
 OF ALL BENCHMARKS

AS-BUILT LEGEND

- [Symbol] AS-BUILT CATCH BASIN
- [Symbol] AS-BUILT STORM LATERAL TERMINATION
- [Symbol] AS-BUILT SANITARY MANHOLE
- [Symbol] AS-BUILT SANITARY LATERAL TERMINATION
- [Symbol] AS-BUILT HYDRANT
- [Symbol] AS-BUILT WATER LATERAL TERMINATION
- [Symbol] AS-BUILT WATER SERVICE VALVE

HARVESTER DRIVE WATER CONNECTION SCHEDULE

UNIT	CONNECTION AT MAIN	LATERAL TERMINATION	LENGTH
141	106+20.32, 20.70' LT.	106+20.32, 40.00' RT.	60.70'
142	105+49.83, 21.16' LT.	105+33.35, 40.00' RT.	63.48'
143	103+87.63, 17.57' LT.	103+80.42, 40.00' RT.	58.06'
144	103+16.08, 18.51' LT.	103+15.40, 40.00' RT.	58.51'
155	103+60.95, 17.11' LT.	103+60.40, 59.98' LT.	22.88'
156	104+80.79, 21.78' LT.	104+80.21, 39.70' LT.	17.92'

HARVESTER DRIVE STORM CONNECTION SCHEDULE

UNIT	CONNECTION AT MAIN	LATERAL TERMINATION	LENGTH	INVERT
142	105+43.80, 18.34' RT.	105+38.50, 40.00' RT.	22.46'	1054.27
143	103+87.17, 20.32' RT.	103+86.54, 40.00' RT.	19.69'	1055.08
144	103+20.63, 20.31' RT.	103+20.69, 40.00' RT.	19.69'	1055.58
155	103+66.06, 20.17' RT.	103+65.88, 40.00' RT.	60.16'	1055.24
156	104+84.85, 10.01' RT.	104+87.28, 49.77' LT.	49.77'	1054.55

HARVESTER DRIVE SANITARY CONNECTION SCHEDULE

UNIT	CONNECTION AT MAIN	LATERAL TERMINATION	LENGTH	INV. @ MAIN	INV. @ STUB
142	105+49.75, 14.54' RT.	105+42.97, 40.00' RT.	26.54'	1045.25	1045.51
143	103+92.11, 14.57' RT.	103+90.86, 40.00' RT.	25.47'	1046.90	1047.15
144	103+25.61, 14.29' RT.	103+25.89, 40.00' RT.	25.71'	1047.56	1047.82
155	103+71.04, 13.82' RT.	103+70.88, 40.00' RT.	53.83'	1047.11	1047.65
156	104+90.05, 3.51' RT.	104+93.24, 39.72' LT.	43.33'	1045.88	1046.31

HARVESTER DRIVE WATER MAIN FITTING SCHEDULE

ITEM	STATION	OFFSET
*6" HYD. ASSEMBLY, TYPE B	105+32.08	16.00' LT.
CONNECTION AT EX. MAIN	106+60.47	21.78' LT.

HARVESTER DRIVE MONUMENT BOX SCHEDULE

#	STATION	OFFSET
14	103+77.10	0.00
15	105+57.57	0.00

* STATION AND OFFSET TAKEN TO CENTER OF HYDRANT
 NOTE: PROVIDE CONCRETE THRUST BLOCKING ON ALL WATER LINE BENDS PER DETAIL SHEET 29

STATION AND OFFSET TAKEN FROM CONSTRUCTION C/L

PROPOSED STRUCTURE TABLE

Structure Name	Structure Details, SEE SHEET 25	
CB-DM	ODOT CB No. 3A STA. 104+06.63, 13.00 RT. RIM = 1057.65 1057.57 12" PVC Pipe INV (W)=1054.23 12" PVC Pipe INV (E)=1054.23 4" CPP (N) = 1054.36	1054.11 1054.06
CB-DN	ODOT CB No. 3A STA. 104+06.11, -13.15 LT. RIM = 1057.66 1057.55 12" PVC Pipe INV (E)=1054.36 4" CPP = 1054.36	1054.19 1054.19

NOTE:
 ANY SERVICE LATERAL CROSSING WATER MAIN SHALL MAINTAIN 18" MINIMUM CLEARANCE.

ALL WATER MAIN PIPE JOINTS WITHIN AREAS OF FILL MUST BE RESTRAINED.

STORM SEWER

REFER TO GENERAL NOTES SHEET 05 FOR CONSTRUCTION NOTES.
 ALL RCP PIPE SHALL BE CLASS 4 PER ODOT 706.02
 ALL HDPE PIPE SHALL BE SMOOTH LINED PER ODOT 707.33
 ALL PVC PIPE SHALL BE SDR 35 PER ODOT 707.45


Underground Utilities

2 Working Days Before You Dig
 Call 800-362-2764 (Toll Free)
 Ohio Utilities Protection Service
 Non-members Must Be Called Directly
 Call 800-925-0988 (Toll Free)
 Oil & Gas Producers Utility Protection Service

NOTE:


ALL OIL AND GAS WELL REMOVALS, PLUGGING/CAPPING, AND ABANDONMENTS SHALL BE IN ACCORDANCE WITH ALL ASSOCIATED REGULATIONS FOR SUCH REMOVALS, INCLUDING BUT NOT LIMITED TO, ODNR, LOCAL, STATE, AND FEDERAL.

EXISTING HIGH PRESSURE GAS MAIN SHALL BE LOCATED AND PROTECTED PRIOR TO AND THROUGHOUT CONSTRUCTION.

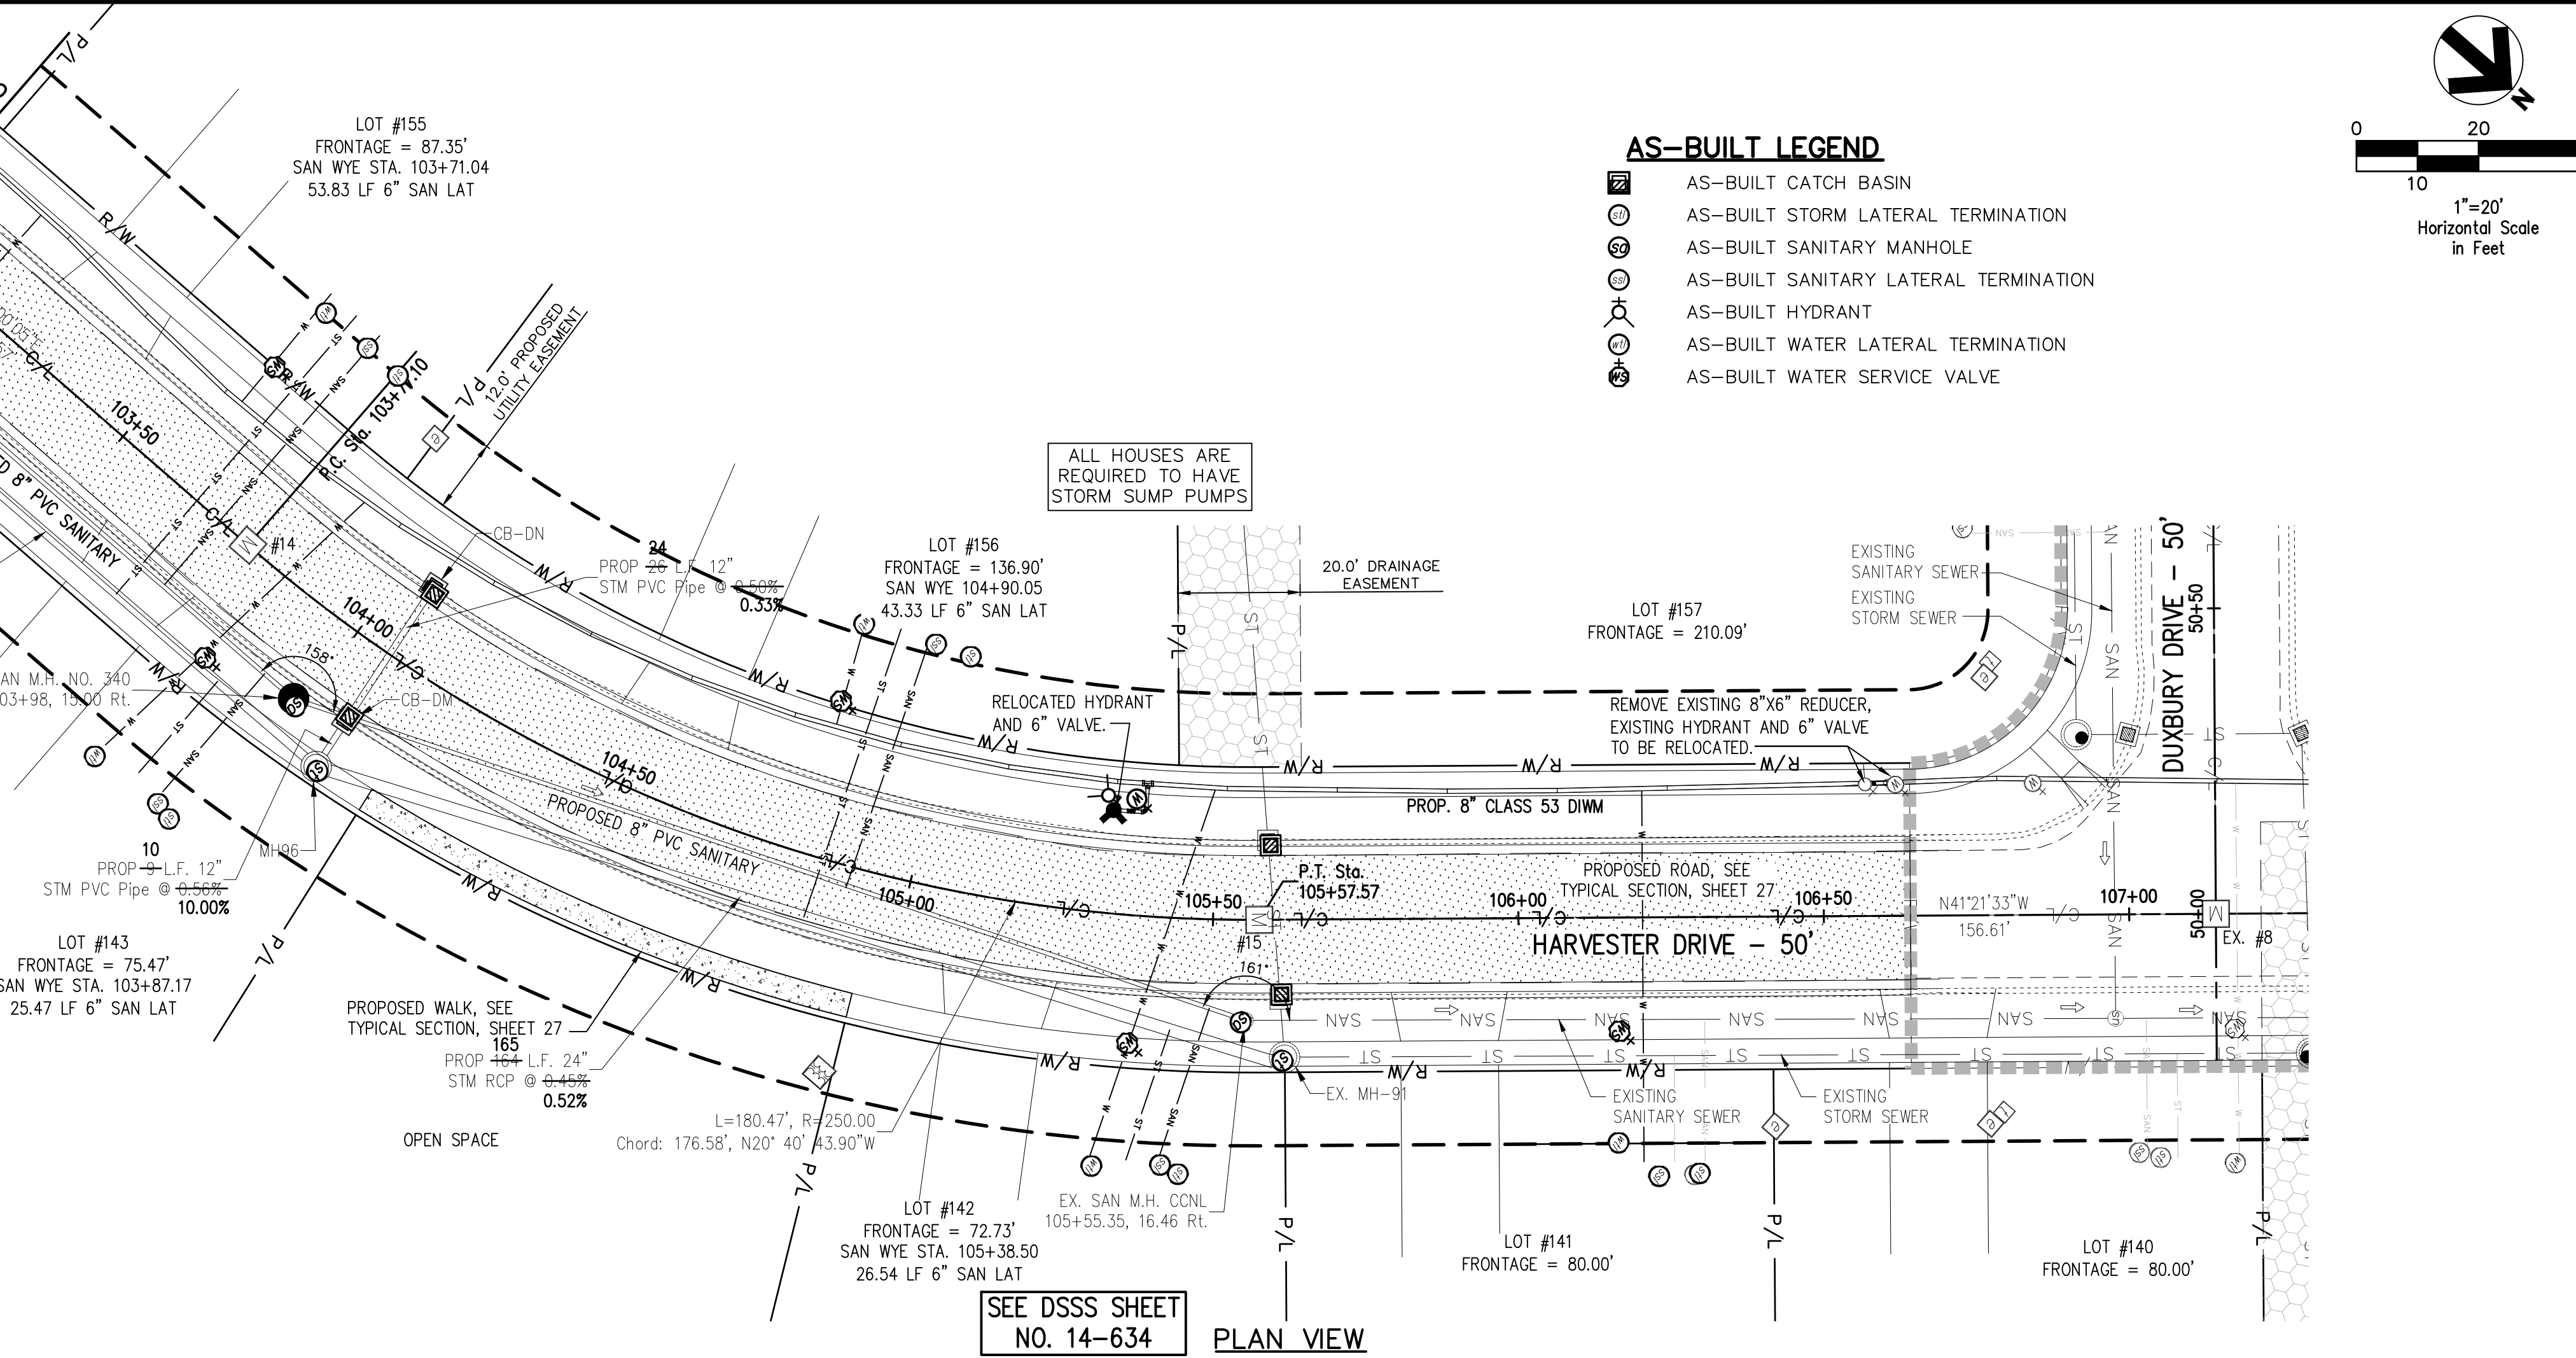

SEE DSSS SHEET NO. 14-634

PLAN VIEW
 SCALE: 1"=20'

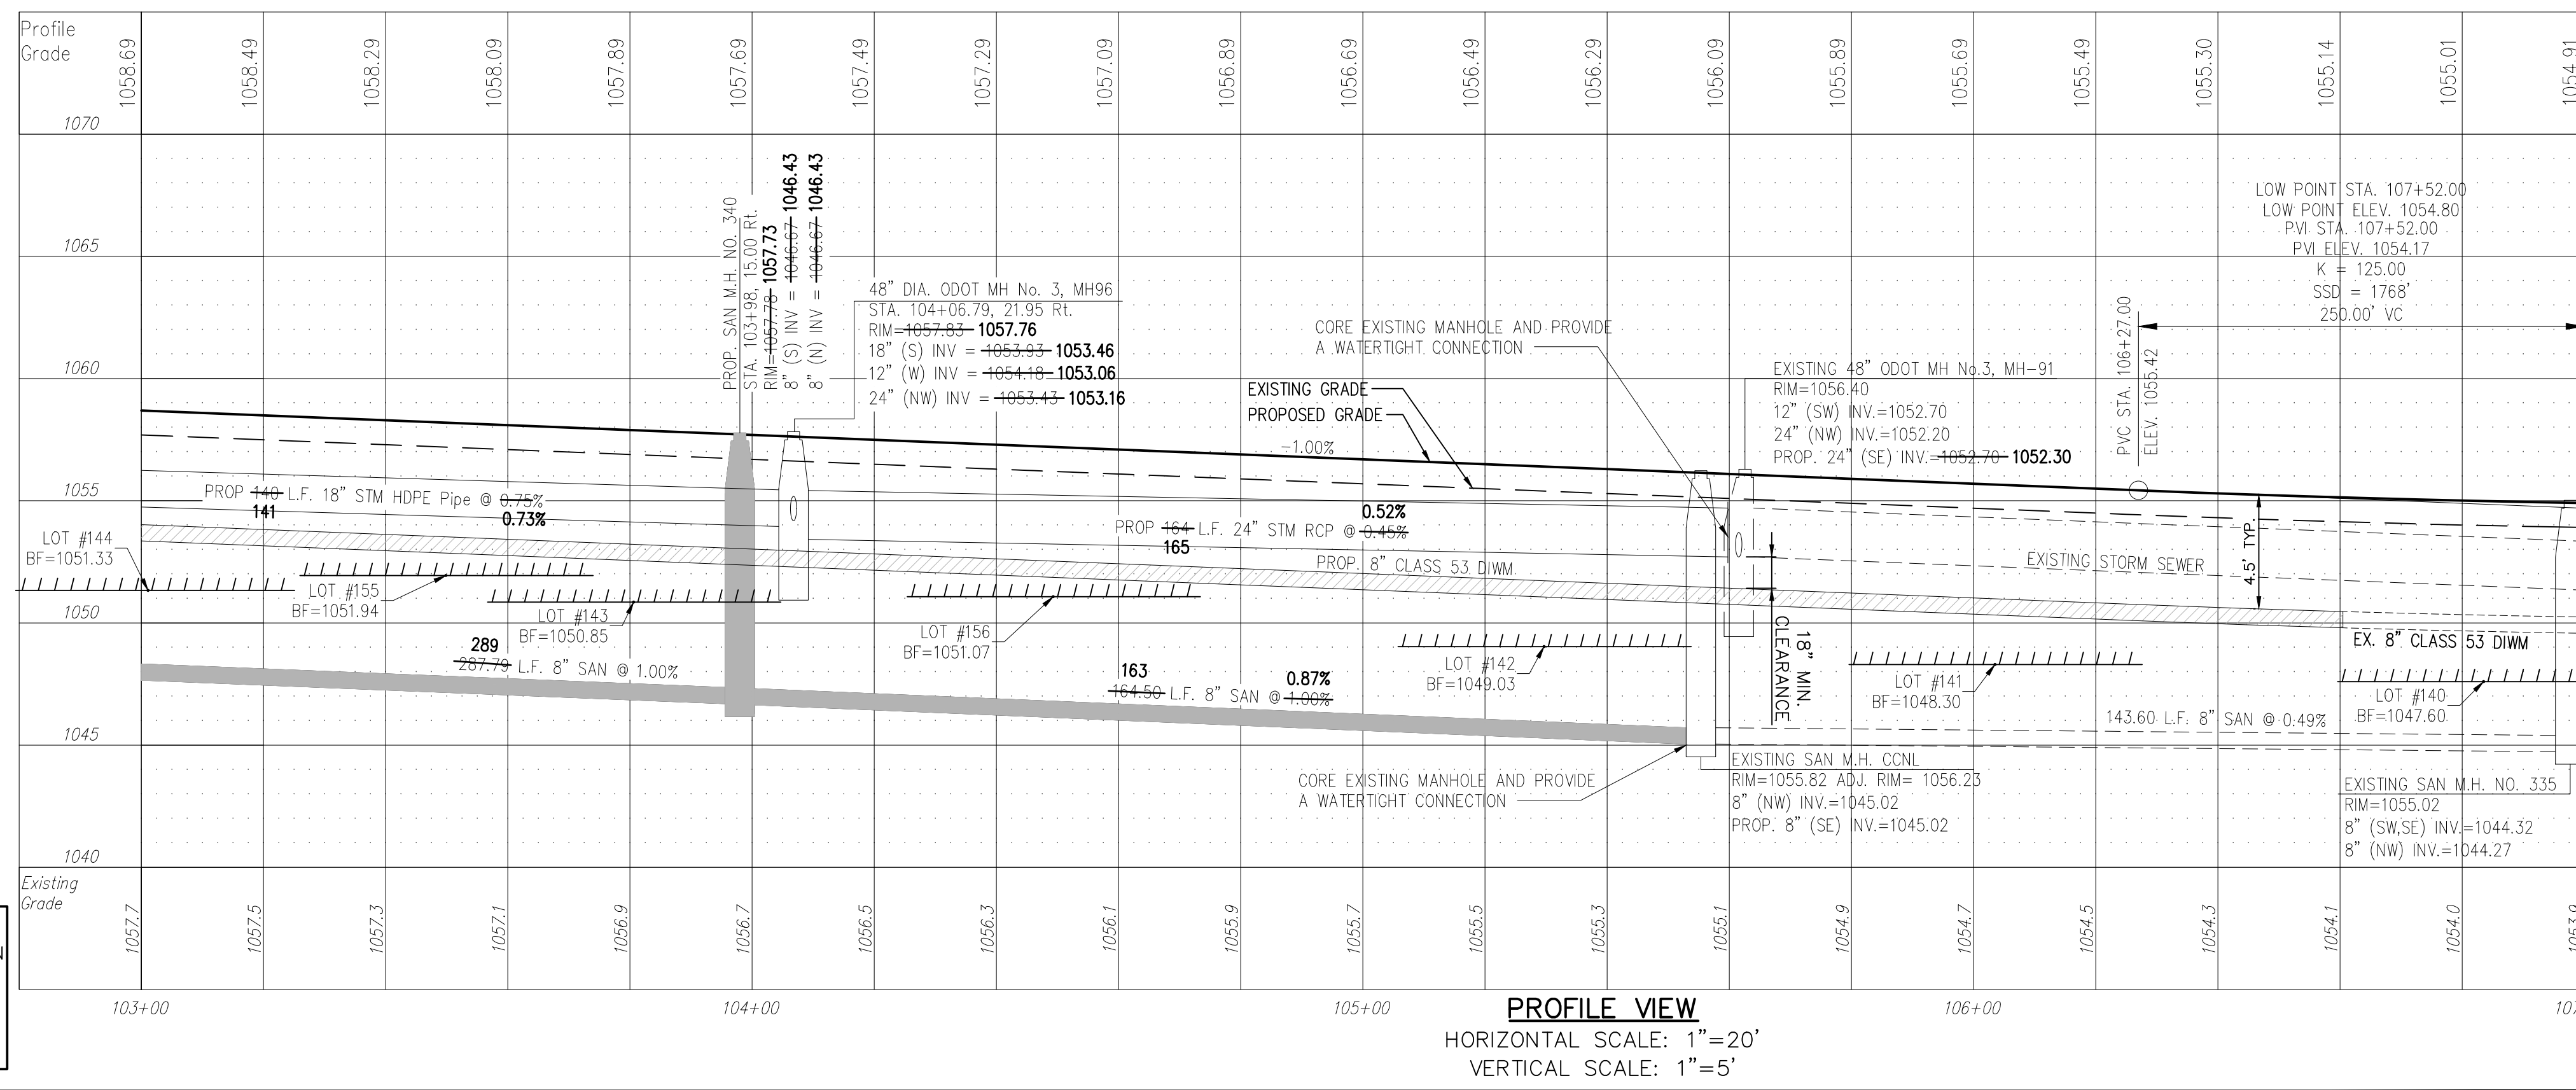

PROFILE VIEW
 HORIZONTAL SCALE: 1"=20'
 VERTICAL SCALE: 1"=5'

REV.	DATE	DESCRIPTION

THE PRESERVE AT MILLER'S FARM
 PHASE 4 AS-BUILTS
 SE CORNER OF SR 18 AND MEDINA LINE RD
 COPLEY, OHIO 44321

PLAN AND PROFILE
 HARVESTER DRIVE

ISSUED FOR:

PERMIT	
BID	
CONSTRUCTION	
AS-BUILT	01-19-2018

PROJECT MANAGER	DESIGNER
MAL	ALF

JOB NO.
2013258.04

19/29