

LEGEND

SEE GENERAL LEGEND, SHEET 04

	PROPOSED ROLLED CURB AND GUTTER
	PROPOSED WALK
	PROPOSED WALK BY OTHERS
	PROPOSED WATER LATERAL
	PROPOSED SANITARY LATERAL
	PROPOSED STORM LATERAL
	PROPOSED WATER MAIN
	PROPOSED SANITARY MAIN
	PROPOSED STORM MAIN
	PROPOSED C/L OF CONSTRUCTION
	PROPOSED C/L OF RIGHT OF WAY
	PROPOSED MONUMENT BOX
	PROPOSED BOTTOM OF FOOTER ELEVATION
	PROPOSED ASPHALT PAVEMENT
	EXISTING DRAINAGE ACCESS EASEMENT
	PROPOSED WATERLINE EASEMENT
	PROPOSED DRAINAGE ACCESS EASEMENT
	RIPARIAN SETBACK

HARVESTER DRIVE STORM CONNECTION SCHEDULE

UNIT	CONNECTION AT MAIN	LATERAL TERMINATION	LENGTH	INVERT
166	601+32.20, 0.00 RT.	601+32.20, 15.00 LT.	15.00'	1064.28
167	601+37.20, 0.00 RT.	601+37.20, 5.00 RT.	5.00'	1064.15

NOTE:
 ANY SERVICE LATERAL CROSSING WATER MAIN SHALL MAINTAIN 18" MINIMUM CLEARANCE.
 ALL WATER MAIN PIPE JOINTS WITHIN AREAS OF FILL MUST BE RESTRAINED.

Underground Utilities


2 Working Days Before You Dig
 Call 800-362-2764 (Toll Free)
 Ohio Utilities Protection Service

Non-members Must Be Called Directly
 Call 800-925-0988 (Toll Free)
 Oil & Gas Producers Utility Protection Service

STORM SEWER

REFER TO GENERAL NOTES SHEET 05 FOR CONSTRUCTION NOTES.
 ALL RCP PIPE SHALL BE CLASS 4 PER ODOT 706.02
 ALL HDPE PIPE SHALL BE SMOOTH LINED PER ODOT 707.33
 ALL PVC PIPE SHALL BE SDR 35 PER ODOT 707.45


NOTE:
 ALL OIL AND GAS WELL REMOVALS, PLUGGING/CAPPING, AND ABANDONMENTS SHALL BE IN ACCORDANCE WITH ALL ASSOCIATED REGULATIONS FOR SUCH REMOVALS, INCLUDING BUT NOT LIMITED TO, ODNR, LOCAL, STATE, AND FEDERAL.
 EXISTING HIGH PRESSURE GAS MAIN SHALL BE LOCATED AND PROTECTED PRIOR TO AND THROUGHOUT CONSTRUCTION.

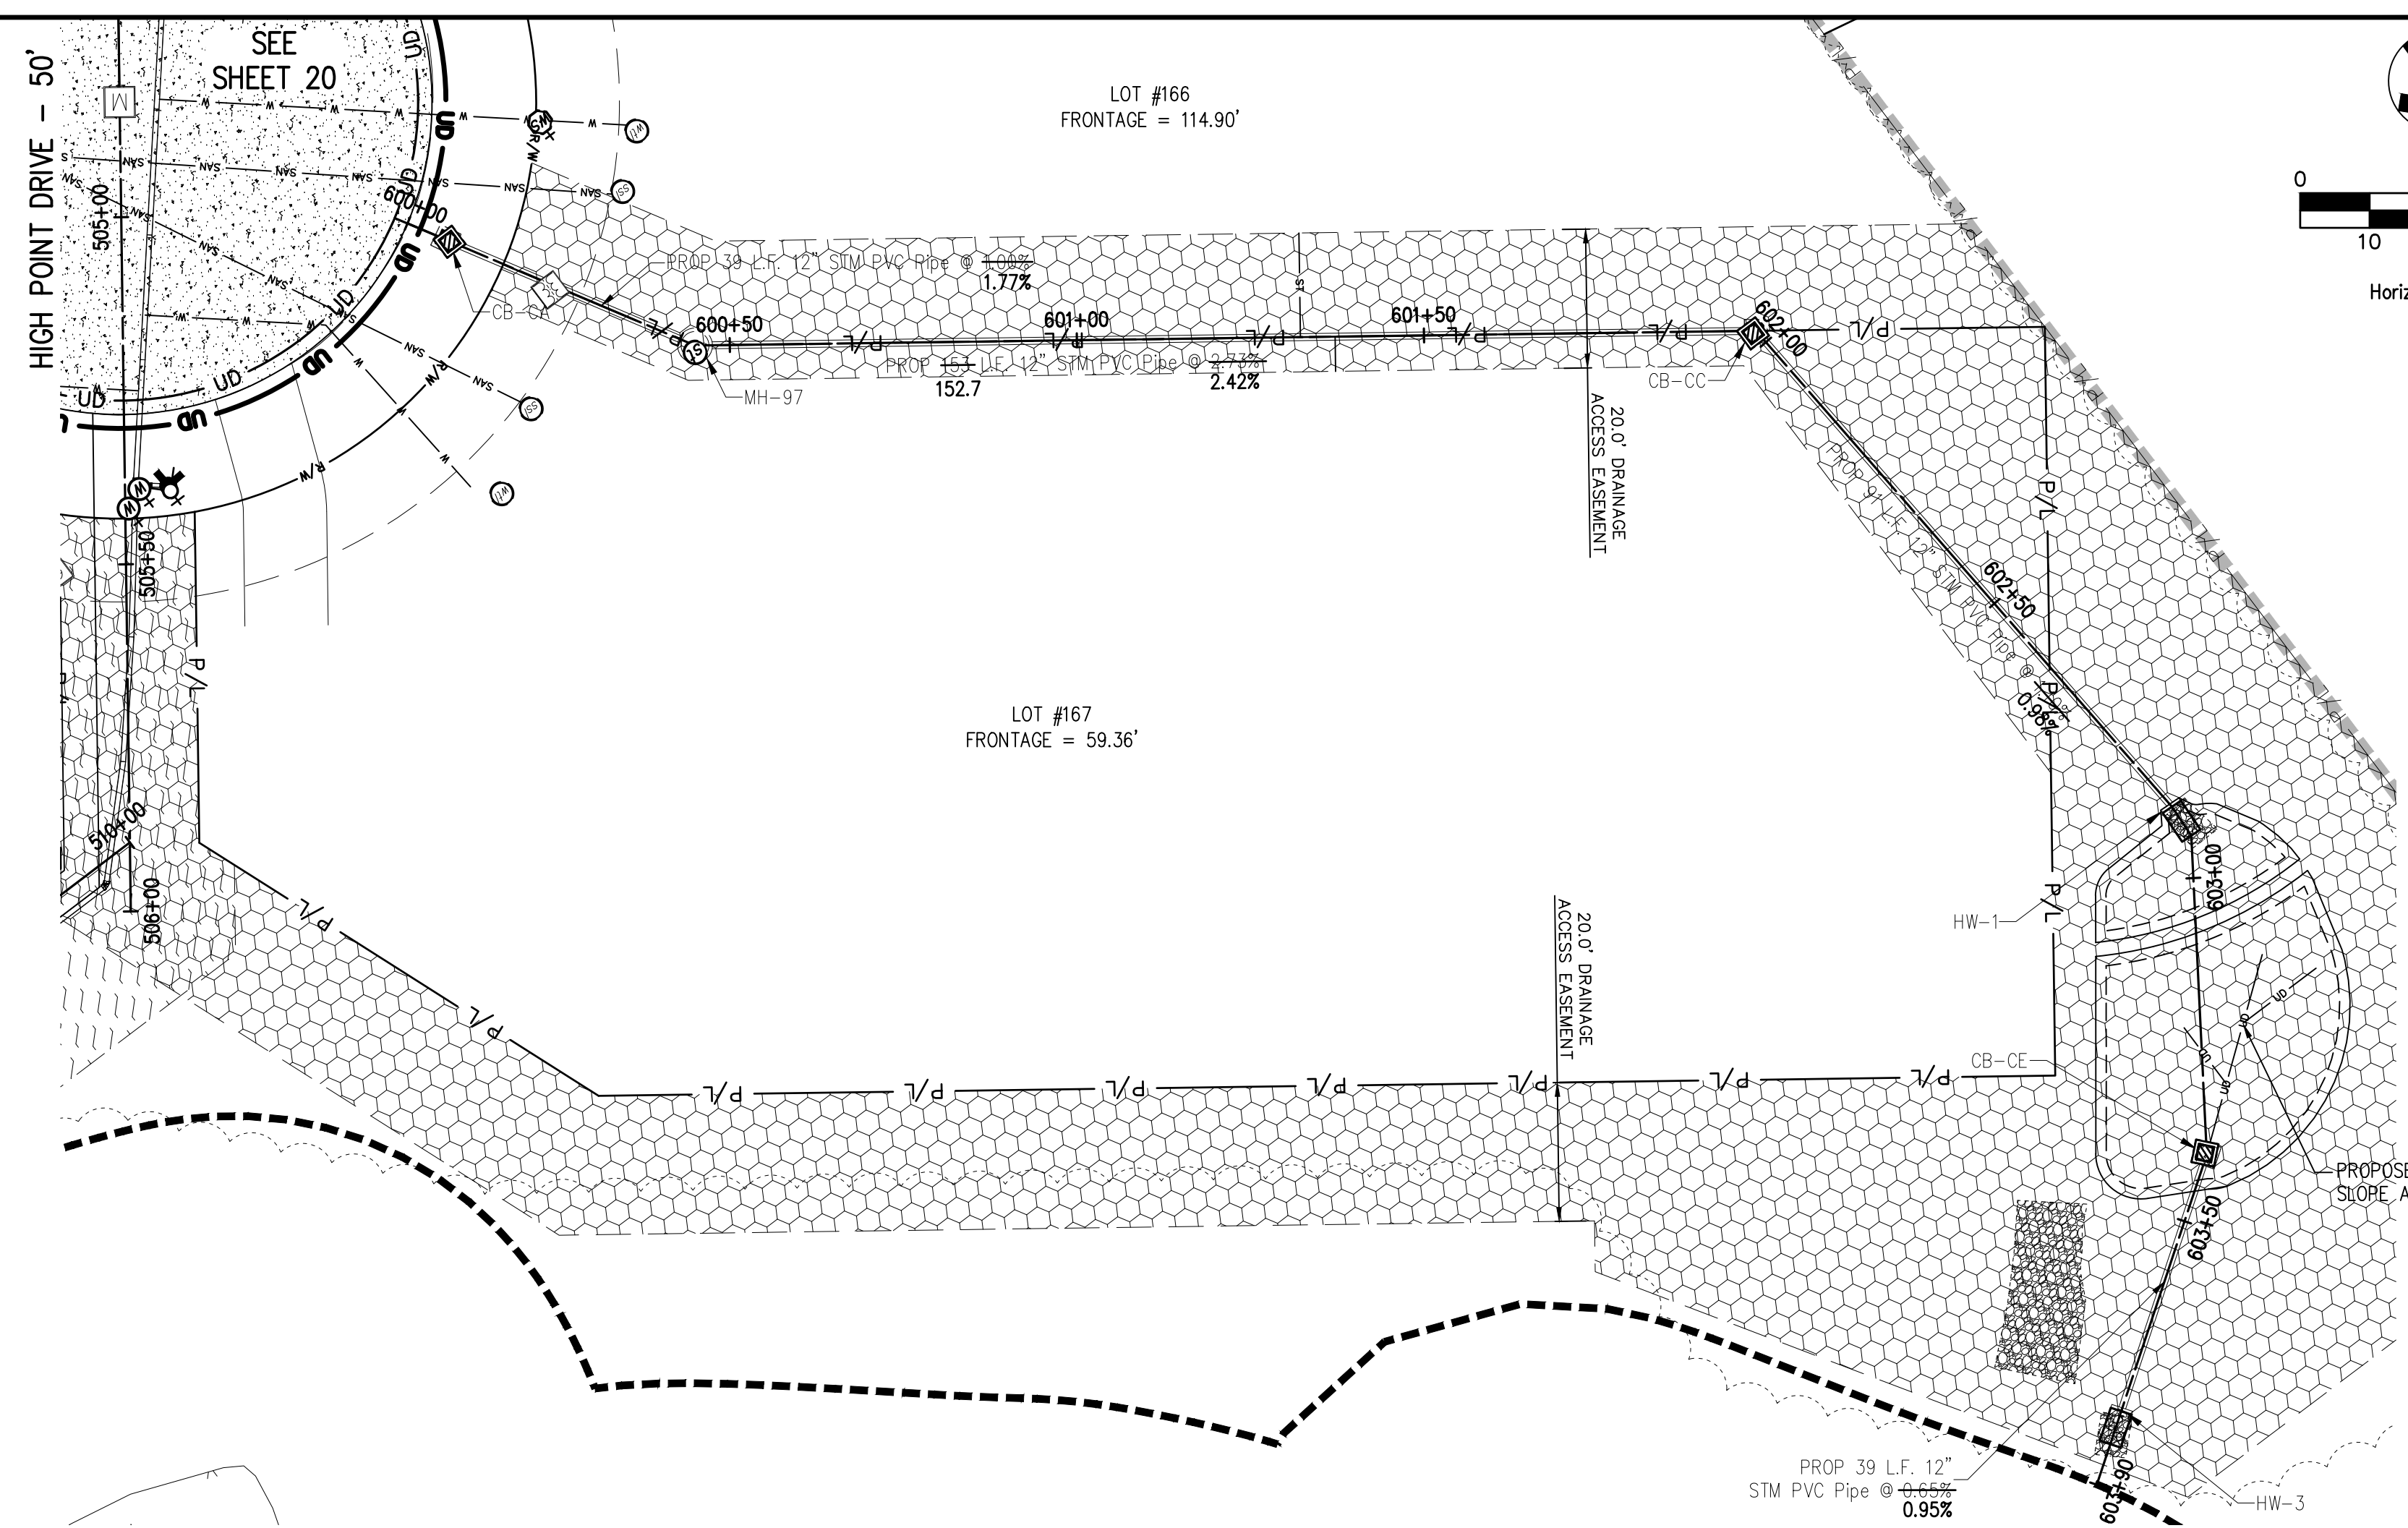

PLAN VIEW
 SCALE: 1"=20'

AS-BUILT LEGEND

	AS-BUILT CATCH BASIN
	AS-BUILT STORM LATERAL TERMINATION
	AS-BUILT SANITARY MANHOLE
	AS-BUILT SANITARY LATERAL TERMINATION
	AS-BUILT HYDRANT
	AS-BUILT WATER LATERAL TERMINATION
	AS-BUILT WATER SERVICE VALVE

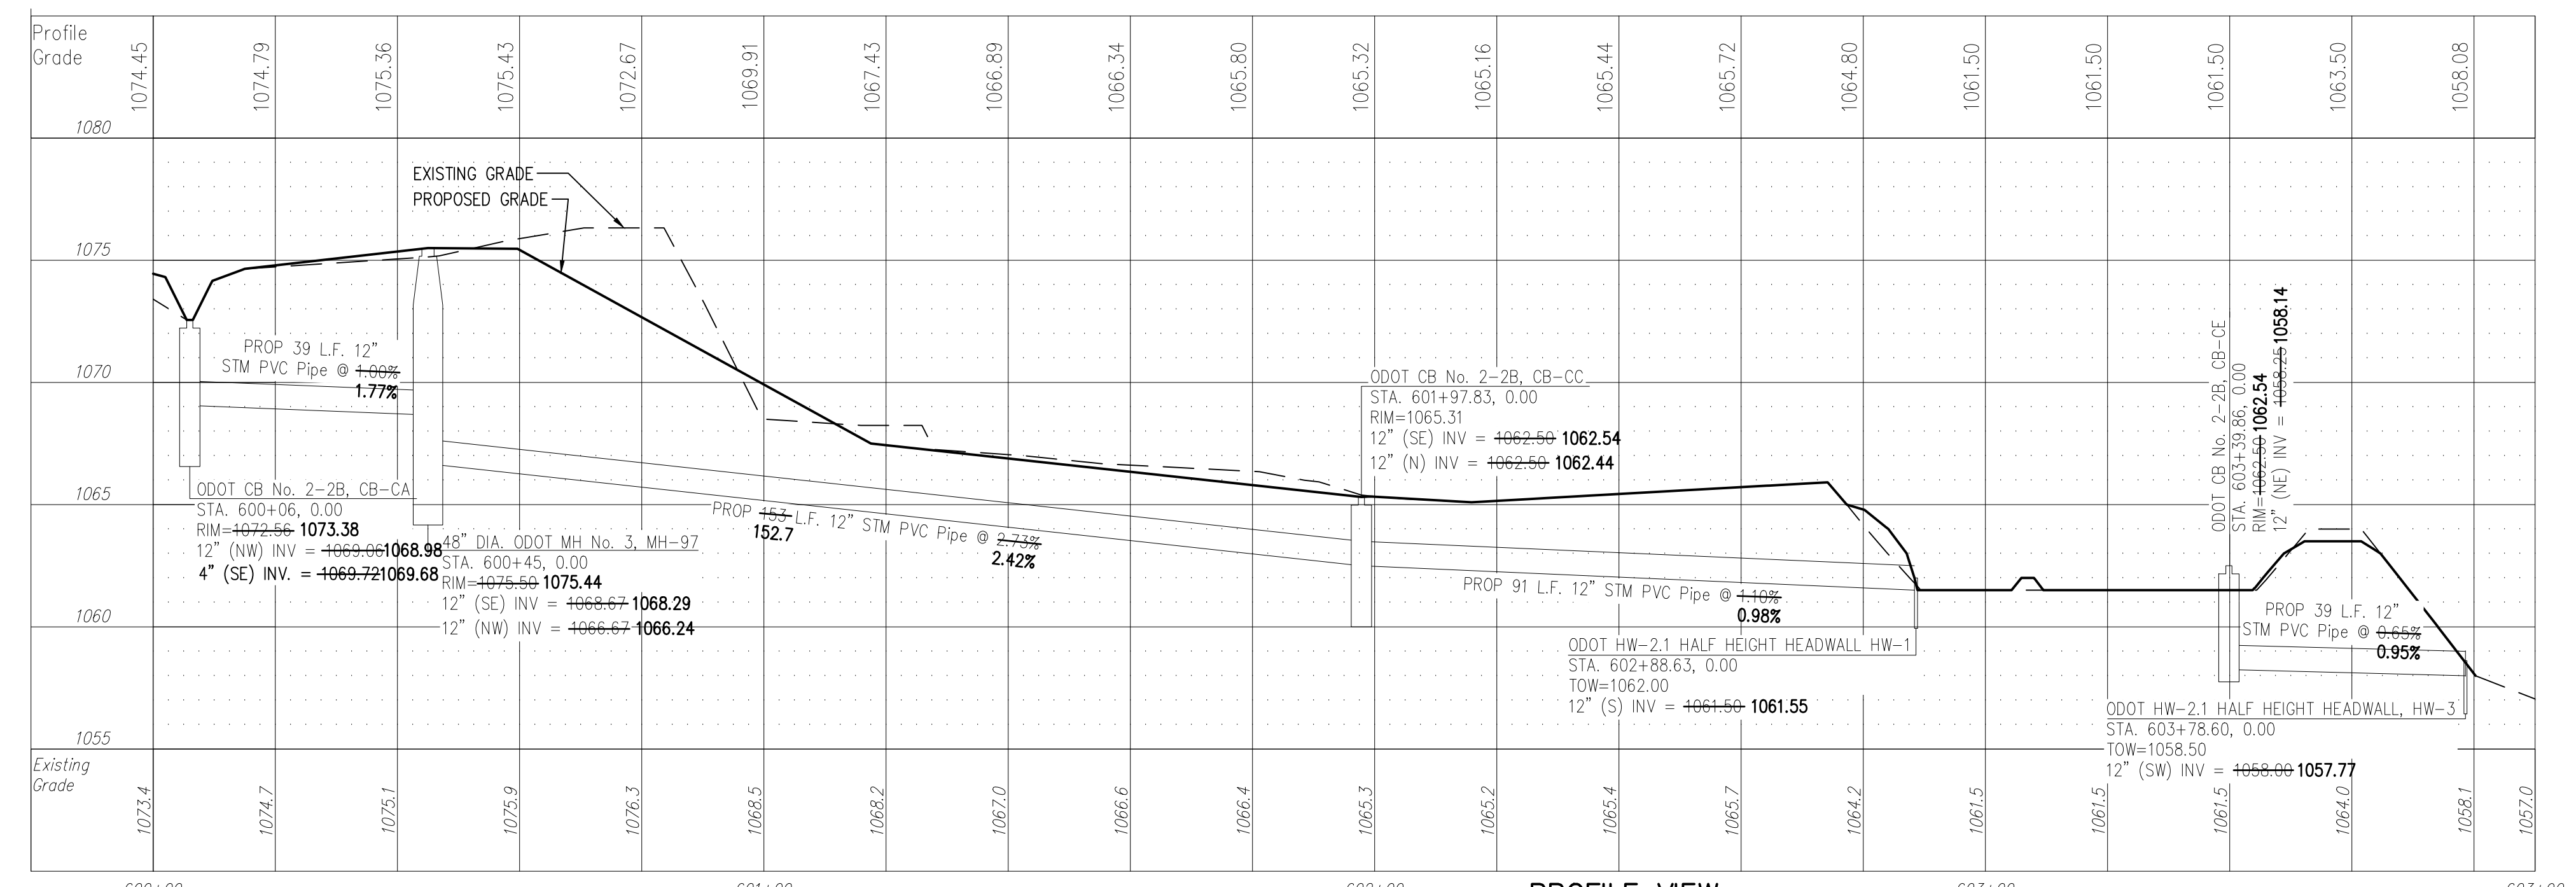

PROFILE VIEW
 HORIZONTAL SCALE: 1"=20'
 VERTICAL SCALE: 1"=5'

REV.	DATE	DESCRIPTION

THE PRESERVE AT MILLER'S FARM
PHASE 4 AS-BUILTS
 SE CORNER OF SR 18 AND MEDINA LINE RD
 COPLEY, OHIO 44321

PLAN AND PROFILE
STORM SEWER

ISSUED FOR:

PERMIT	
BID	
CONSTRUCTION	
AS-BUILT	01-19-2018

PROJECT MANAGER	DESIGNER
MAL	ALF

JOB NO.
2013258.04

21/29