

PROPOSED DEVELOPMENT

LIONS PARK

ALLOTMENT & CONDOMINIUMS

MARION AVE, SPRINGFIELD TOWNSHIP, SUMMIT COUNTY, OHIO

PHASE I
D.O.E.S PROJECT NO. 9492
MAY, 2004


DEVELOPER

THE JUMBERT CONSTRUCTION COMPANY
GEORGE JUMBERT
611 SAN PIER DRIVE
AKRON, OHIO 44333
(330) 666-2888

CIVIL ENGINEERING SERVICES

TTR ENGINEERS
485 CANTON ROAD
AKRON, OH 44312
330-733-8332
330-733-8326 FAX

SANITARY SEWER TREATMENT PLANT DESTINATION: AKRON WATER POLLUTION CONTROL STATION

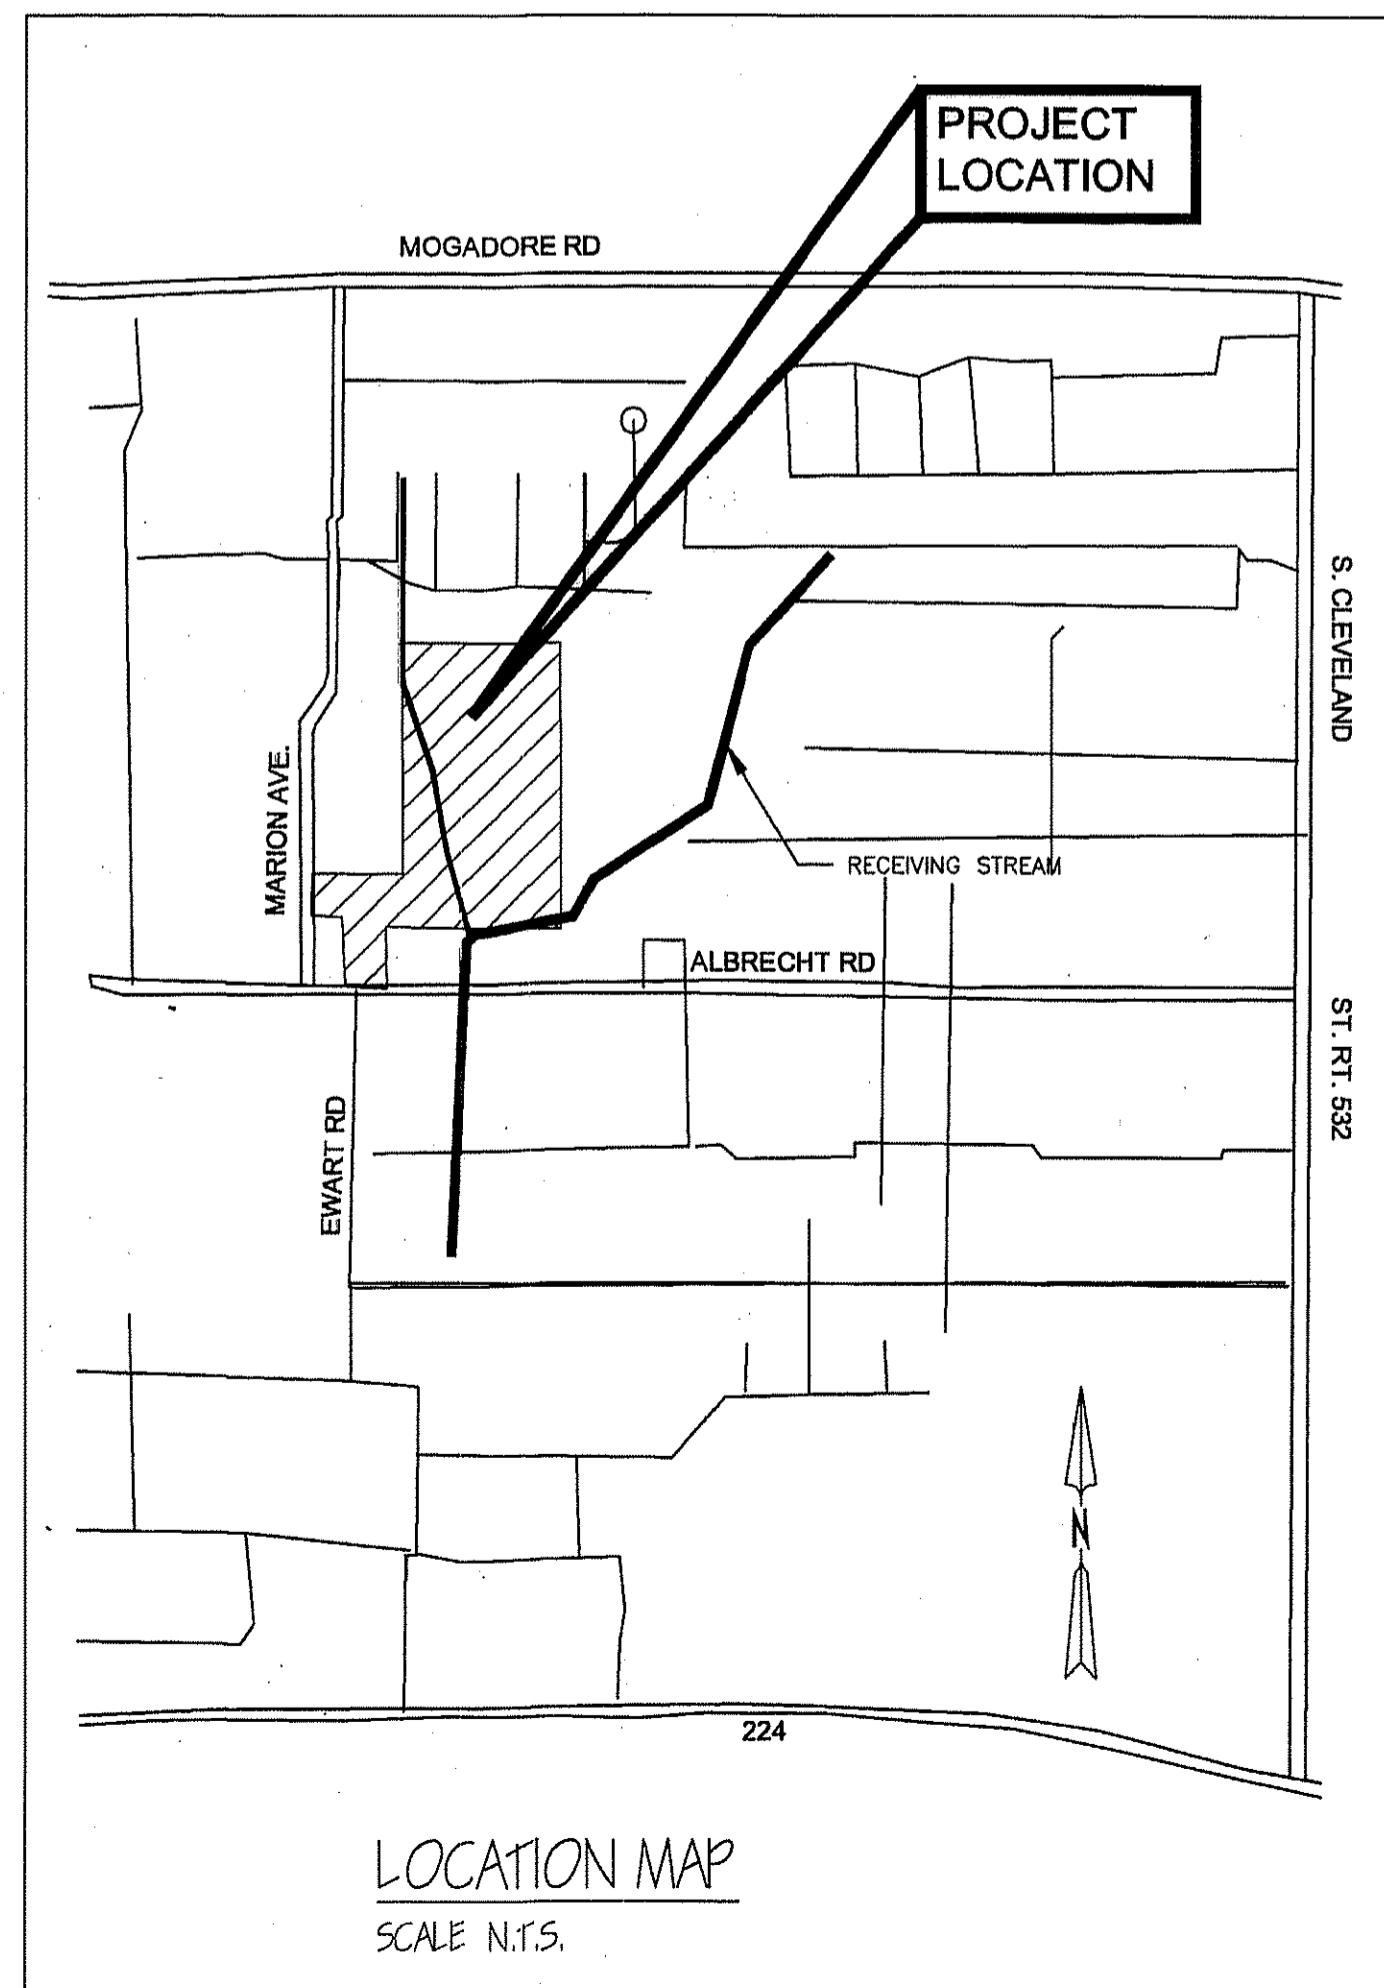

PROP. UTILITIES IN PLAN

GOVERNING AGENCY	UTILITY
CITY OF AKRON PUBLIC UTILITIES BUREAU	WATER
SUMMIT COUNTY DEPT. OF ENV. SERVICES	SANITARY
SUMMIT COUNTY ENGINEER	STORM

UTILITY CONTACTS

COMPANY	TELEPHONE No.
SBC (PHONE)	(330) 384-8108
TIME WARNER (CABLE)	(330) 630-7950
DOMINION (GAS)	(330) 742-8124
SUMMIT SWCD	(330) 929-2871
CITY OF AKRON PUBLIC UTILITIES BUREAU (WATER)	(330) 375-2420
SUMMIT COUNTY ENV. SERVICES (SANITARY SEWER)	(330) 926-2444
SUMMIT COUNTY ENGINEER (STORM SEWER)	(330) 643-2850

UNDERGROUND UTILITIES
TWO WORKING DAYS
BEFORE YOU DIG
CALL 1-800-362-2764 (TOLL FREE)
OHIO UTILITIES PROTECTION SERVICE
NON-MEMBERS
MUST BE CALLED DIRECTLY

No.	CONTENTS
1	GENERAL SITE PLAN
2	GENERAL UTILITY PLAN
3	GENERAL GRADING PLAN
3a	GENERAL GRADING PLAN
3b	GENERAL GRADING PLAN
4	PLAN AND PROFILE - MARION AVE.
5	PLAN AND PROFILE - LIONS PARK DR.
6	PLAN AND PROFILE - LIONS PARK DR.
7	PLAN AND PROFILE - LIONS PARK DR. EXT.
7a	CULVERT DETAILS
7b	CULVERT DETAILS
7c	CULVERT DETAILS
7d	PLAN AND PROFILE - E. STM OUTLET
8	PLAN AND PROFILE - ANGIE'S DR.
9	PLAN AND PROFILE - ANGIE'S DR.
10	PLAN AND PROFILE - ANGIE'S DR.
11	PLAN AND PROFILE - GEORGIE'S DR.
12	PLAN AND PROFILE - WEST SAN. TRUNK
13	PLAN AND PROFILE - EAST SAN. TRUNK
14	CROSS SECTIONS - LIONS PARK DR.
15	CROSS SECTIONS - LIONS PARK DR.
16	CROSS SECTIONS - LIONS PARK DR. EXT.
17	CROSS SECTIONS - ANGIE'S DR.
18	CROSS SECTIONS - ANGIE'S DR.
19	CROSS SECTIONS - GEORGIE'S DR.
20	SWP3 TEMP. SEDIMENT CONTROL PLAN
21	SWP3 PERM. SEDIMENT CONTROL PLAN
22	GRADING & SWP3 DETAILS & NOTES
22a	GRADING & SWP3 DETAILS & NOTES
22b	WETLAND DETENTION BASIN PLAN
23	GRADING, SWP3, & CULVERT DETAILS & NOTES
24	SUMMIT COUNTY DETAILS & NOTES
24a	ODOT DETAILS
25	SUMMIT COUNTY DETAILS & NOTES
25a	SUMMIT COUNTY DETAILS & NOTES
26	CITY OF AKRON DETAILS & NOTES
26a	RETAINING WALL DETAILS
27	INTERSECTION DETAILS
28	PROPOSED EASEMENT PLAN
29	PROPOSED EASEMENT PLAN

SUBMITTED BY:

Brian K. Rostedt

BRIAN K. ROSTEDT
TROIKE-TEELING-ROSTEDT ENGINEERS
REGISTERED ENGINEER
OHIO REG. ENGINEER NO. E-54002



APPROVED BY:

George Jumbert
DEVELOPER, GEORGE JUMBERT

C. Michael Wahl 4/17/06
MOGADORE APPROVAL DATE
Drew Barber 10-25-05
COUNTY ENGINEER DATE
Danilo Campanelli 04-21-06
SPRINGFIELD TOWNSHIP APPROVAL DATE

SANITARY APPROVAL BY SUMMIT COUNTY D.O.E.S.

David E. Marquand 5/6/06
DIRECTOR DATE
Ronald G. Hordshell May 4, 2006
PUBLIC WORKS MANAGER DATE

OHIO EPA

6/21/06
SEWER APPROVED BY LETTER DATED:
5/2/06
WATER APPROVED BY LETTER DATED:

WATERLINE APPROVAL BY CITY OF AKRON

Tony Luchi 5-2-06
UTILITIES ENGINEER DATE
Michael L. McGlinchey 5-3-06
PUBLIC UTILITIES BUREAU MANAGER DATE
Donald Holland 5-3-06
DIRECTOR OF PUBLIC SERVICE DATE

SUBMITTAL #1, 06-10-04
SUBMITTAL #2, 08-17-04
SUBMITTAL #3, 11-19-04
SUBMITTAL #4, 04-27-05
SUBMITTAL #5, 07-18-05
SUBMITTAL #6, 08-22-05