
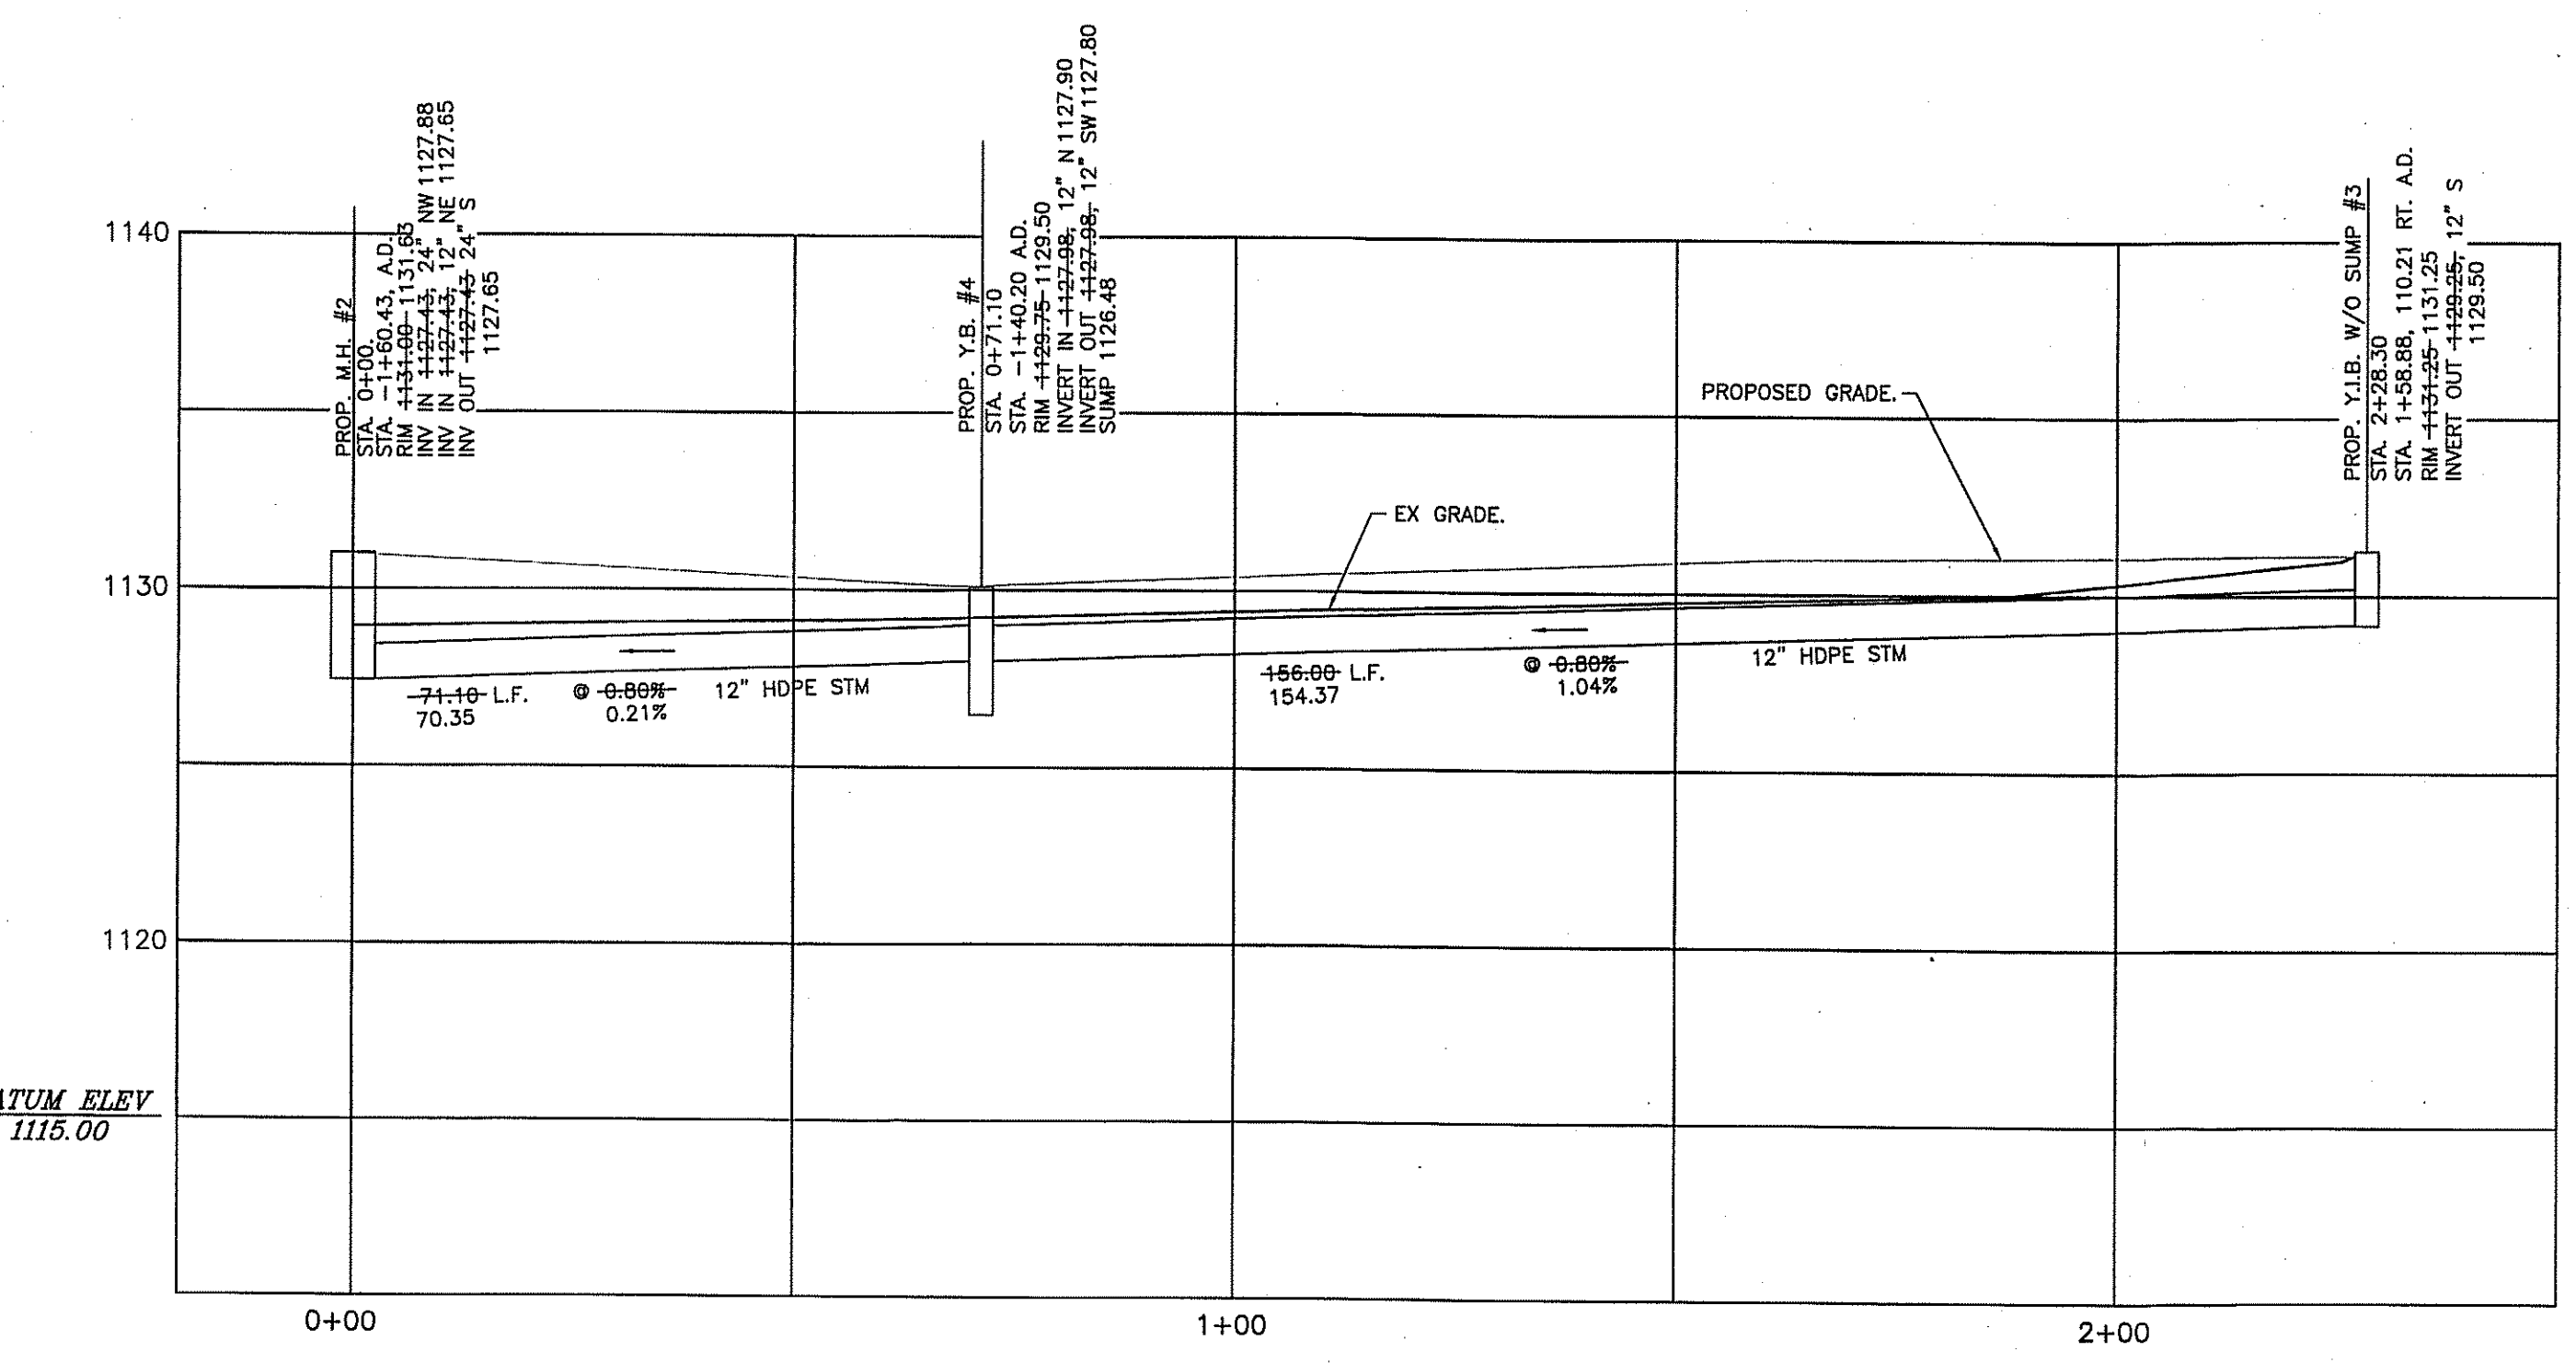



BENCH MARK 1
SURVEY SPIKE NAIL SET IN THE NORTH SIDE OF A POWER POLE LOCATED ON THE EAST SIDE OF MARION AVENUE ACROSS FROM ADDRESS: 332 MARION AVE. ELEVATION = 1145.88'

BENCH MARK 2
"R" IN COREY ON A HYDRANT LOCATED ON THE NORTHEAST CORNER OF HERBERT STREET AND DONOVAN AVENUE IN FRONT OF ADDRESS: 151 DONOVAN AVENUE ELEVATION = 1164.65'


STORM SEWER PROFILE

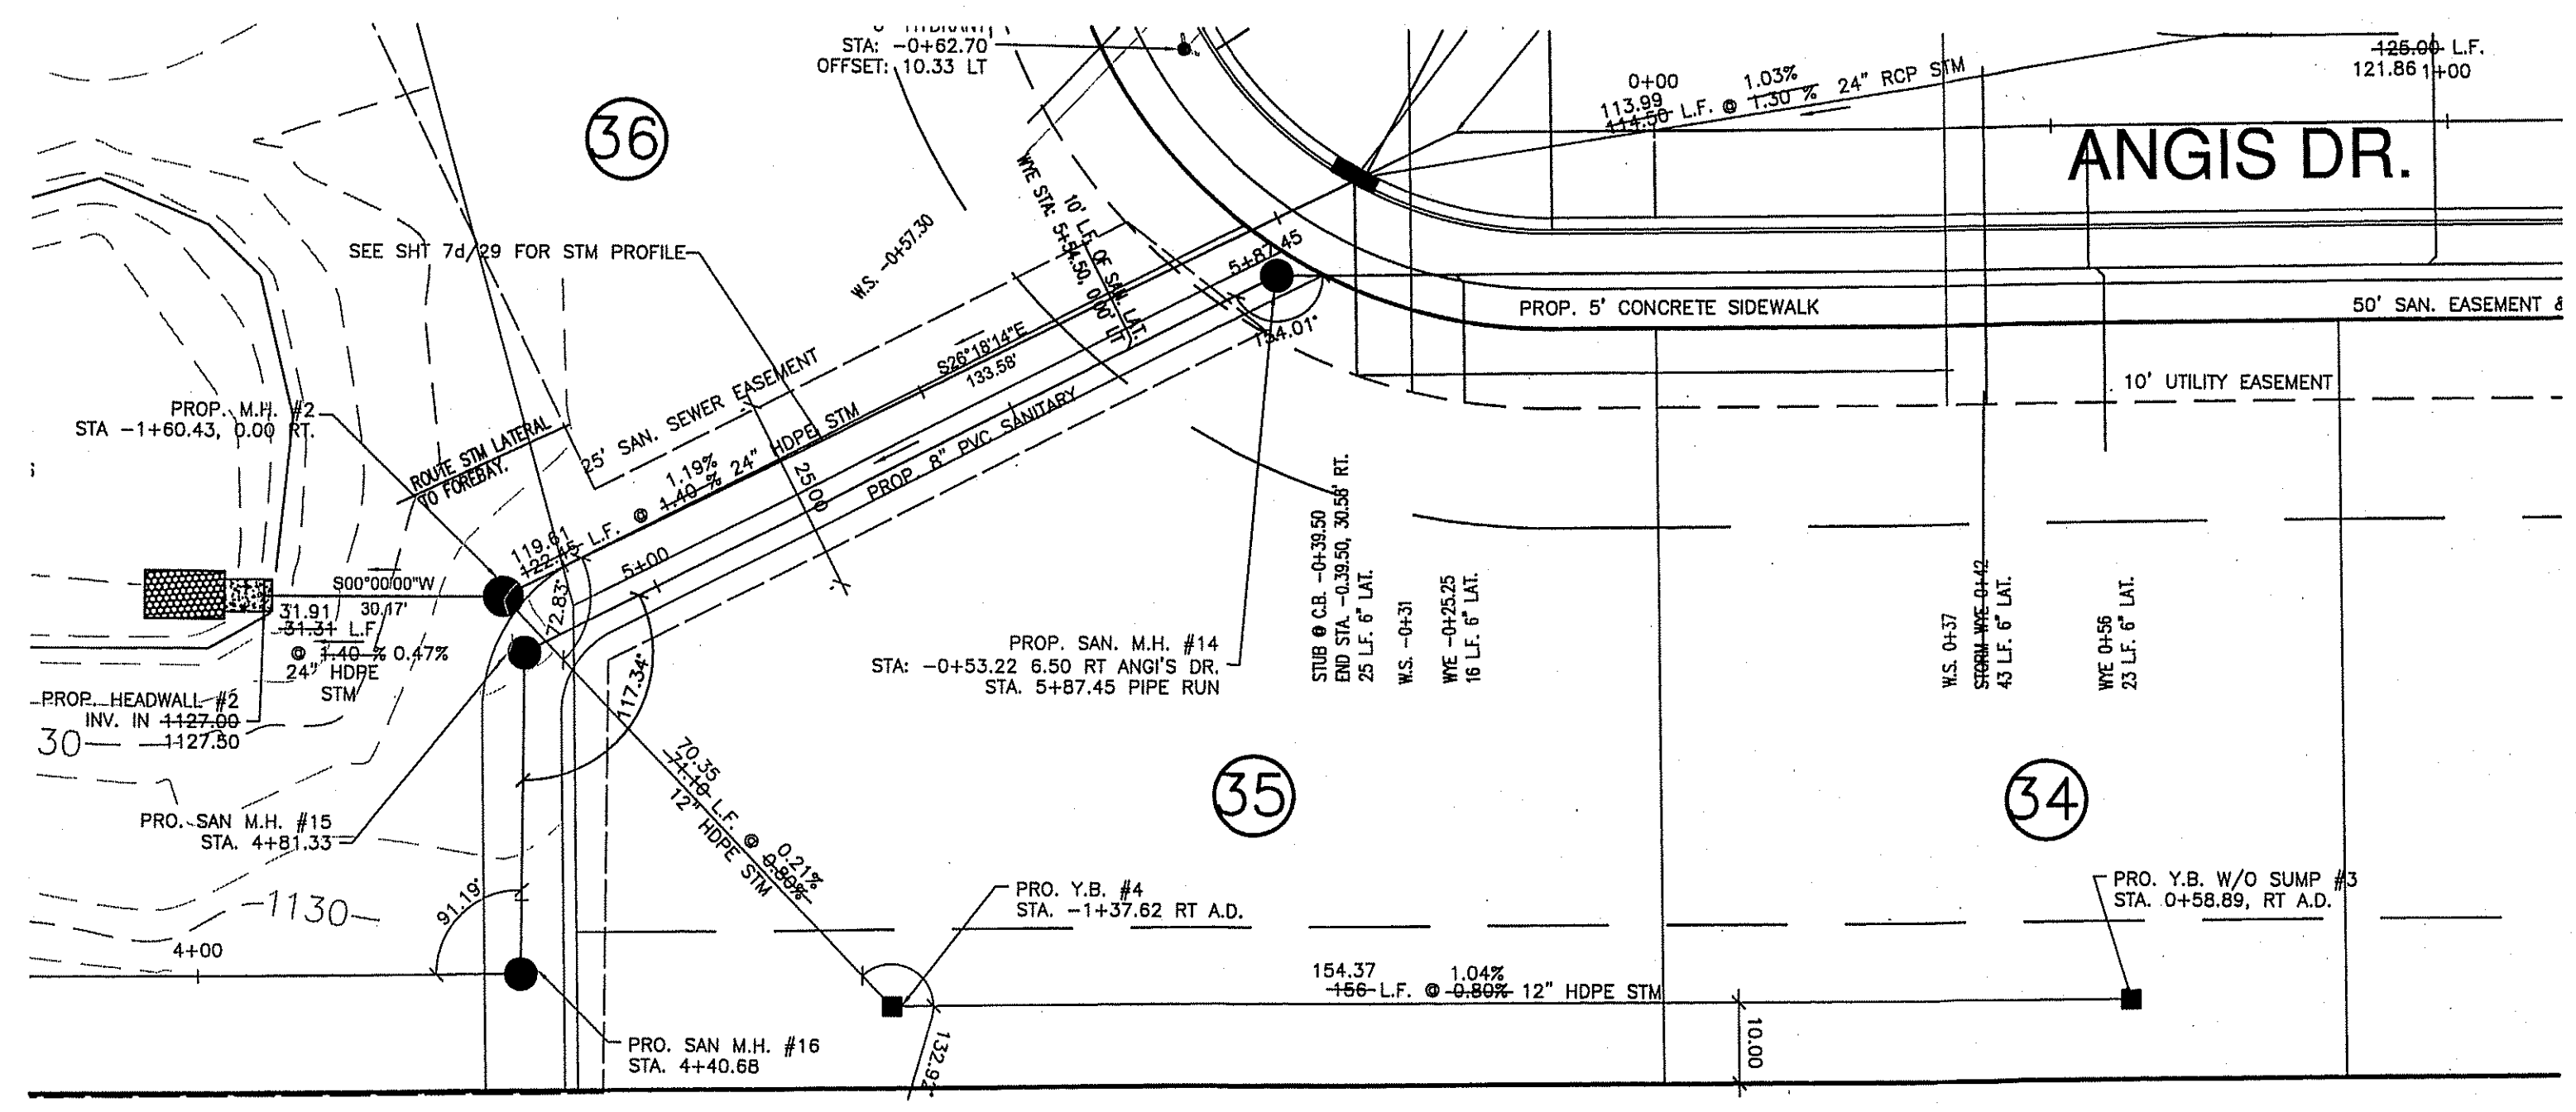

STORM SEWER PROFILE
EAST SWALE

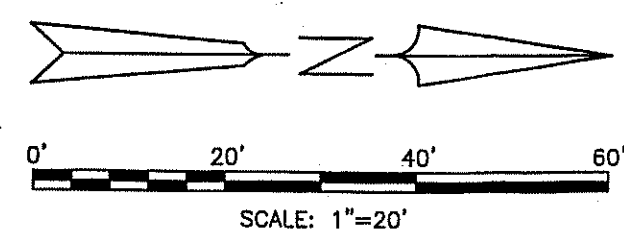

NOTE:
RCP=ODOT ITEM 706.02
HDPE = ODOT ITEM 707.33.

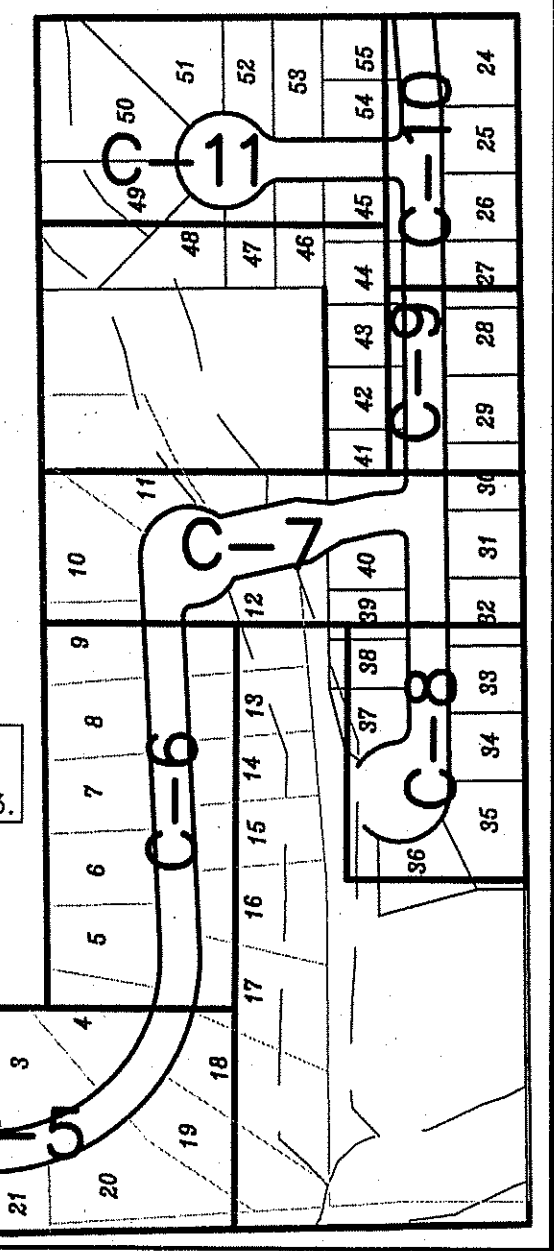

DATE	REVISION
04-29-05	△ COSE COMMENTS
07-18-05	△ SUMMIT ENG COMMENTS
DRAWN: -	
CHECKED: -	
SCALE	DATE
HOR: 1" = 20'	04-24-15
VER: 1" = 5'	
KIDS JABER, LLC	
LIONS PARE ALLOTMENT & CONDOMINIUMS	
MARION AVE, SPRINGFIELD TOWNSHIP, OHIO	
PLAN & PROFILE	
BOX CULVERT/ANGIS DR. STM OUTLT	
SPAGNUOLO & ASSOCIATES, LLC	
3057 WEST MARKET STREET, SUITE 201 • FAIRLAWN, OH 44433	
PHONE: (330) 836-6661 • FAX: (330) 836-6115	
EMAIL: dsbcoffer@spagnuoloassociates.com	
7d	29