



DATUM ELEV.
1115.00

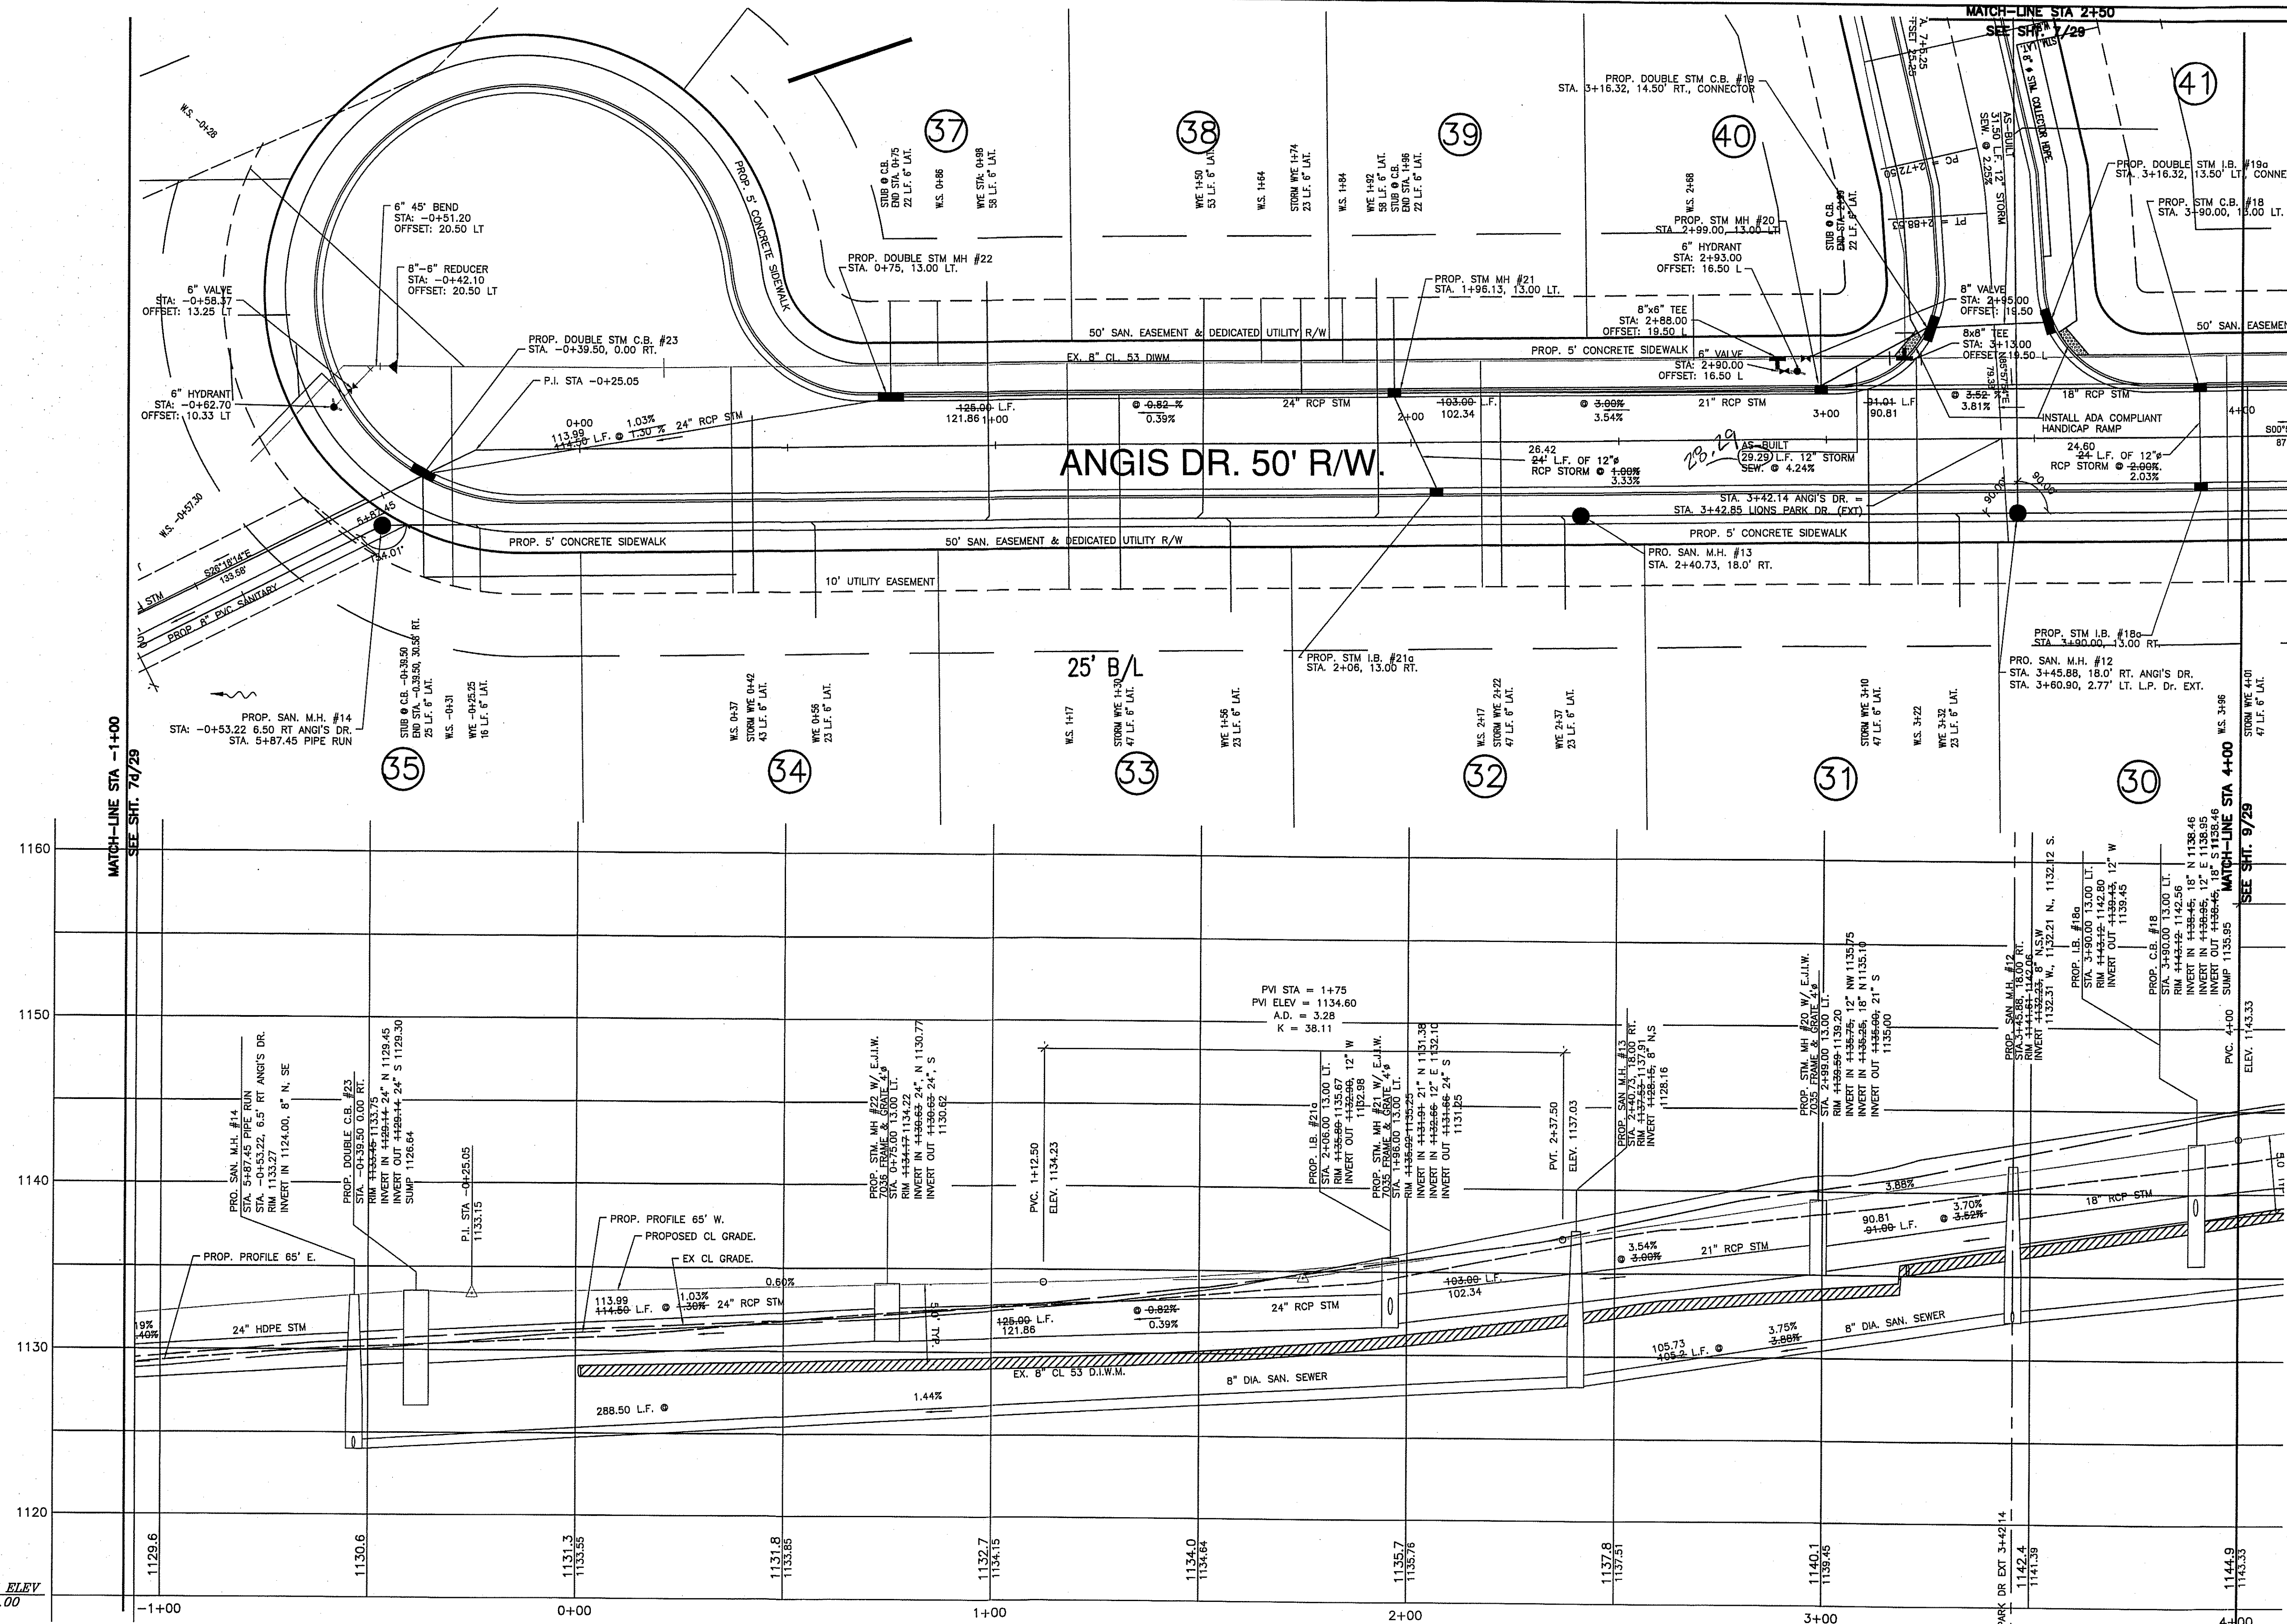

PROP. WATER SERVICE LOCATIONS

LOT	SIZE	LENGTH	LOCATION
30	1"	54.50 L.F.	3+96.00 35.00' LT.
31	1"	54.50 L.F.	3+22.00 35.00' LT.
32	1"	54.50 L.F.	2+17.00 35.00' LT.
33	1"	54.50 L.F.	1+17.00 35.00' LT.
34	1"	54.50 L.F.	0+37.00 35.00' RT.
35	1"	54.50 L.F.	-0+31.00 35.00' RT.
36	1"	70.00 L.F.	-0+28.00 35.00' RT.
37	1"	15.50 L.F.	0+86.00 35.00' RT.
38	1"	15.50 L.F.	1+64.00 35.00' RT.
39	1"	15.50 L.F.	1+84.00 35.00' RT.
40	1"	15.50 L.F.	2+68.00 35.00' RT.

NOTE:
FOR STORM MANHOLES #20 & #21, THE DIAMETER MUST BE A MINIMUM OF 4' AND SHALL CONSIST OF E.J.I.W. 7035 FRAME & GRATE WITH TYPE T4 BACK AND M6 VANE GRATE. FOR STORM MANHOLE #22, THE DIAMETER MUST BE A MINIMUM OF 7' AND SHALL CONSIST OF E.J.I.W. 7036 FRAME & GRATE WITH TYPE T4 BACK AND M2 GRATE.

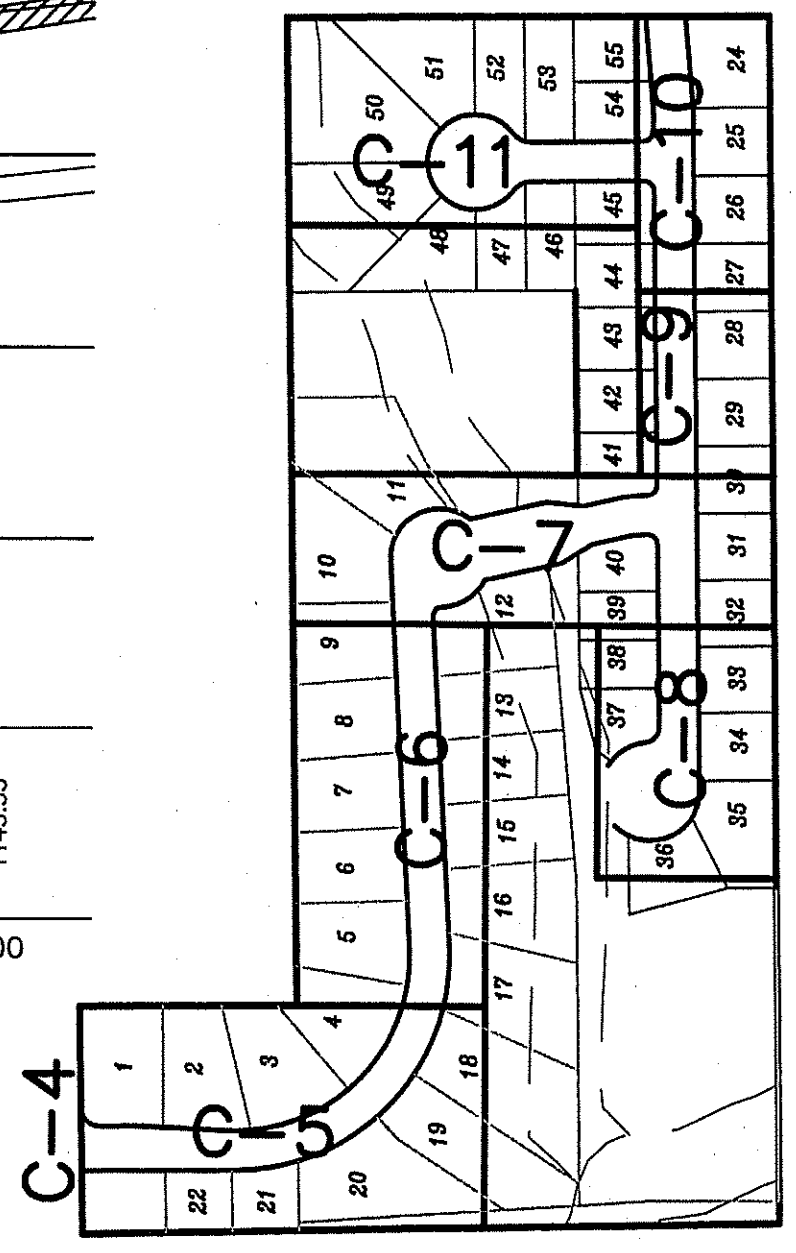


STM C.B. & I.B. OFFSETS ARE GIVEN TO BACK OF CURB AS PER COSE STD DWG FOUND ON SHT 25/29

NOTE:
RCP=ODOT ITEM 706.02
HDPE = ODOT ITEM 707.33.

BENCH MARK 1
SURVEY SPIKE NAIL SET IN THE NORTH SIDE OF A POWER POLE LOCATED ON THE EAST SIDE OF MARION AVENUE ACROSS FROM ADDRESS: 332 MARION AVE. ELEVATION = 1145.86'

BENCH MARK 2
"R" IN COREY ON A HYDRANT LOCATED ON THE NORTHEAST CORNER OF HERBERT STREET AND DONOVAN AVENUE IN FRONT OF ADDRESS: 151 DONOVAN AVENUE ELEVATION = 1164.65'

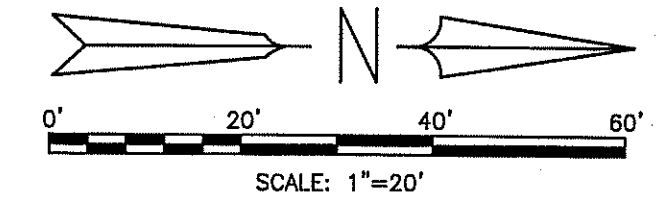

STORM & SANITARY AS-BUILT 3-08-2016

KIDS JABER, LLC LEADS PARE ALLOTMENT & CONDOUNITIONS MARION AVE, SPRINGFIELD TOWNSHIP, OHIO	SCALE	HOR: 1" = 20'	VER: 1" = 5'
	DRAWN:	CHECKED:	DATE:
SPAGNUOLO & ASSOCIATES, LLC 3057 WEST MARKET STREET, SUITE 201 • FAIRLAWN, OH 44133 PHONE: (330) 836-6661 • FAX: (330) 836-6115 EMAIL: dsboffice@spagnuoloassoc.com	REVISION	DATE	COMMENTS
	04-21-05	07-18-05	COSE COMMENTS SUMMIT ENG COMMENTS
PLAN & PROFILE - ANGIS DR.		04-24-15	
8 29		04-24-15	