

WETLAND DETENTION BASIN PLAN

NOTE: THE DETENTION BASIN WILL NOT BE USED AS A SEDIMENT BASIN.

WEST WATER QUALITY POND VOLUMES


	DESIGN	AS-BUILT
1125	0 cf	0 cf
1126	2,647 cf	1,119 cf
1127	6,521 cf	4,165 cf
1128	11,862 cf	8,959 cf
1129	19,004 cf	15,722 cf

EAST WATER QUALITY POND VOLUMES

	DESIGN	AS-BUILT
1125	0 cf	0 cf
1126	1,956 cf	2,026 cf
1127	6,604 cf	6,253 cf
1128	12,809 cf	12,208 cf
1129	20,704 cf	19,984 cf

VOLUMES

	DESIGN	AS-BUILT
1125	0 cf	0 cf
1126	321 cf	1,170 cf
1127	7,863 cf	9,563 cf
1128	36,017 cf	36,597 cf
1129	89,278 cf	92,677 cf
1130	164,391 cf	168,640 cf

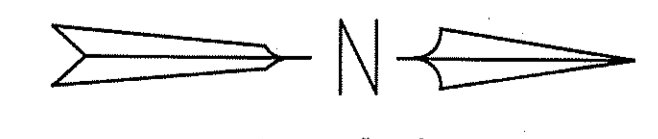

SCALE: 1"=40'

SPAGNUOLO & ASSOCIATES, LLC 3057 WEST MARKET STREET, SUITE 201 • FAIRLAWN, OH 44133 PHONE: (330) 836-6661 • FAX: (330) 836-6661 EMAIL: dscoffer@spagnuoloassoc.com	KIDS JABER, LLC LIONS PARK ALLOTMENT & CONDOMINIUMS MARION AVE. SPRINGFIELD TOWNSHIP, OHIO
WETLAND DETENTION BASIN PLAN	SCALE: 1" = 100' HOR. VER.: DATE: 04-24-15
DRAWN: - CHECKED: - DATE: -	DATE: - REVISION: -