



TYPICAL SECTION-REINFORCED RETAINING WALL
 MODULAR CONCRETE UNIT
 SCALE: NONE

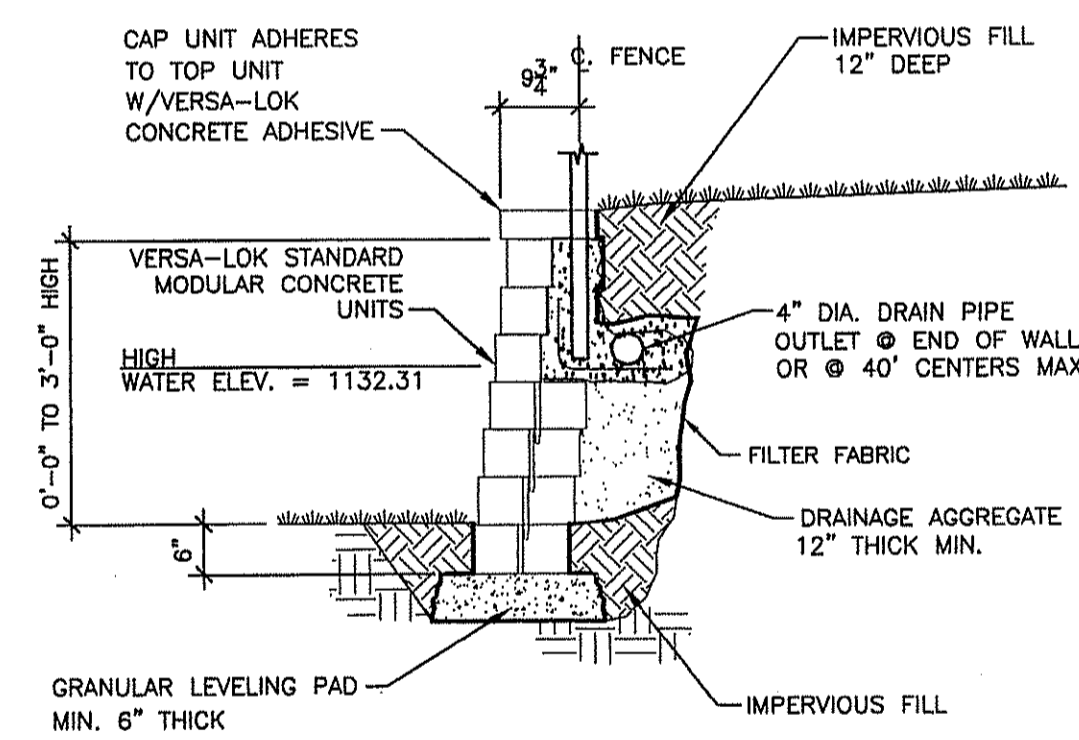


TYPICAL SECTION-UNREINFORCED RETAINING WALL
 SCALE: NONE

NOTES:

WALL SHALL BE INSTALLED AS PER MANUFACTURE'S REQUIREMENTS.

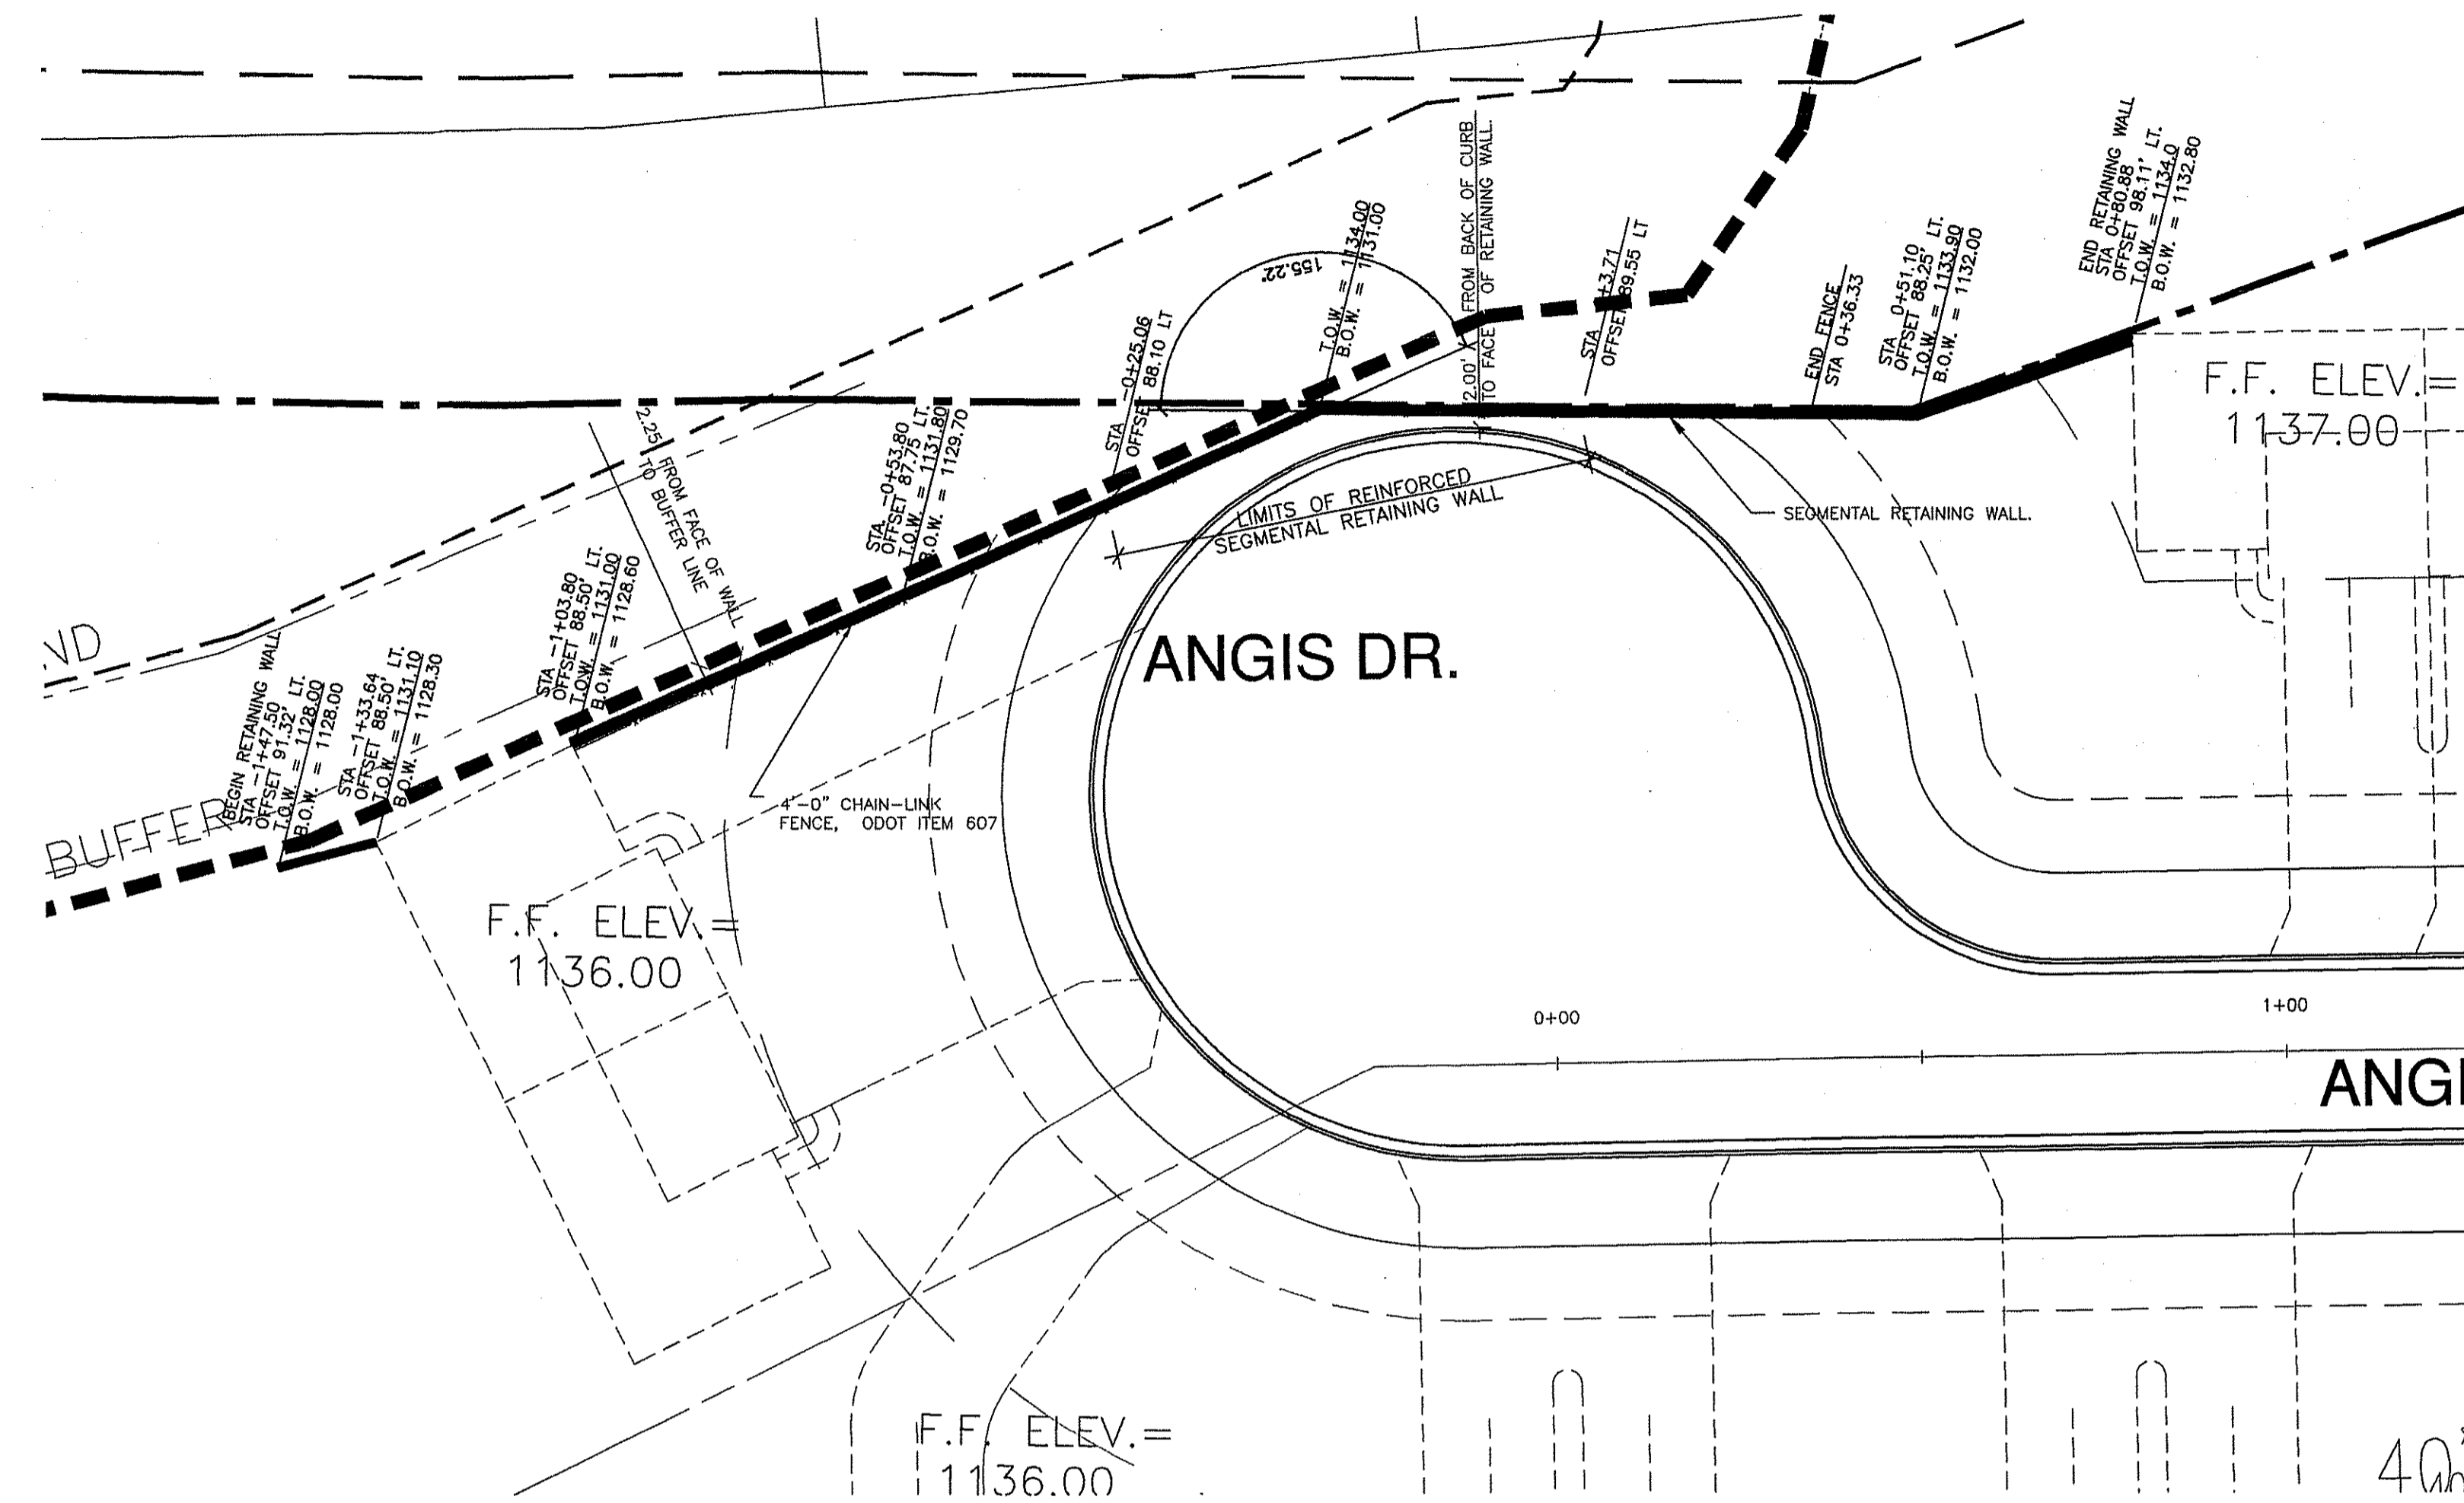

RETAINING WALL PLAN
 1"=20'

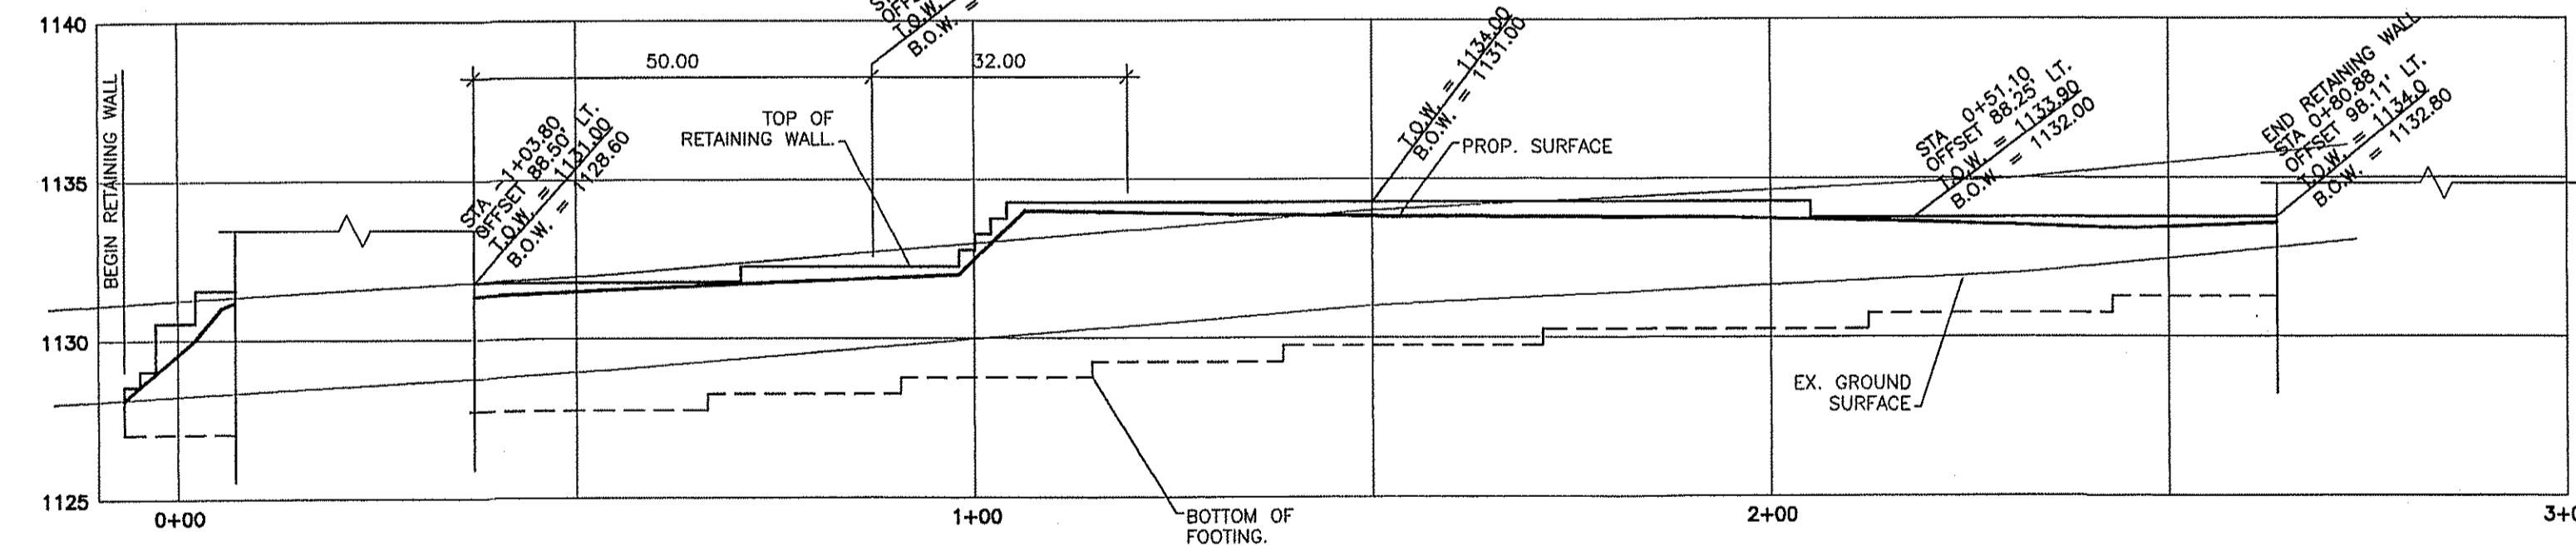

SEGMENTAL RETAINING WALL ELEVATION
 1"=20' HOR.
 1"=5' VERT.
 LOOKING WEST

STATIONING REFLECTS LENGTH ALONG SEGMENTAL RETAINING WALL

REVISION	DATE	BY	CHKD.
04-29-05	MWR	BKR	
08-17-04			
THE JUMBERT CONSTRUCTION CO. LIONS PARK ALLOTMENT & CONDOMINIUMS MARION AVE, SPRINGFIELD TOWNSHIP, OHIO			
RETAINING WALL - DETAILS & NOTES			
TROIKE-TEELING-ROSTEDT ENGINEERS AKRON, OH 44313 1923 AKRON PENINSULA RD PHONE: (330) 928-8388 FAX: (330) 928-3269 EMAIL: ttrdesign@tek.net			