

EX. WATER SERVICE LOCATIONS

LOT	SIZE	LENGTH	LOCATION
1	1"	11.00 L.F.	1+09.61 31.75' LT.
2	1"	9.00 L.F.	1+64.19 30.50' LT.
3	1"	9.00 L.F.	2+99.32 29.00' LT.
4	1"	8.00 L.F.	4+23.35 29.00' LT.
18	1"	50.00 L.F.	5+21.10 29.00' RT.
19	1"	50.00 L.F.	4+17.23 29.00' RT.
20	1"	48.00 L.F.	3+39.41 29.00' RT.
21	1"	51.00 L.F.	2+37.70 29.00' RT.
22	1"	52.00 L.F.	1+59.98 30.50' RT.

STORM LATERAL LOCATIONS

LOT	SIZE	LENGTH	LOCATION
1	6"	20.50 L.F.	0+84.00 38.00' LT.
2	6"	21.50 L.F.	2+22.00 35.02' LT.
3	6"	21.00 L.F.	3+81.00 35.00' LT.
4	6"	20.00 L.F.	4+45.00 35.00' LT.
18	6"	50.50 L.F.	5+33.00 35.00' RT.
19	6"	50.50 L.F.	4+48.00 35.00' RT.
20	6"	24.00 L.F.	3+58.00 35.00' RT.
21	6"	45.50 L.F.	2+86.00 35.00' RT.
22	6"	23.00 L.F.	1+75 36.25' RT.

LOCATION CALL OUTS FOR STM. AND WATER ARE TO THE END OF THE LATERAL

STM C.B. & I.B. OFFSETS ARE GIVEN TO BACK OF CURB AS PER COSE STD DWG FOUND ON SHT 25/29



NOTE:  
RCP=ODOT ITEM 706.02  
HDPE = ODOT ITEM 707.33.

NOTE:  
FOR STORM MANHOLES #3, #4, #5, & #7, THE DIAMETER MUST BE A MINIMUM OF 4' AND SHALL CONSIST OF E.J.I.W. 7035 FRAME & GRATE WITH TYPE T4 BACK AND M6 VANE GRATE. FOR STORM MANHOLE #6, THE DIAMETER MUST BE A MINIMUM OF 7' AND SHALL CONSIST OF E.J.I.W. 7036 FRAME & GRATE WITH TYPE T4 BACK AND M2 GRATE.

BENCH MARK 1  
SURVEY SPIKE NAIL SET IN THE NORTH SIDE OF A POWER POLE LOCATED ON THE EAST SIDE OF MARION AVENUE ACROSS FROM ADDRESS 332 MARION AVENUE. ELEVATION = 1145.86'

BENCH MARK 2  
"R" IN COREY ON A HYDRANT LOCATED ON THE NORTHEAST CORNER OF HERBERT STREET AND DONOVAN AVENUE IN FRONT OF ADDRESS: 151 DONOVAN AVENUE. ELEVATION = 1164.65'

LOW POINT' ELEV = 1134.02  
LOW POINT STA = 4+95.83  
PVI STA = 4+50  
PVI ELEV = 1133.68  
A.D. = 2.88  
K = 52.08

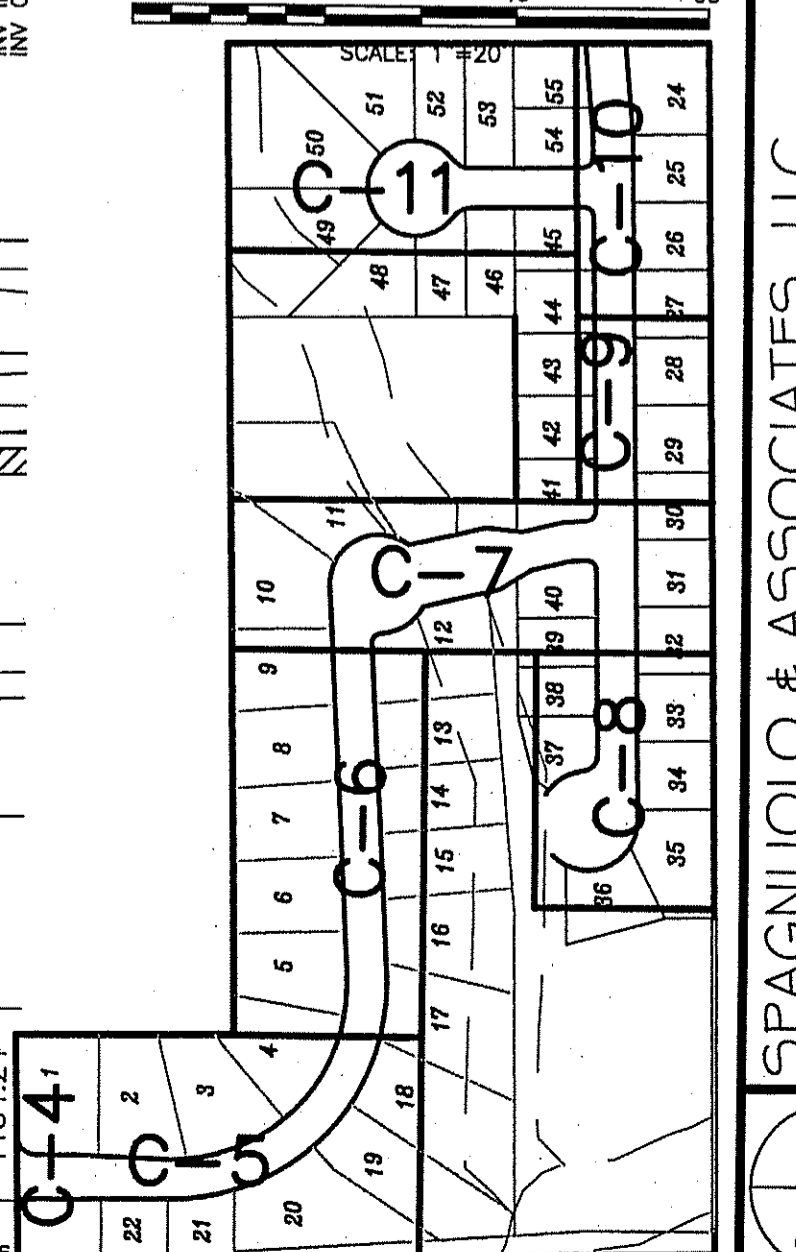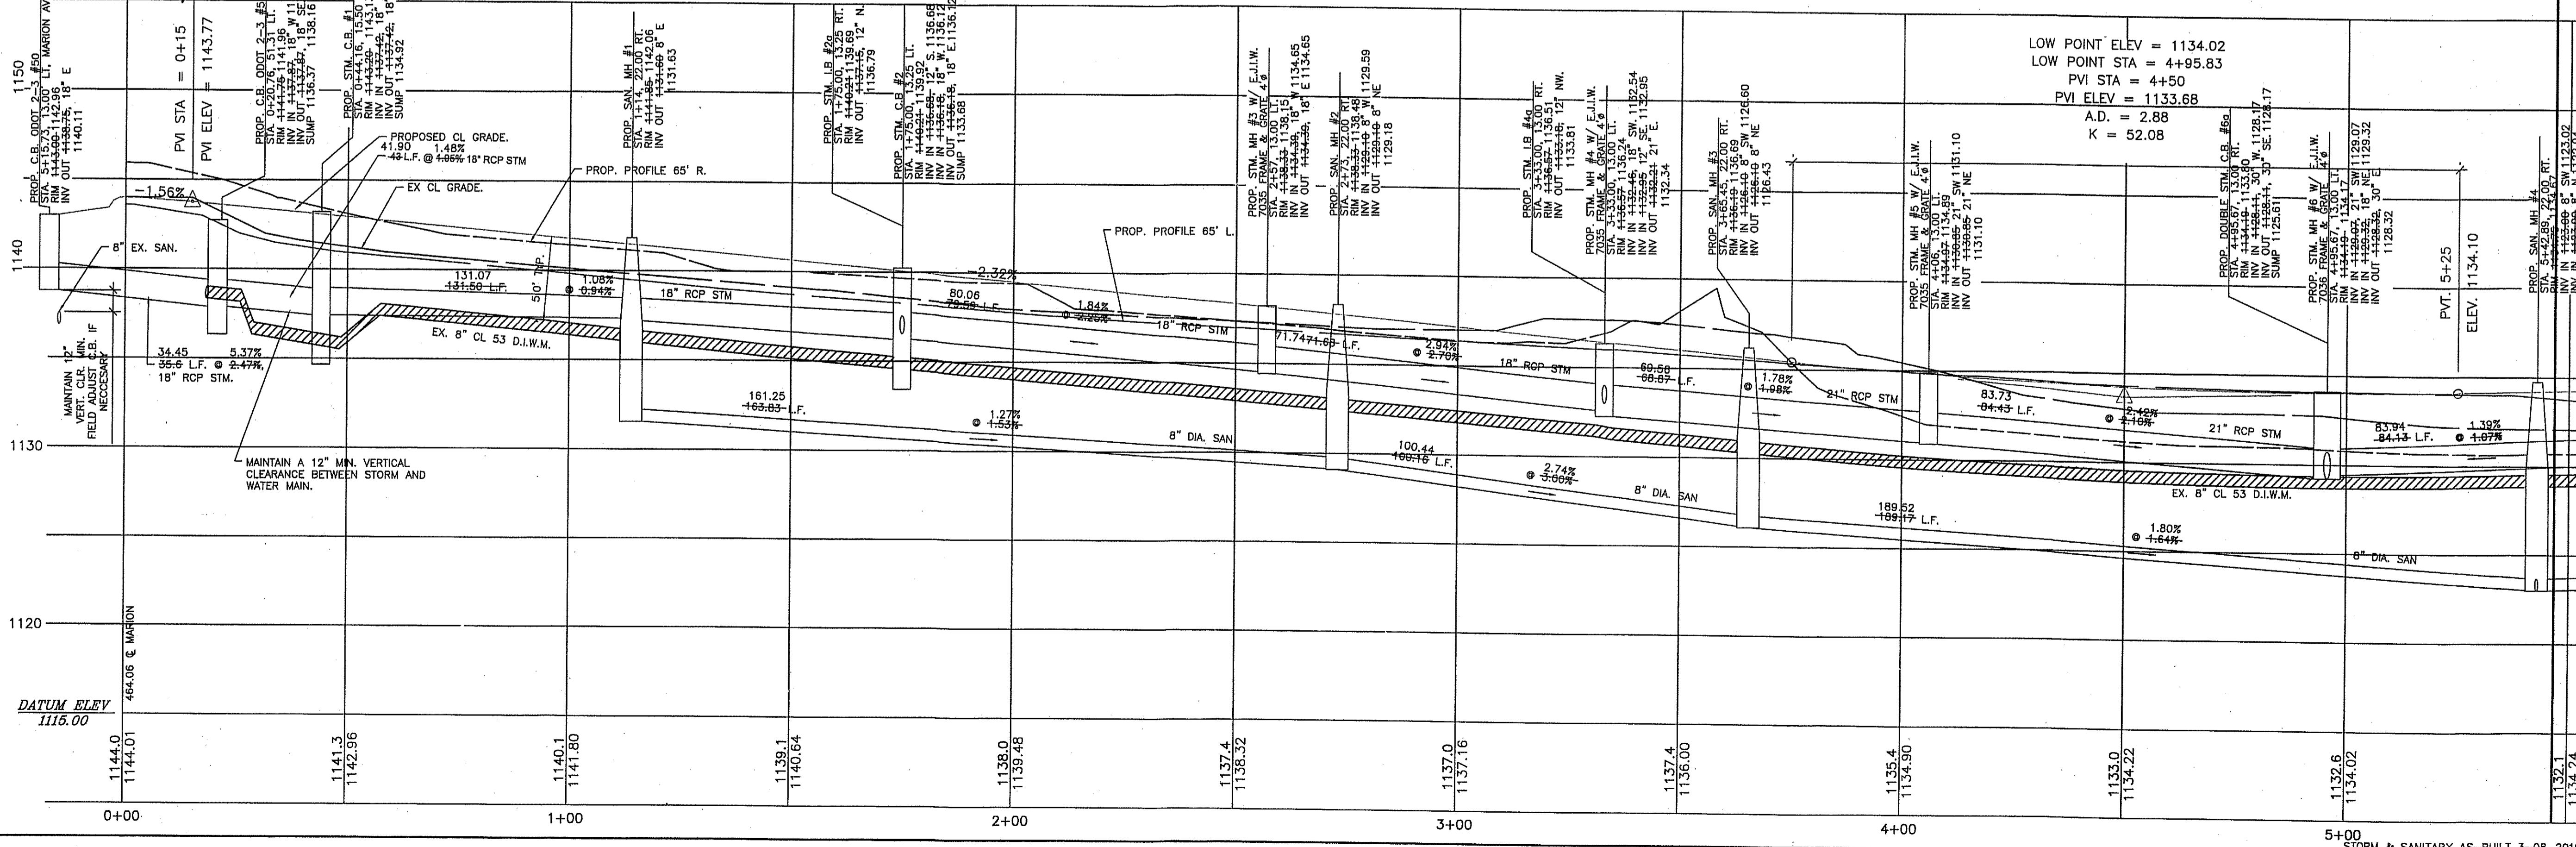

DATE	REVISION
04-29-05	COSE COMMENTS
07-19-05	SUMMIT ENG. COMMENTS
04-24-15	

DRAWN: -  
CHECKED: -  
DATE: -

SCALE: 1" = 20'  
HOR: 1" = 20'  
VER: 1" = 5'

KIDS JABER, LLC  
LIONS PARK ALIGNMENT & CONDUITINGS  
MARION AVE, SPRINGFIELD TOWNSHIP, OHIO

PLAN & PROFILE - LIONSWOOD DR.

SPAGNUOLO & ASSOCIATES, LLC  
3057 WEST MARKET STREET, SUITE 201 • FAIRBANK, OH 44333  
PHONE: (330) 836-6661 • FAX: (330) 836-6115  
EMAIL: dscoffer@spagnuoloassoc.com