

REVISIONS
7/18 PER D.S.S.S.
9/18 PER S.C.E.
9/19 UTIL. AS-BUILTS

KEY MAP
MOTTL RESERVE SUBDIVISION
PHASES 1 & 2
SAGAMORE HILLS TOWNSHIP
SUMMIT COUNTY, OHIO

DONALD G. BOHNING & ASSOCIATES, INC.
 CIVIL ENGINEERING & SURVEYING
 7979 HUB PARKWAY • VALLEY VIEW, OHIO 44125
 PHONE: (216) 842-1130 FAX: (216) 842-1132
 E-MAIL: dgb@dgba.com www.dgba.com



GRAPHIC SCALE
 0' 15' 30'

HORIZ. SCALE
 1" = 100'


VERT. SCALE
 1" = 10'

DRN: S.W. CKD: D.G.

DATE: MAY, 2018

ORDER NO.: 3750-10

2
21

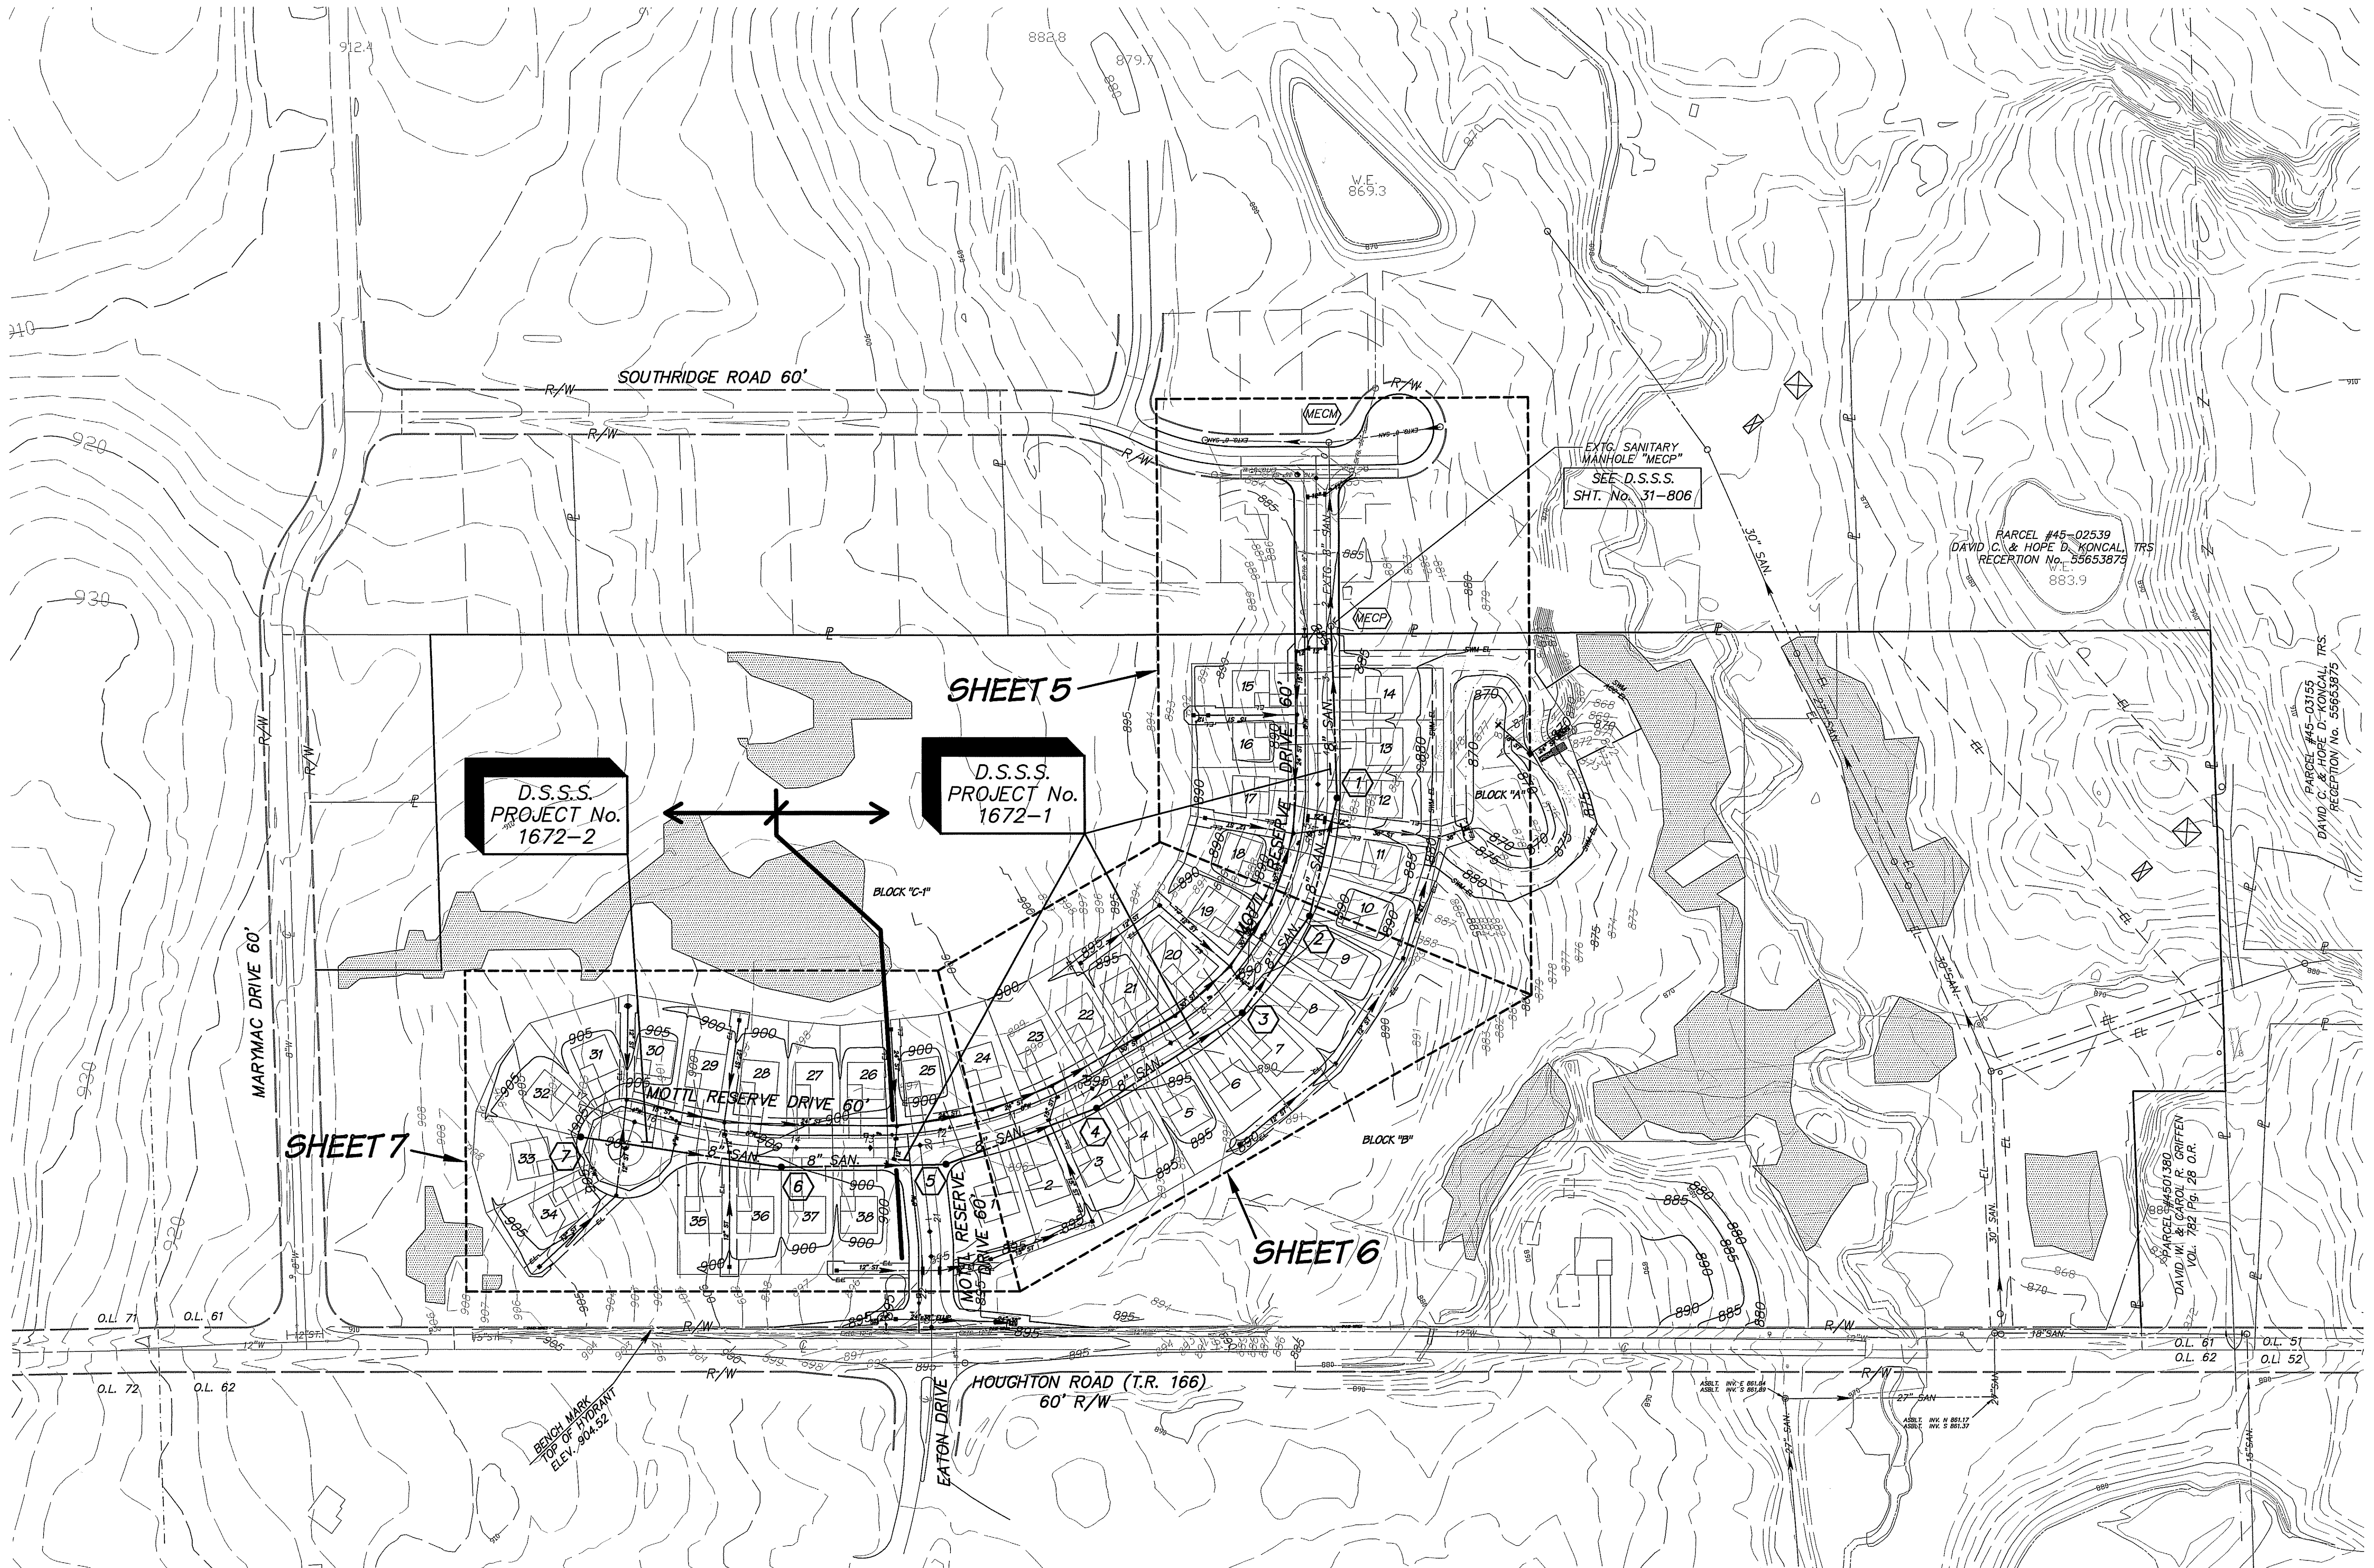

D.S.S.S.
PROJECT No.
1672-2

D.S.S.S.
PROJECT No.
1672-1

EXTG. SANITARY
 MANHOLE "MECP"
 SEE D.S.S.S.
 SHT. No. 31-806

PARCEL #45-02539
 DAVID C. & HOPE D. KONCAL, TRS
 RECEPTION No. 55653875
 883.9

PARCEL #45-03155
 DAVID C. & HOPE D. KONCAL, TRS
 RECEPTION No. 55653875

PARCEL #45-01380
 DAVID W. & CAROL R. GRIFFEN
 VOL. 782 Pgs. 28 O.R.

BENCH MARK
 TOP OF HYDRANT
 ELEV. 904.52

ASBL. INV. N 881.17
 ASBL. INV. S 881.37

ASBL. INV. E 881.40
 ASBL. INV. W 881.40