


CONNECTICUT COLONY OF HUDSON PART I
PART OF LOT 84 HUDSON TOWNSHIP SUMMIT COUNTY OHIO
MADE FOR CONNECTICUT COLONY INVESTMENT INC.

State of Ohio } SS
Summit County } Before me, a Notary Public, in and for said County and State,
personally appeared the above named John D. Peace and E.I. Peace,
who acknowledged the foregoing certificate to be their free act and
deed. In testimony whereof, I hereunto set my hand and
affixed my official seal at Akron
this 2nd day of May, 1963

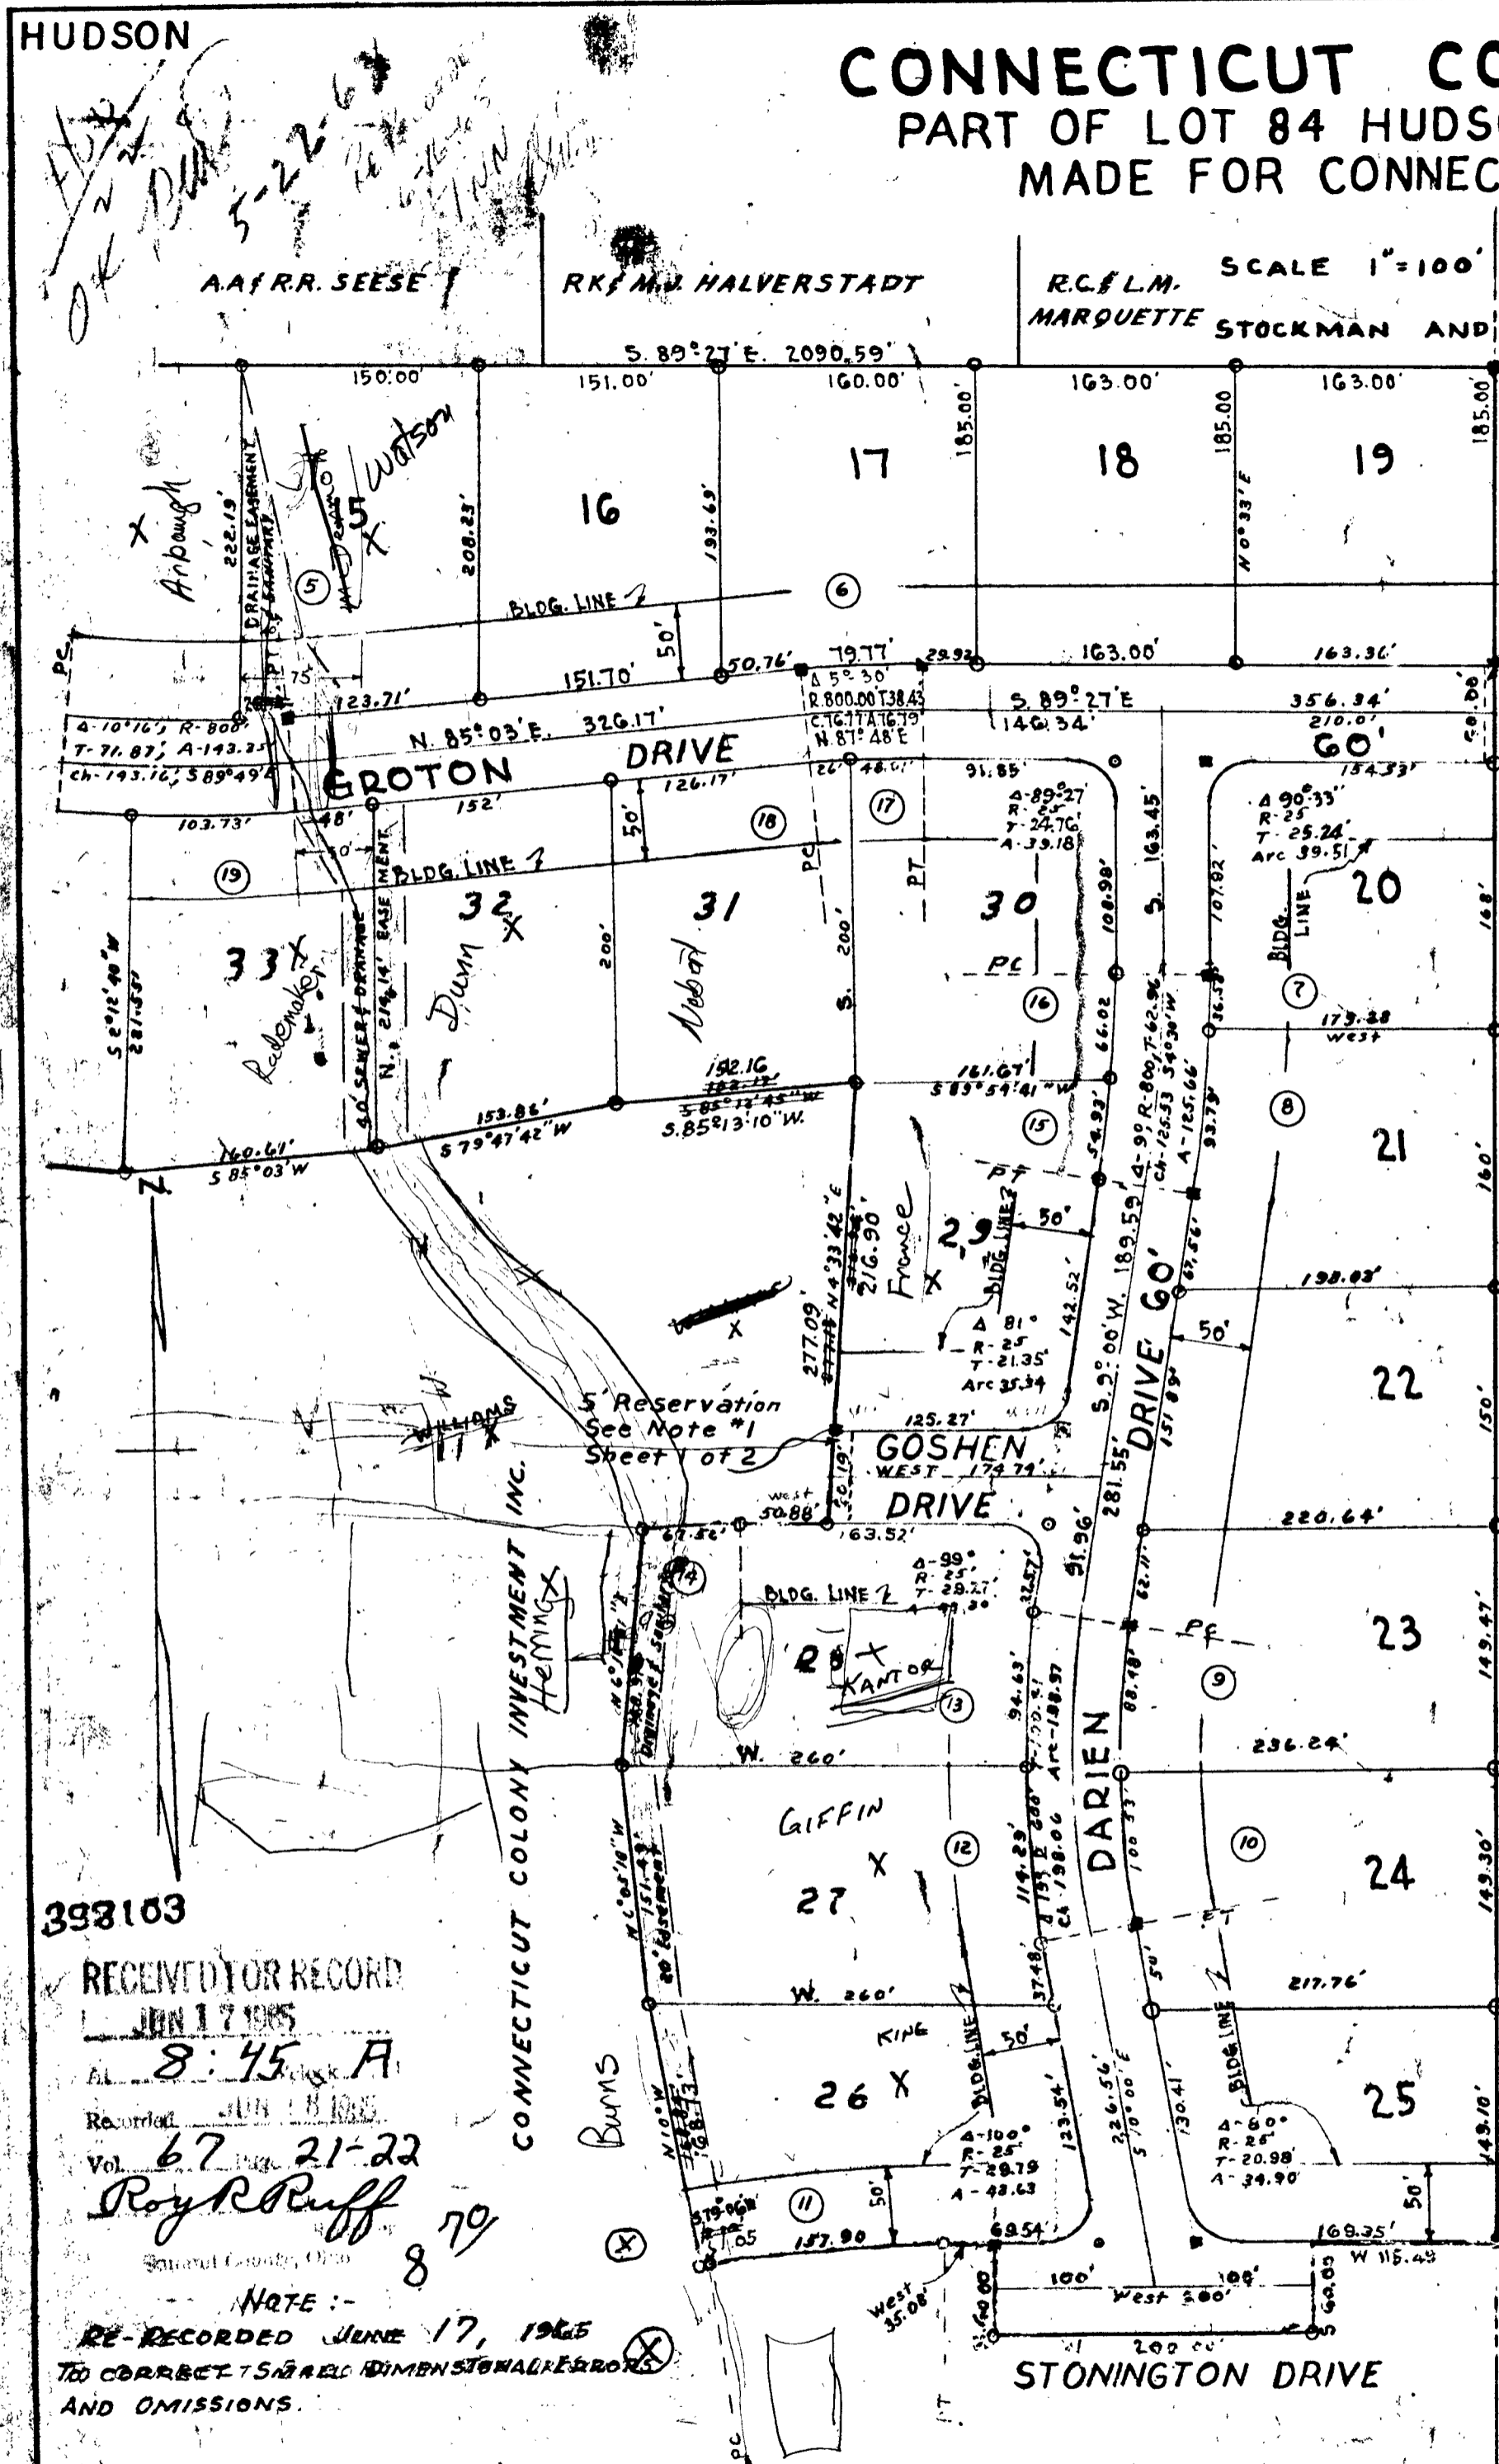

R.C.F.L.M. SCALE 1"=100'
MARQUETTE STOCKMAN AND ASSOCIATES

MARCH 1963
KENT, OHIO

I hereby certify that I have surveyed the land shown on this plat, that this plat is a correct representation of the land surveyed and the subdivision thereof; and that I have found or set the pins and monuments shown on this plat, and that this allotment complies with all existing Township Zoning Regulations.

Walter J. Stockman
Registered Surveyor #1976

RESTRICTIONS.
Restrictions to conform with Township Zoning Ordinances and as encompassed in deeds.

Approved by the Summit County Planning Commission
this 16th day of MAY 1963
Richard Longwell Chairman
Neil Weaver Executive Secretary-Engineer

Pursuant to section 5553.31 revised code the Board of County Commissioners of Summit County, Ohio, does hereby approve this record plat; and does hereby dedicate and establish the streets, roads and public ways shown thereon; and does accept for public use the same, and the easements shown thereon,
this 21st day of MAY 1963

Summit County Commissioners:

John Poda
Joseph Brundage
Walter

Approved by the trustees of Hudson Township
this 9 day of April 1963

Trustees

Morris L. Boyd
Chas. F. Finkston
Ronald C. Barlow

317659

RECEIVED FOR RECORD
MAY 22 1963

12:03 P.M.

Received for transfer 63 Page 41-47

Received for record Ralph

Transferred Summit County Ohio

Recorded By: Ralph Jones

Plat Book Dep. Clerk Page

8.70

State of Ohio } SS
Summit County } Before me, a notary public, in and for said county and state, personally appeared the above named W. J. Stockman, who acknowledged the foregoing certificate to be his free act and deed. In testimony whereof, I hereunto set my hand and affixed my official seal at
this first day of May 1963

Marion J. Hinger
MARION J. HINGER Notary Public

MY COMMISSION EXPIRES Nov. 30, 1966
We the undersigned Connecticut Colony Investment Inc. (Owners), and John D. Peace, E.I. Peace, and Second Federal Savings and Loan Association of Cleveland (Mortgagees) of the lands embraced within this subdivision hereby acknowledge this plat and subdivision to be our free act and deed and do hereby dedicate to public use forever the streets, easements and parks shown on this plat.

John D. Peace
E.I. Peace
Geneva Poli
John Boyman
R.E. Stockman
Elizabeth Baker
Robert H. Kinchen
WITNESSES

CONNECTICUT COLONY INVESTMENT INC.
John Ottenstein (PRES.)
John Ottenstein (Secy.)
Donald J. Math
Robert A. Derry
OWNERS

State of Ohio } SS
Summit County } Before me, a notary public in and for said county and state, personally appeared Connecticut Colony Investment Inc. by John Ottenstein its president, and John Ottenstein its secretary, who being duly to execute the foregoing instrument and to sign this plat acknowledged the making of the foregoing instrument and the signing of this plat to be their free act and deed, and the voluntary act and deed of the Connecticut Colony Investment Inc.

In testimony where of I have hereunto set my hand official seal at Summit Hudson, Ohio
this first day of May 1963

Marion J. Hinger
MARION J. HINGER Notary Public
MY COMMISSION EXPIRES Nov. 30, 1966

SEAL
NOTARIZING
SIGNATURE
OF WALTER
J. STOCKMAN
MARION J.
HINGER
NOTARY PUBLIC

393103
RECEIVED FOR RECORD
Vol. 67 pg. 21-22
Roy R. Buff
Summit County, Ohio

NOTE:-
RE-RECORDED JUNE 17, 1965
TO CORRECT SMALL DIMENSIONAL ERRORS
AND OMISSIONS.

State of Ohio } SS
Cuyahoga County } Before me, a Notary Public, in and for said County and State,
personally appeared the above named Second Federal Savings and Loan Assoc. of Cleveland,
by Robert E. Berry President and Ronald J. Math Secretary,
who acknowledged the foregoing certificate to be their free act of deed and
the free act of deed of said Association. In testimony whereof, I
hereunto set my hand & seal at Cleveland, Ohio this 10th day of
May, 1963.
Robert H. Kinchen Gilbert H. Kinchen