

**CENTERLINE SURVEY OF
ARROW LAKE ESTATES No 2 & 3
TO RE-SET CENTERLINE MONUMENTATION
DESTROYED IN PAVING PROJECT.**


**BELLE MEADE ROAD, 50' RW
ARROWHEAD TRAIL, 50' RW
KINDIG SPUR, 50' RW**

**ARROW LAKE ESTATES No. 2: PLAT BOOK. 69, PGS 51-52
ARROW LAKE ESTATES No. 3: PLAT BOOK. 74 PG. 45**

STATE OF OHIO, COUNTY OF SUMMIT, COPLEY TOWNSHIP

Arrow Lake Estates Survey Report

The Copley Township Trustees requested the Summit County Engineer to re-establish the centerline monuments that were inadvertently destroyed during a paving project of the streets of Arrow Lake Estates. Property corners along the right of way were recovered. Then a traverse, tied to the Ohio State Plane Coordinate System, was conducted to accurately determine their positions. An analysis of these points was performed to reconcile the record plat angles and distances with actual monumentation and to recreate the "best fit" centerlines of the affected streets. With the centerlines determined, cotton gin spindles were set in the pavement at intersections, points of curvature, angle points, and points of tangency, for a total of 28 centerline monuments.

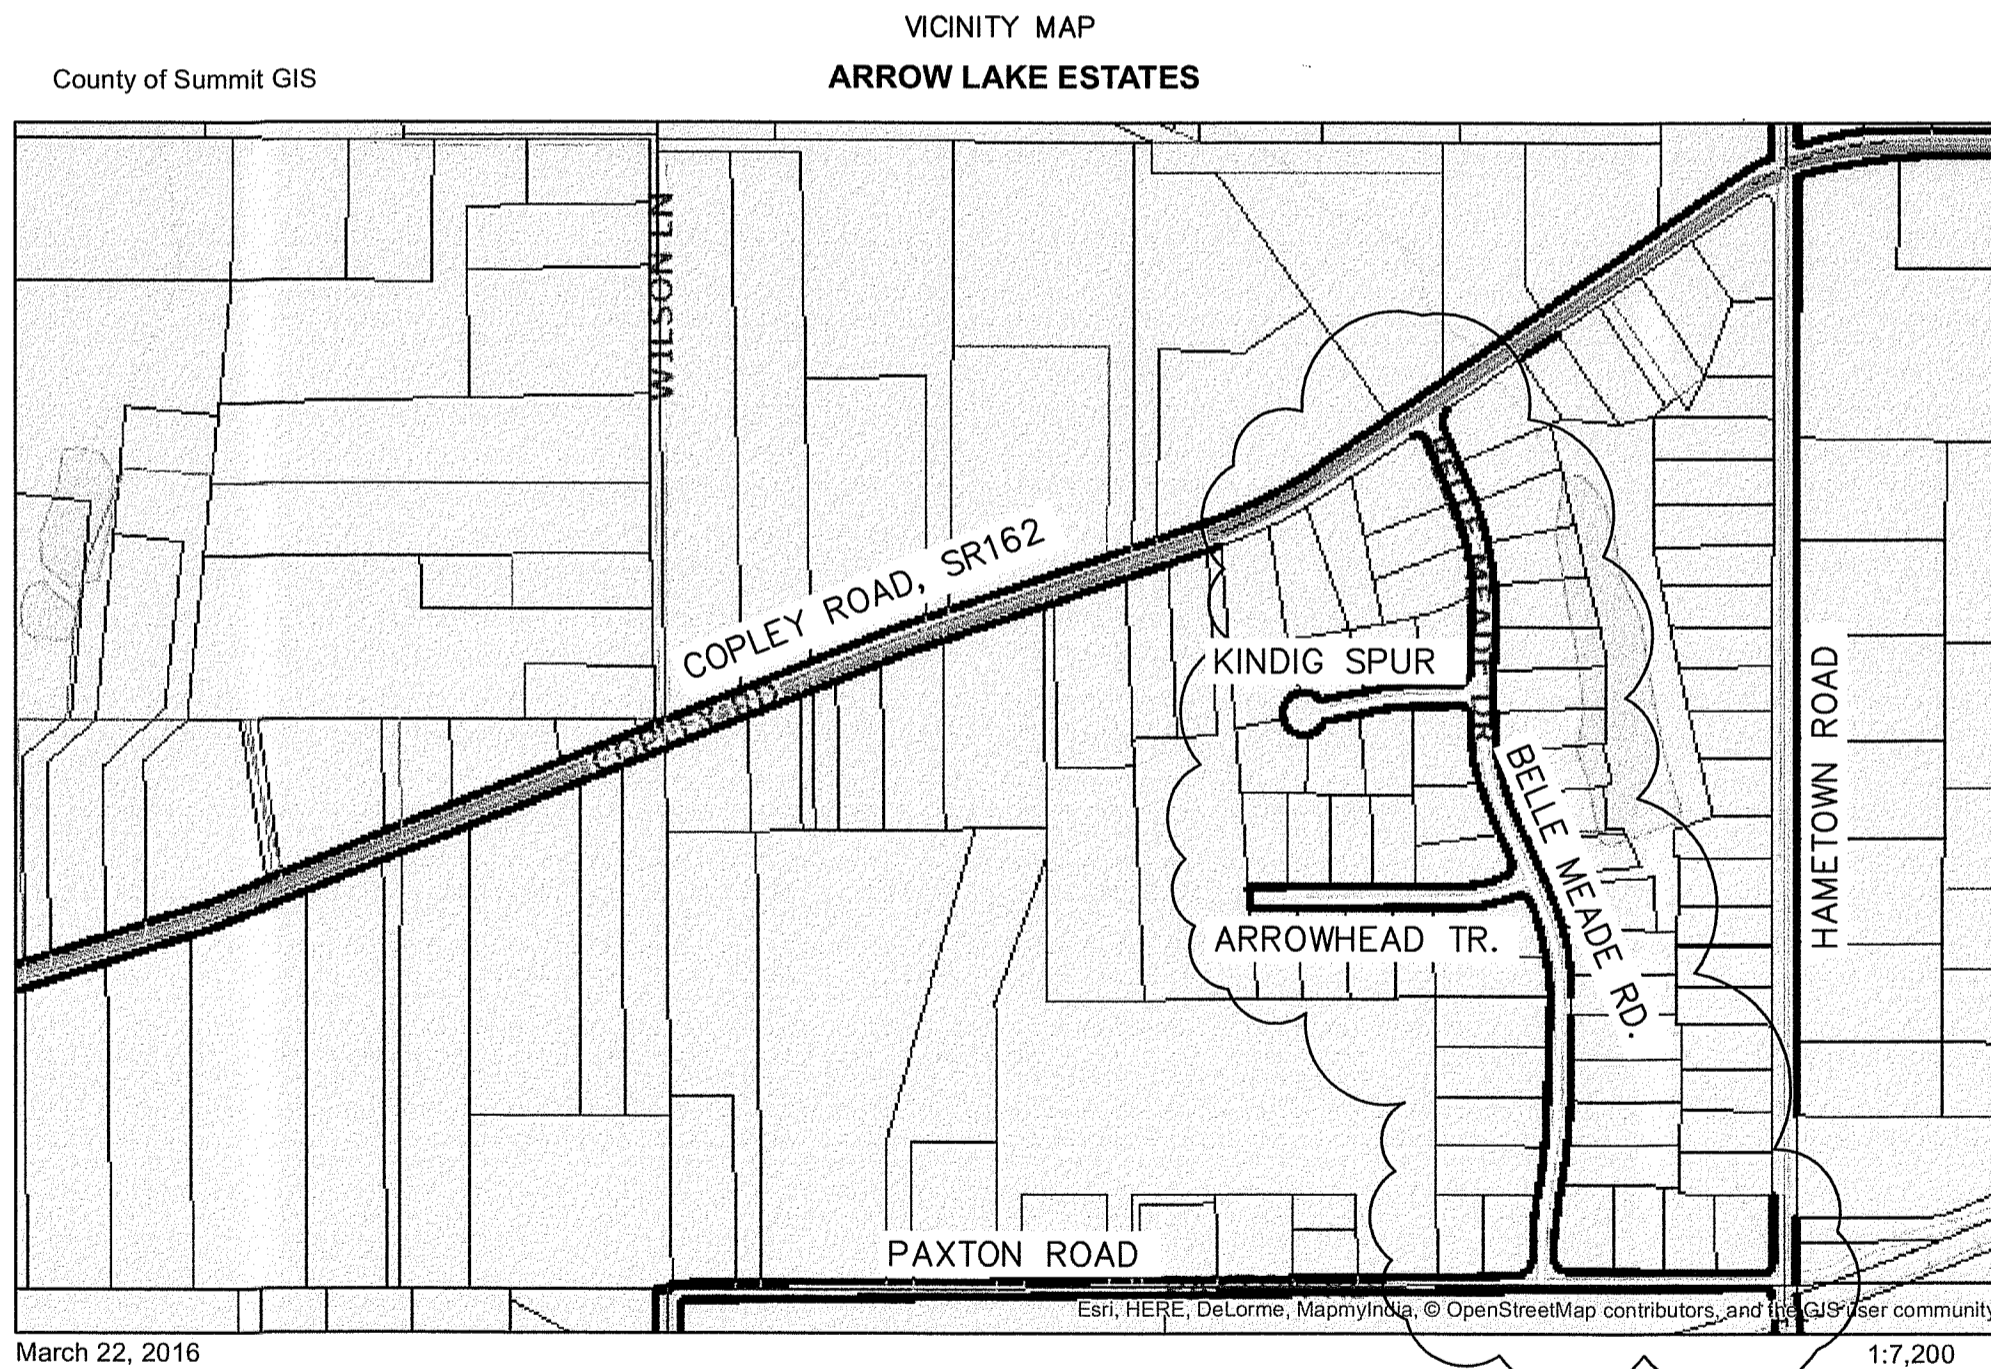

Approved by:

Alan Brubaker 3/29/2017
 Alan Brubaker, P.E., P.S., Date
 Summit County Engineer

Walter J. Schostak 3/29/2017
 Walter J. Schostak, P.S. 7903 Date

Surveyor for Alan Brubaker, P.E., P.S.,
 Summit County Engineer



Field work performed January of 2016.
 Centerline points set February of 2016.

TNN
 Plat Approved By
 3/20/17 GIS *K. Phelps*

Prepared by:
 Alan Brubaker, P.E., P.S.
Summit County Engineer
 538 E. South St.
 Akron, OH 44311-1843
 Tele: (330) 643-2850
 Fax: (330) 762-7829
 Website: www.summitengineer.net

G:\C3D\16002 Arrow Lake Est\16002 Plat\Bearing.dwg, 03/27/2017 10:50:09 AM