


BENCHMARK:


EXISTING INVERT (12" NW) SAN. M.H. "T.A.L.X."
TWINSBURG ROAD STA. 24+06.81, 25.68 RT.

EX INV. ELEV. 964 07-12'NW

**36127
VOID**

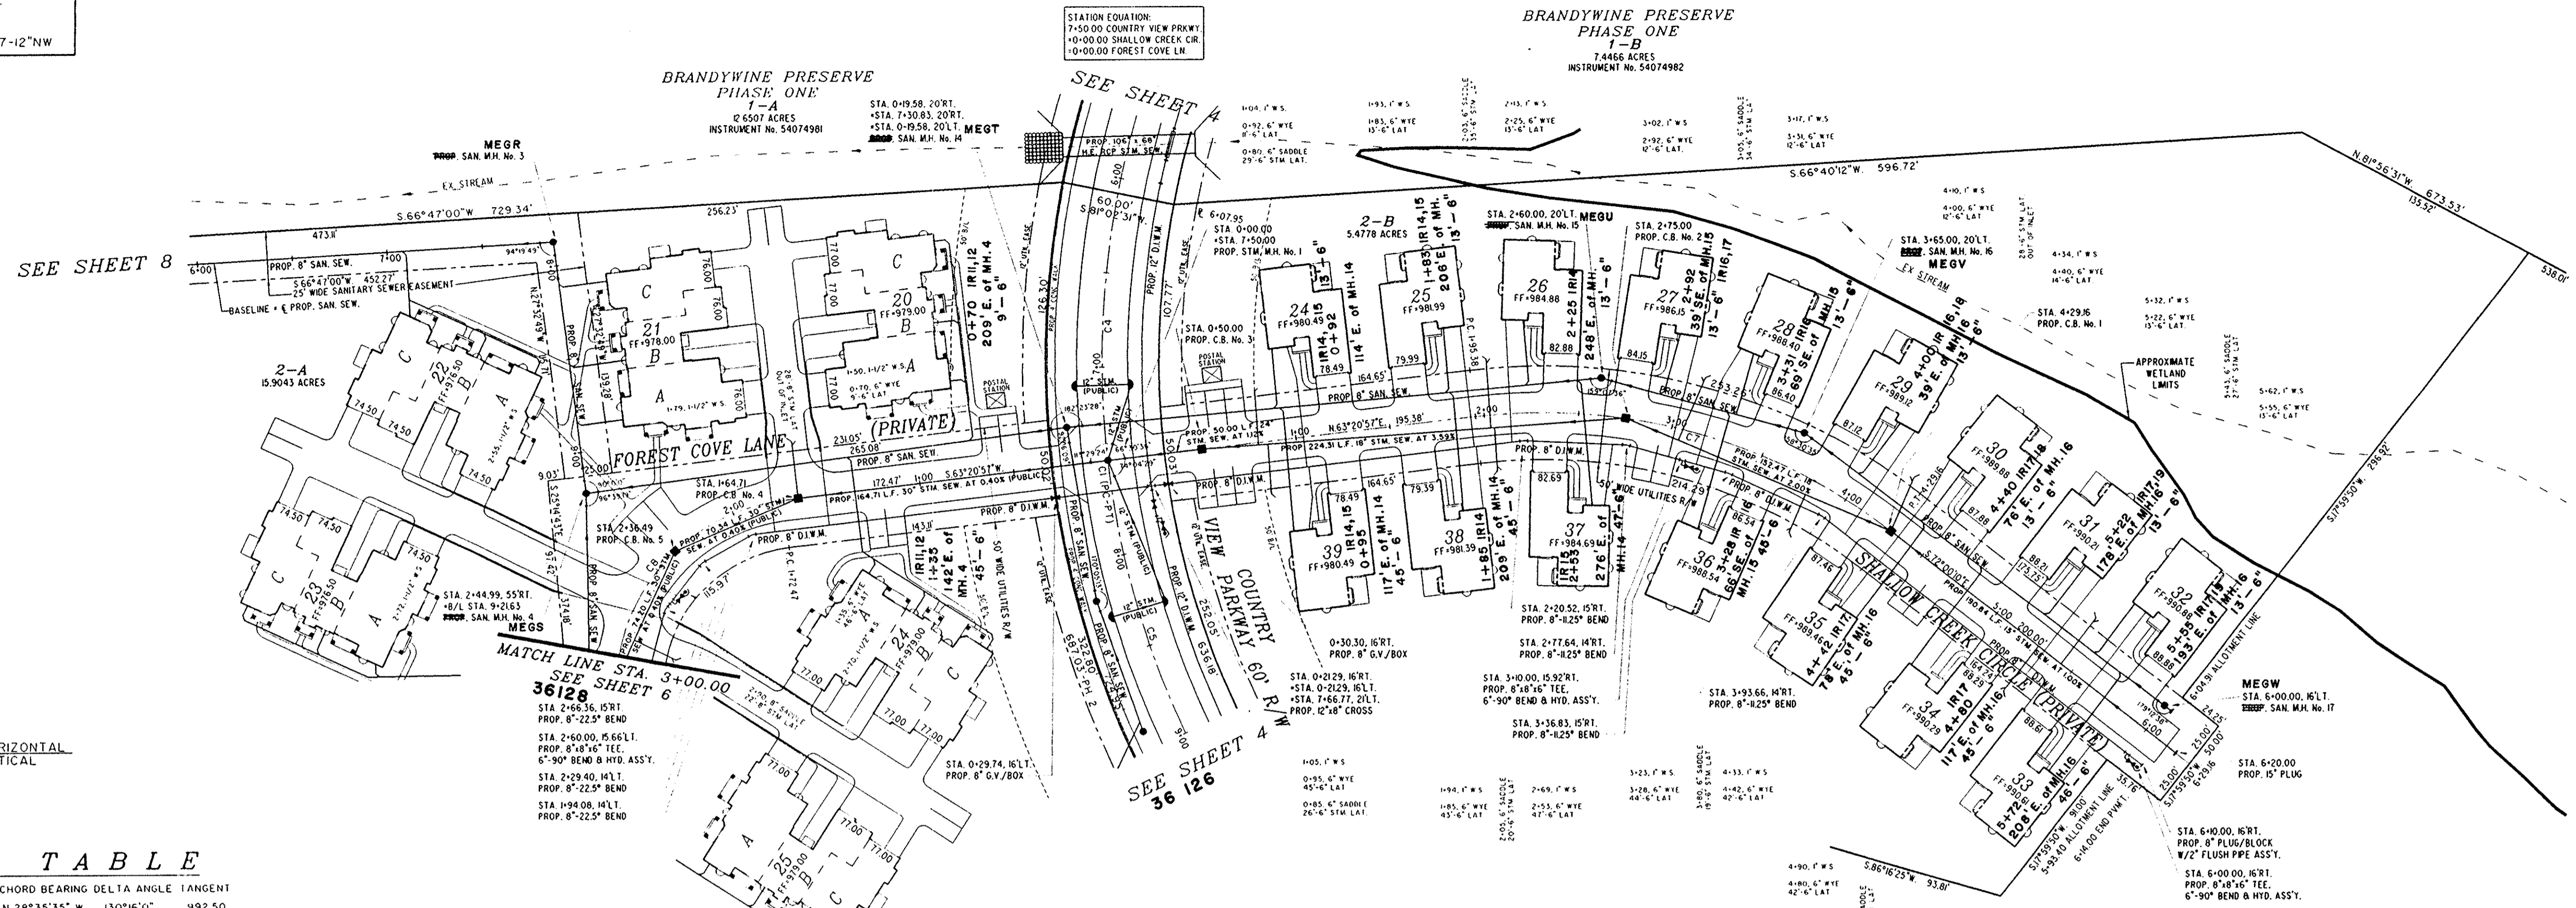

NOTE: SEE SHEET 9 FOR NOTES AND DETAILS CONCERNING SANITARY SEWER LATERALS, STORM SEWER LATERALS, AND WATER SERVICE CONNECTIONS.

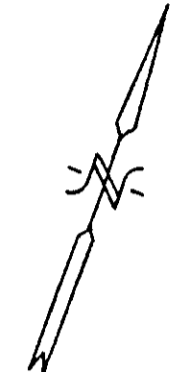


SCALE: 1" = 50' HORIZONTAL
1" = 5' VERTICAL

CURVE TABLE

CURVE#	RADIUS	LENGTH	CHORD	CHORD BEARING	DELTA ANGLE	TANGENT
(P.C. TO P.T.) C1	460.00	1045.85	834.71	N 26°35'35" W	130°16'0"	992.50
C4	460.00	142.05	141.48	N 17°48'16" W	17°41'33"	71.59
C5	460.00	350.00	341.62	N 40°26'53" W	43°35'41"	183.96
C7	300.00	233.78	227.91	N 85°40'24" E	44°38'53"	123.19
C8	100.00	154.63	139.68	N 19°03'07" E	68°35'41"	71.58

*** CLEARANCE NOTE ***
RAISE PROP. 6" DI WATER MAIN TO 5'-0" MINIMUM COVER AT 6" SANITARY LATERAL CROSSING AND MAINTAIN 18" MIN. CLEARANCE WHERE THEY CROSS. (SEE PROFILE)

VOID

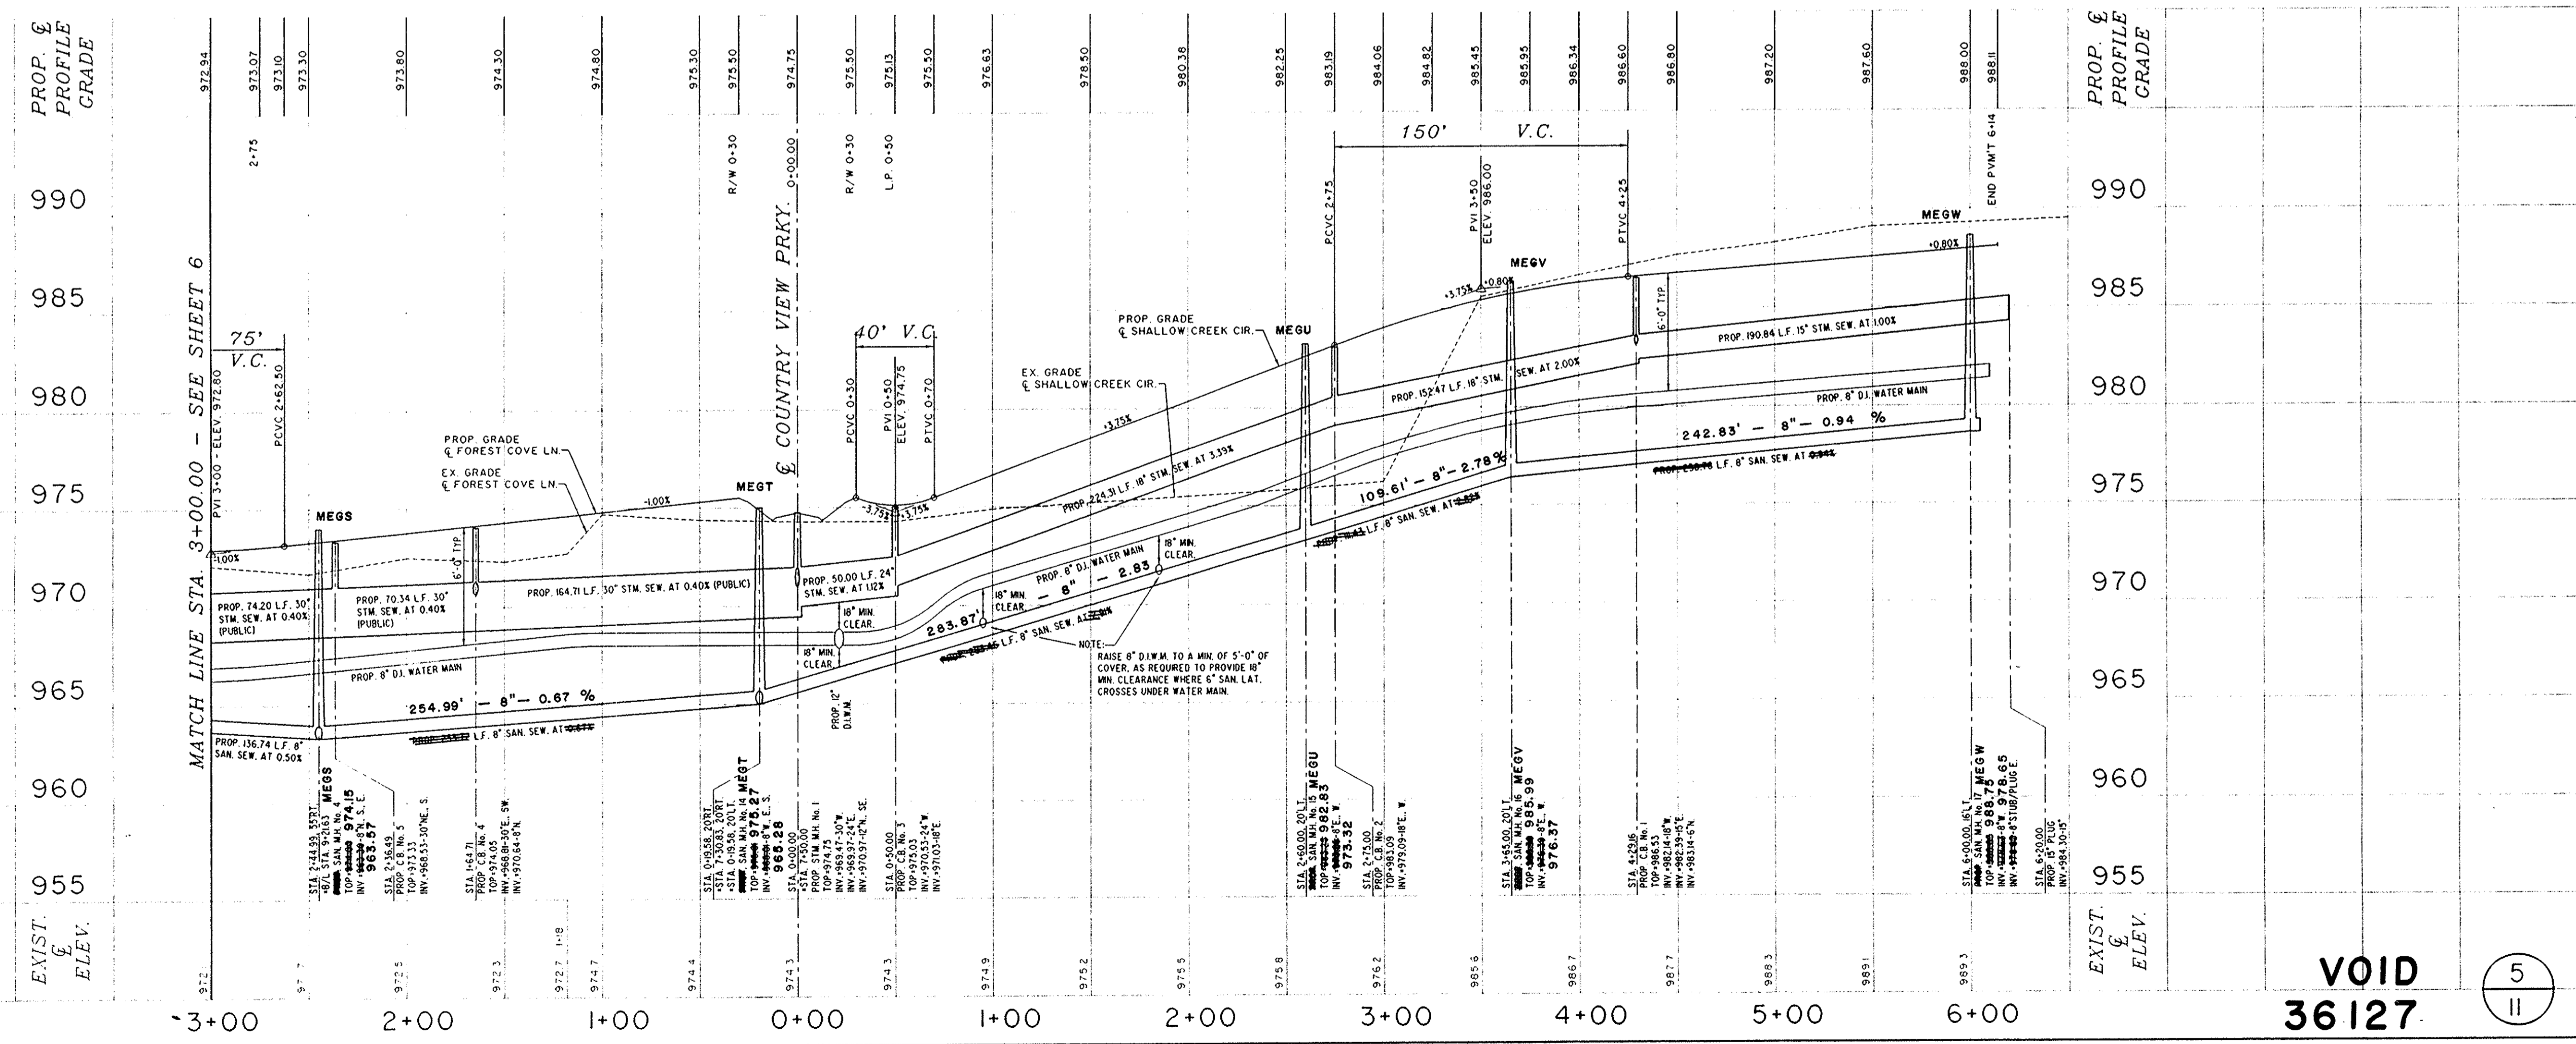

**VOID
36127**

5
11

FOREST COVE LANE (PRIVATE) STA. 0+00.00 - STA. 3+00.00 / SHALLOW CREEK CIRCLE (PRIVATE) STA. 0+00.00 - STA. 6+29.16