
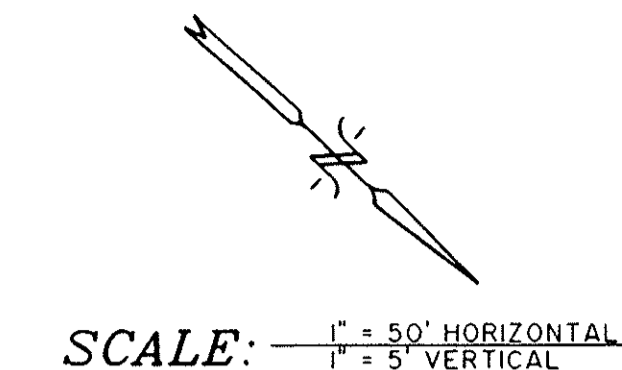


BENCHMARK:
 EXISTING INVERT (12" NW.) SAN. M.H. "T.A.L.X."
 TWINSBURG ROAD STA. 24+06.81, 25.68'RT.

EX INV. ELEV. 964.07-12"NW.

36 128
VOID

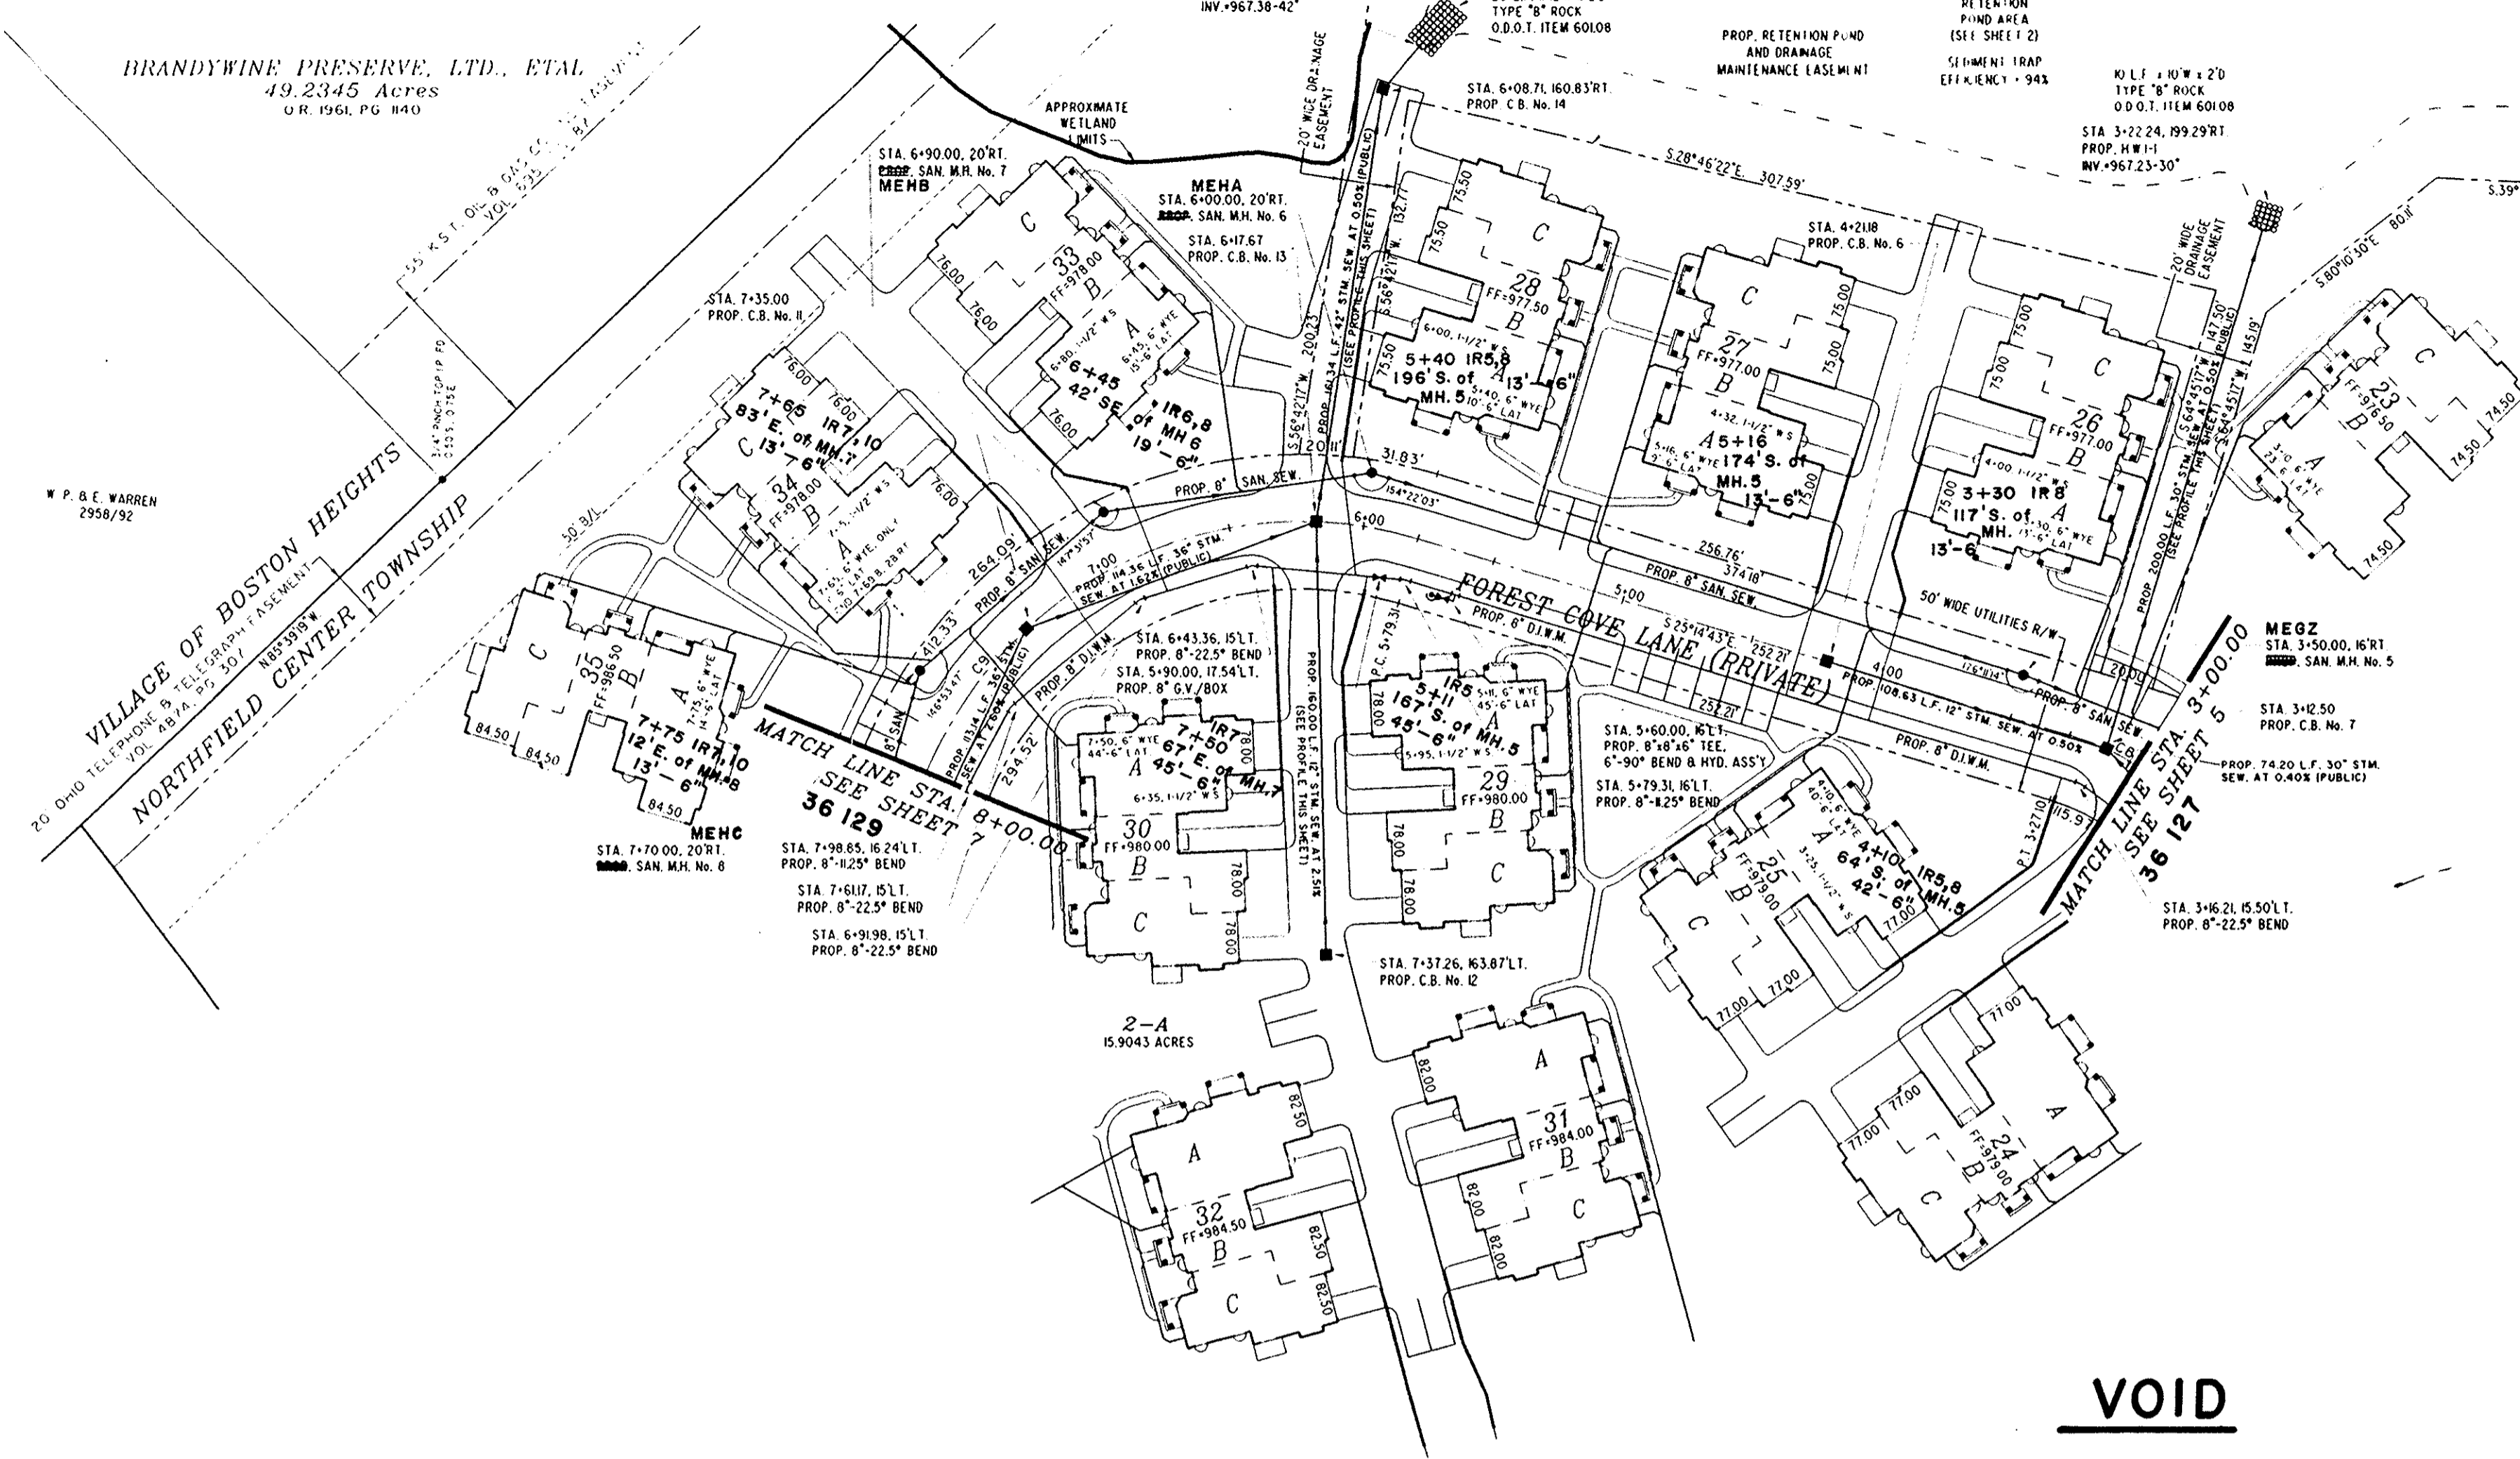


NOTE: SEE SHEET 9 FOR NOTES AND DETAILS CONCERNING SANITARY SEWER LATERALS, STORM SEWER LATERALS, AND WATER SERVICE CONNECTIONS.

CURVE TABLE



CURVE #	RADIUS	LENGTH	CHORD	CHORD BEARING	DELTA ANGLE	TANGENT
C8	100.00	154.63	139.68	N 19°03'07" E	88°35'41"	97.58
C9	150.00	353.43	277.16	S 87°15'17" W	135°0'0"	362.13

VOID

PROP. 42" STM. SEW. OUTLET PROFILE BETWEEN BUILDINGS 28 and 33

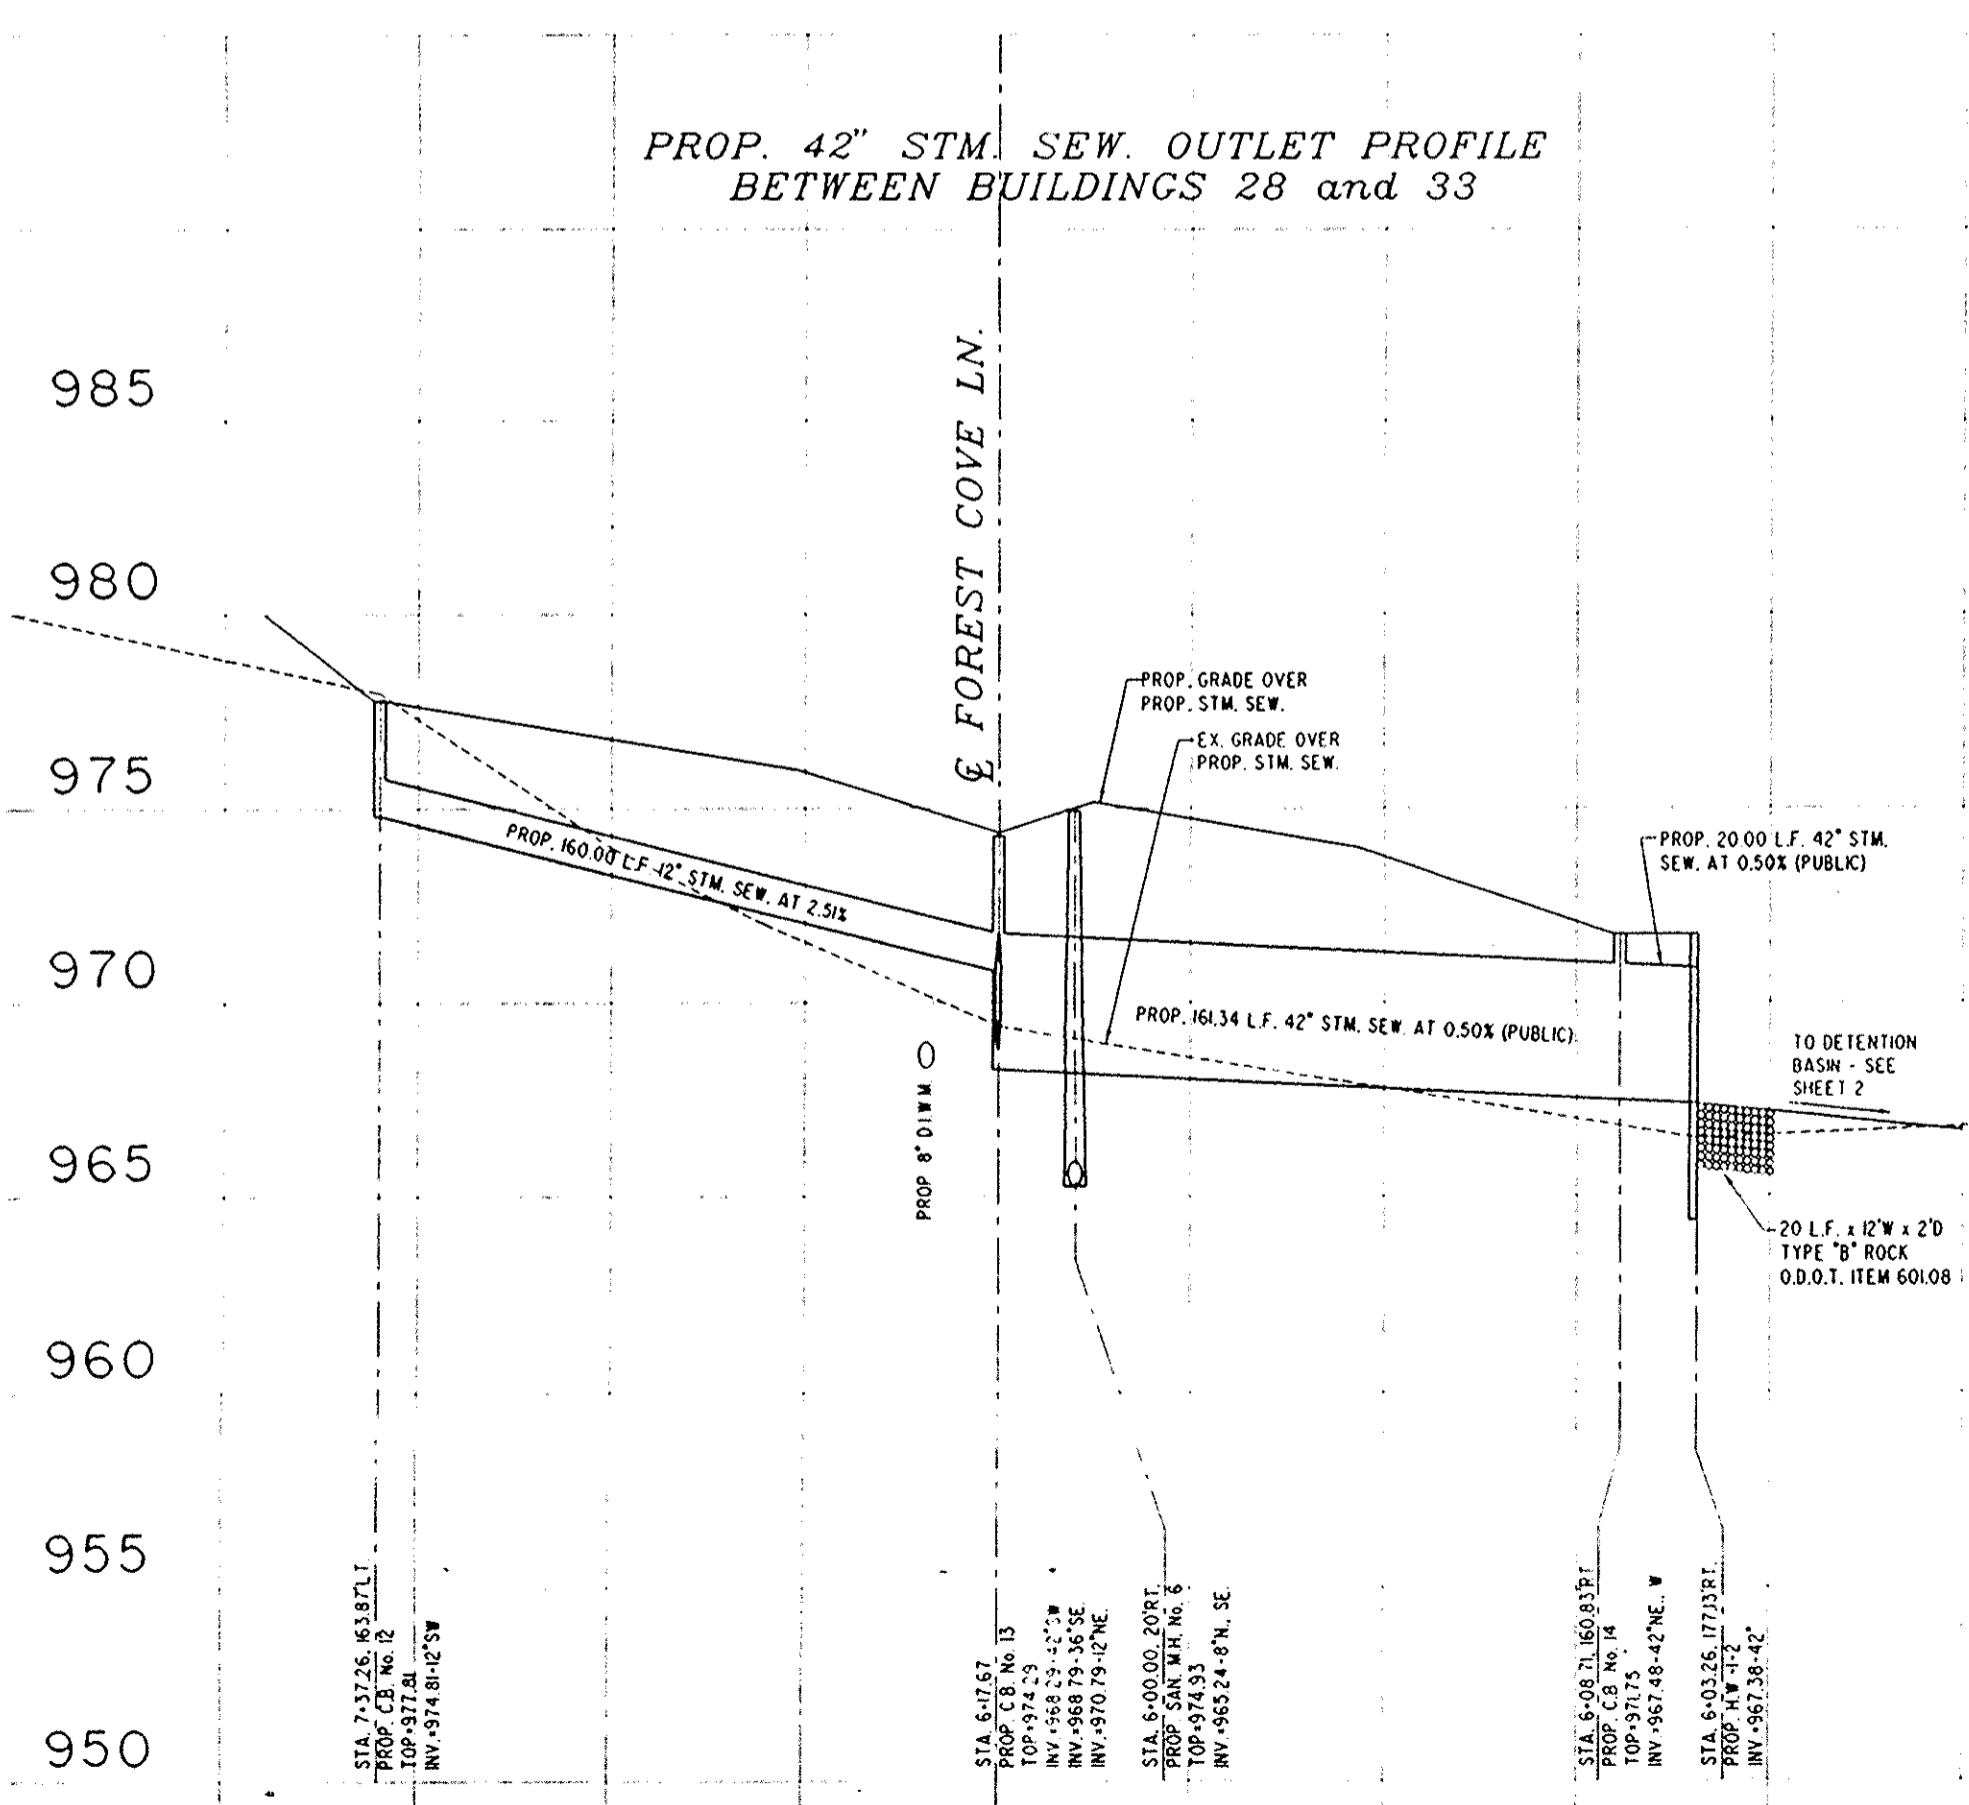

PROP. 30" STM. SEW. OUTLET PROFILE BETWEEN BUILDINGS 23 and 26

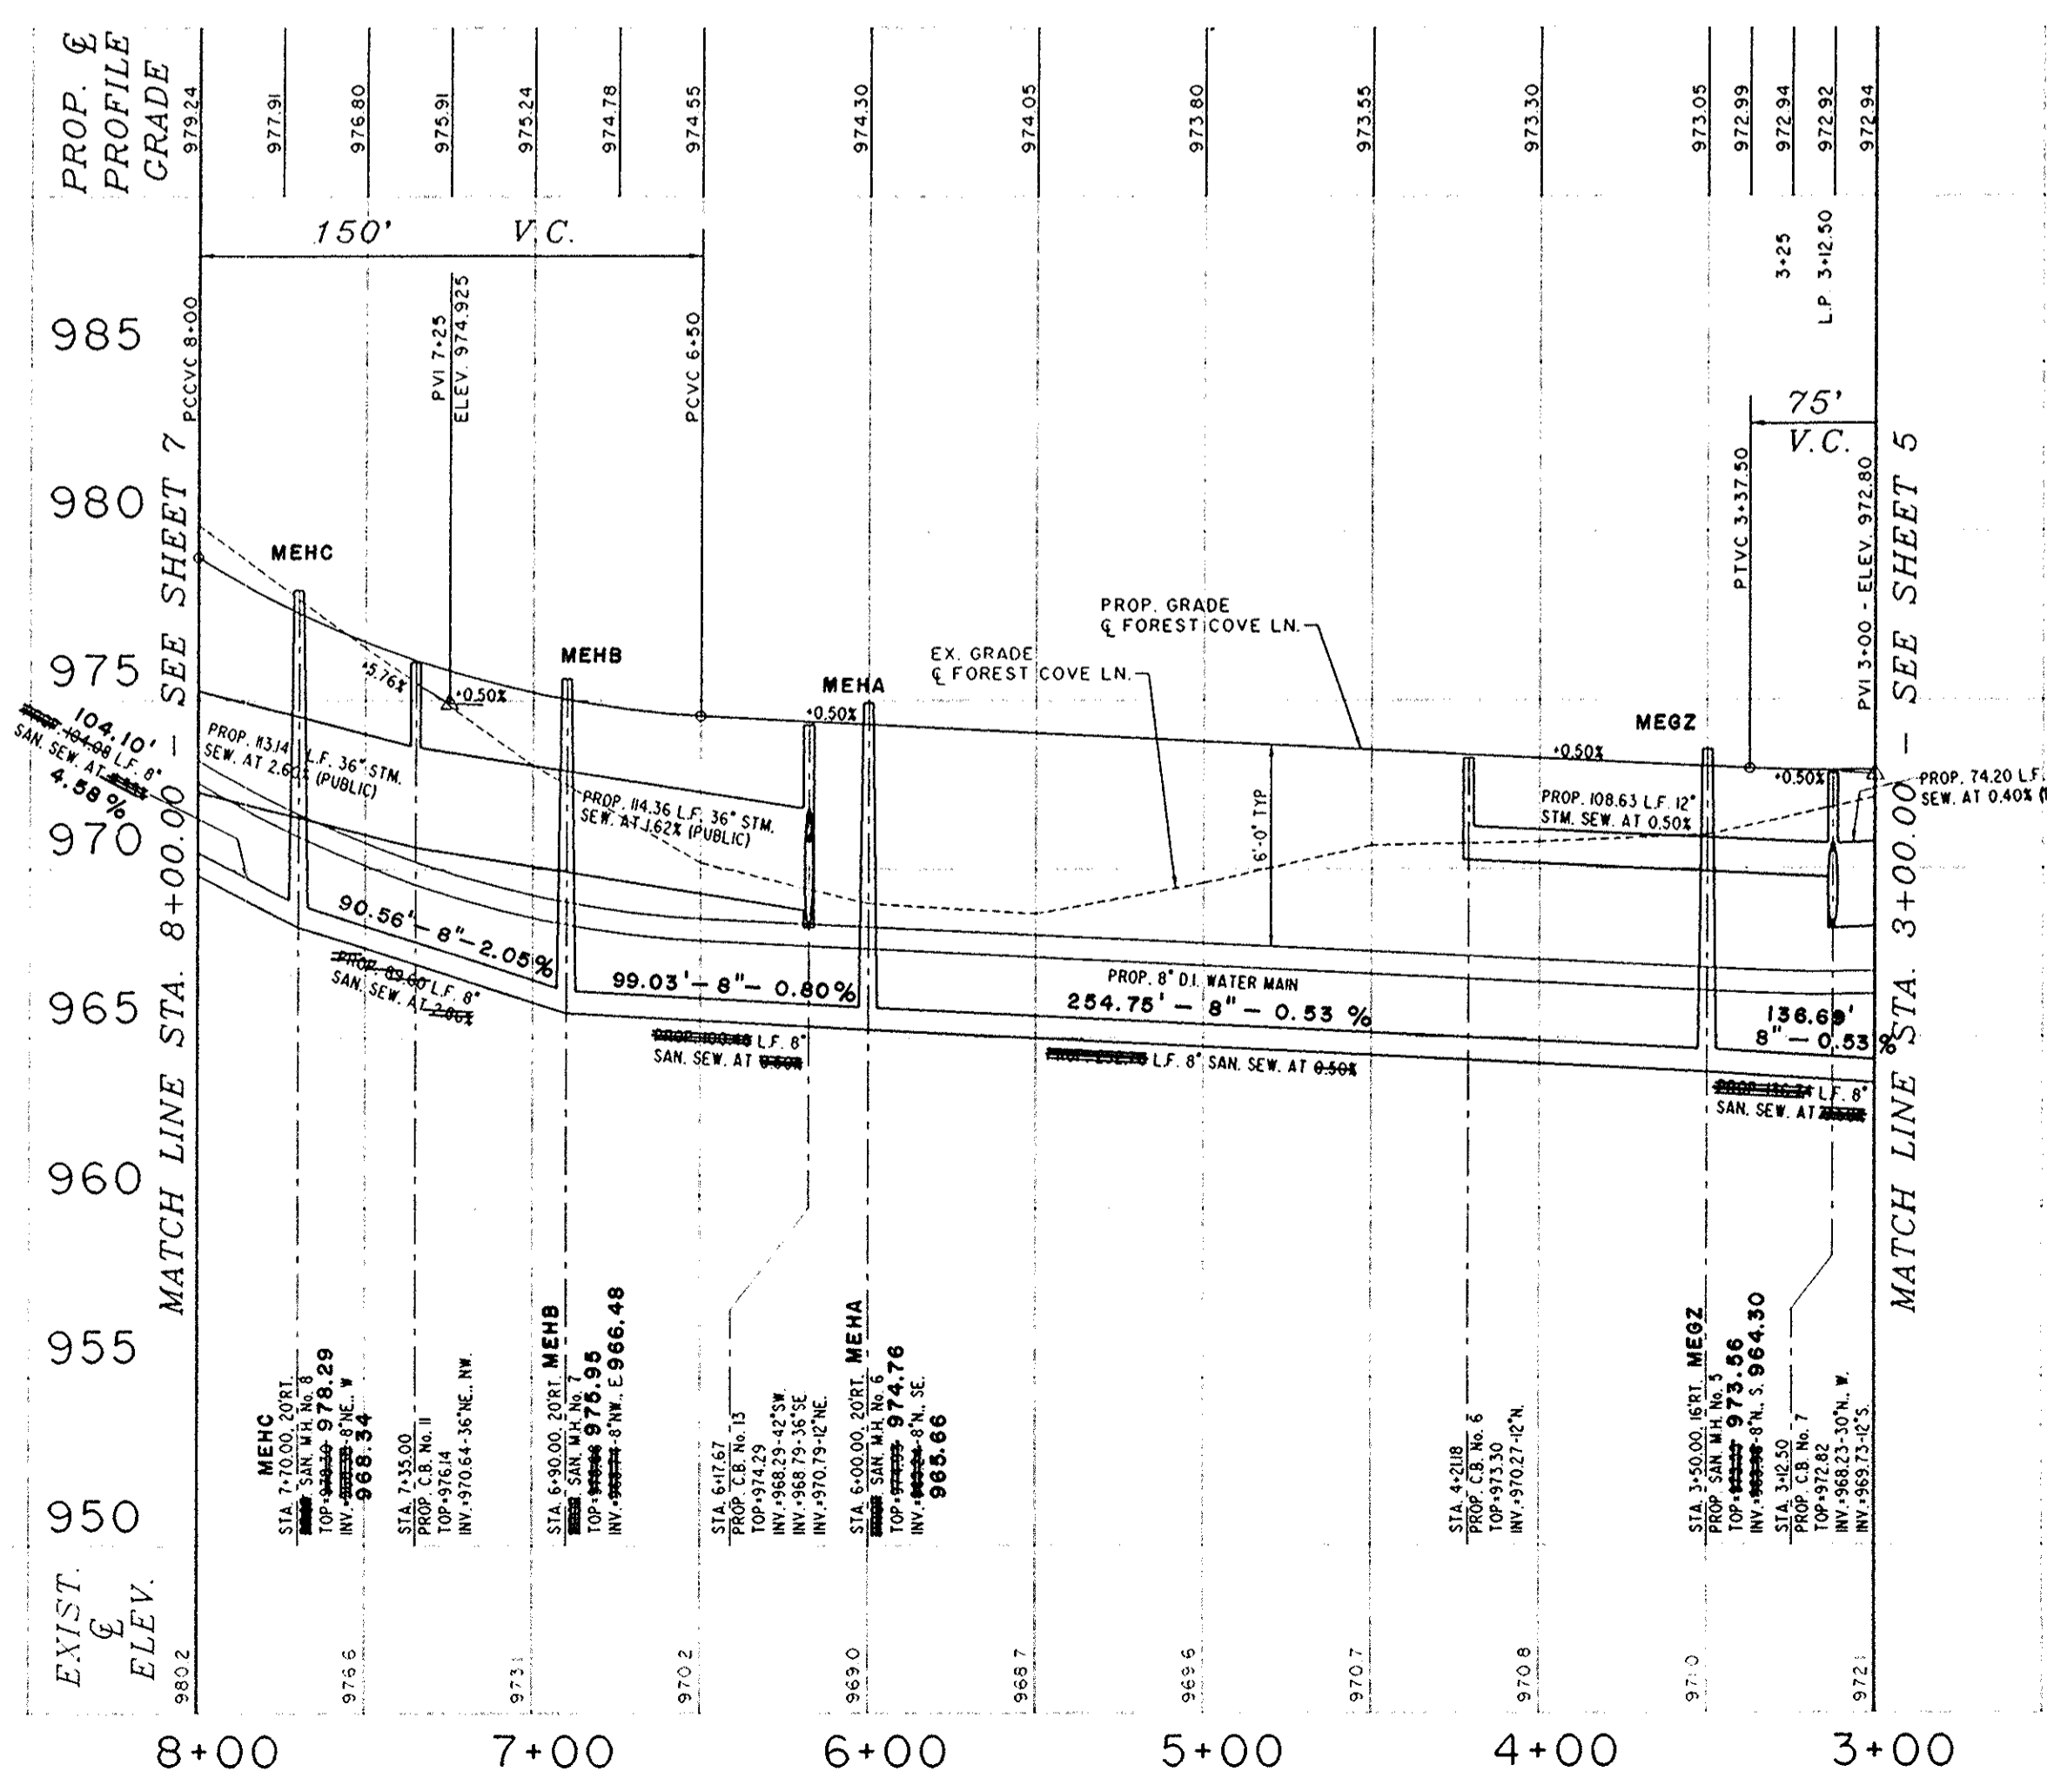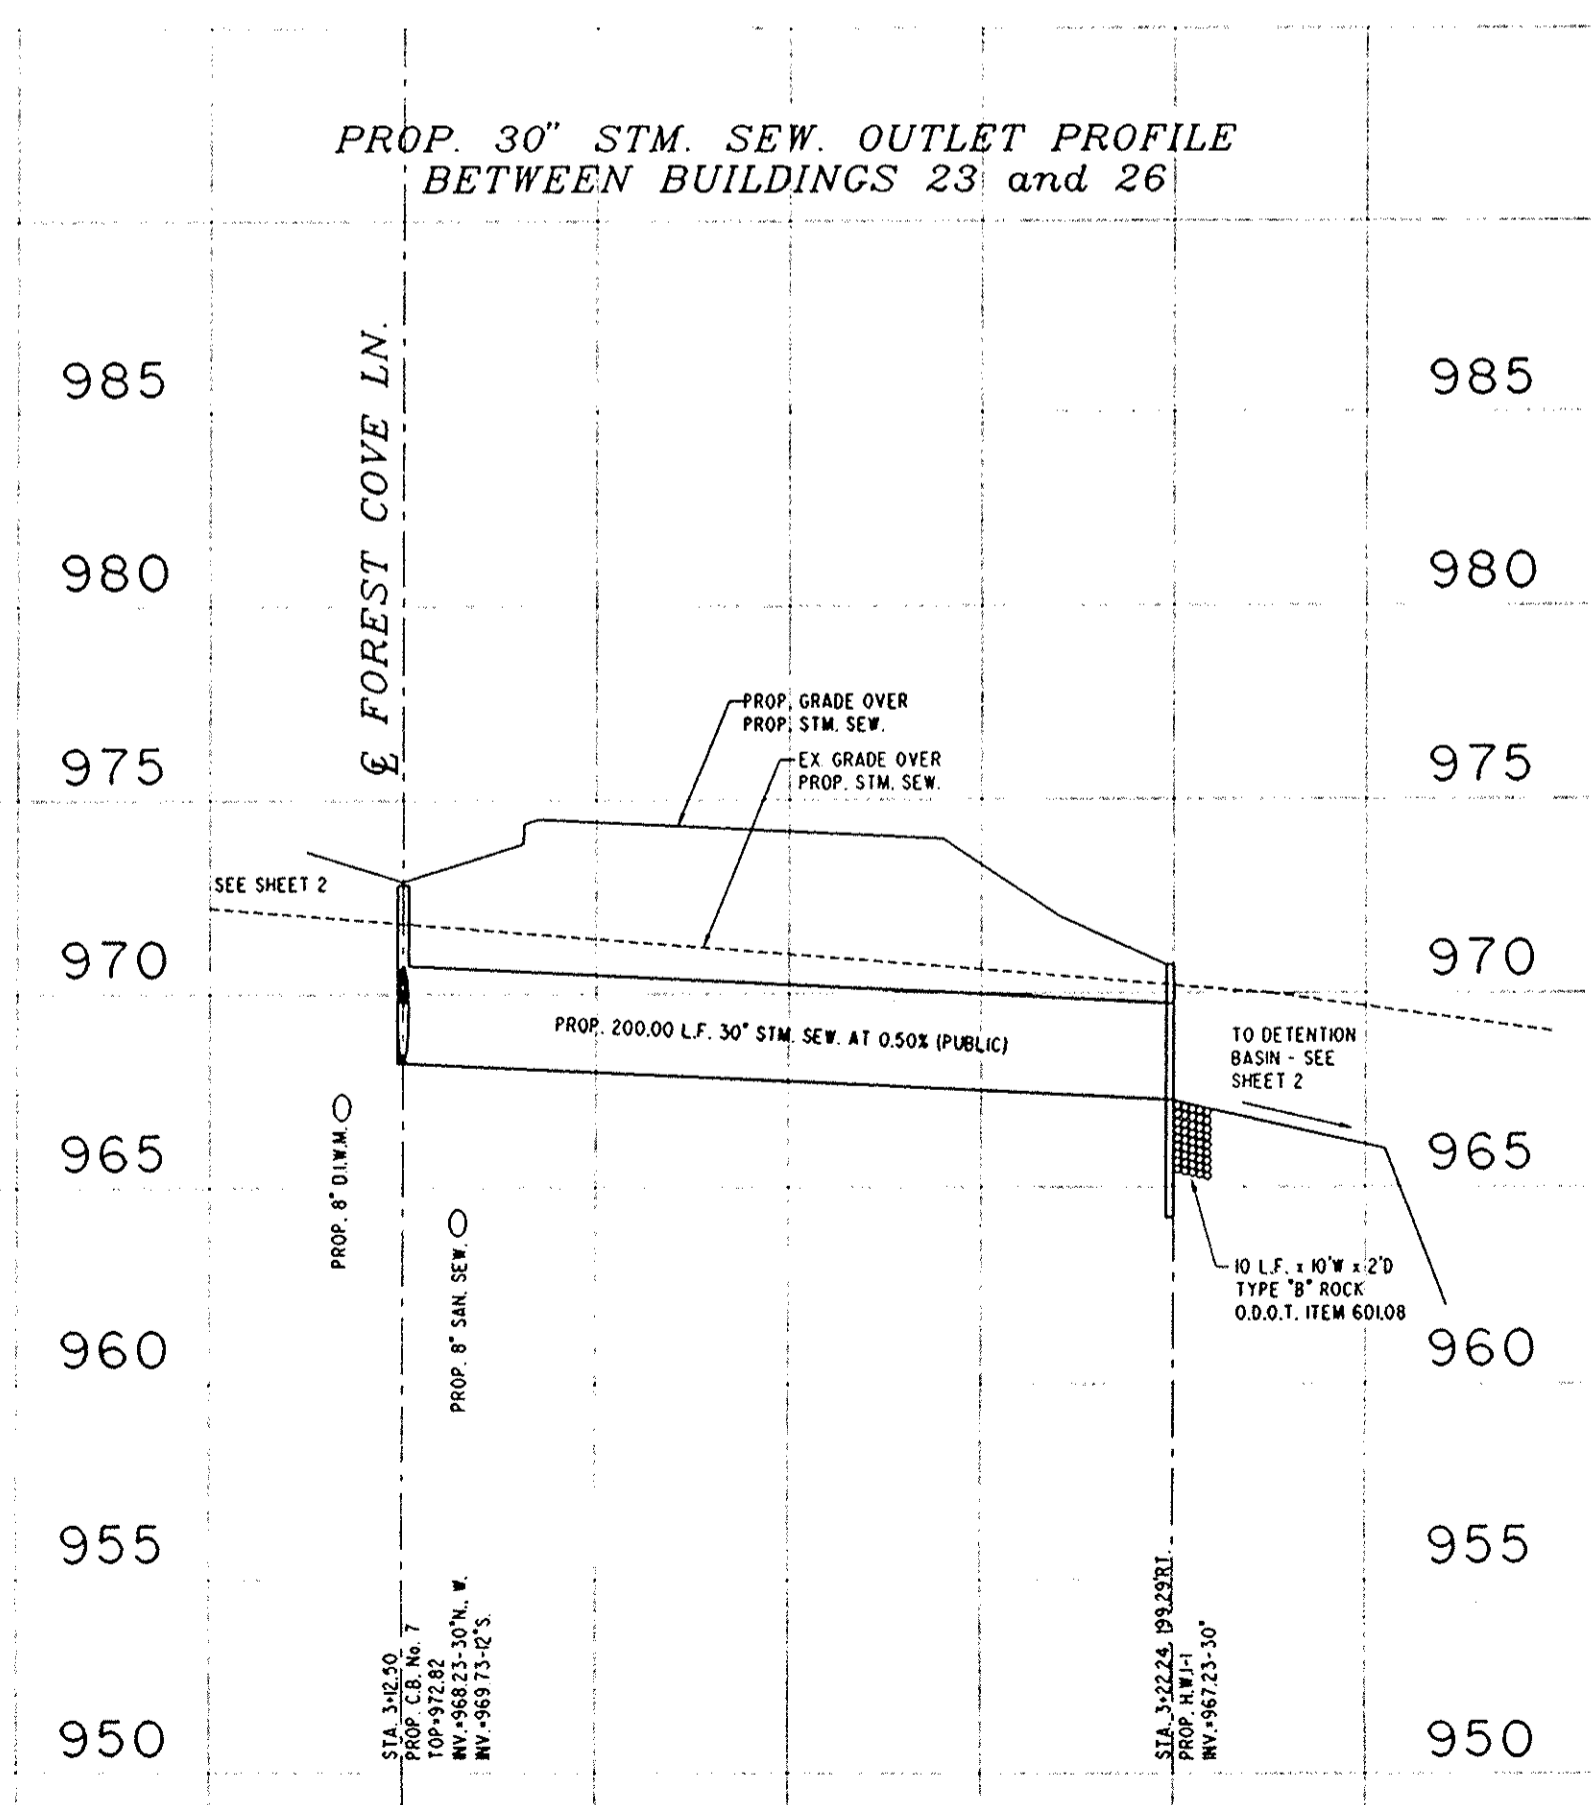

VOID
36 128

6
 11