
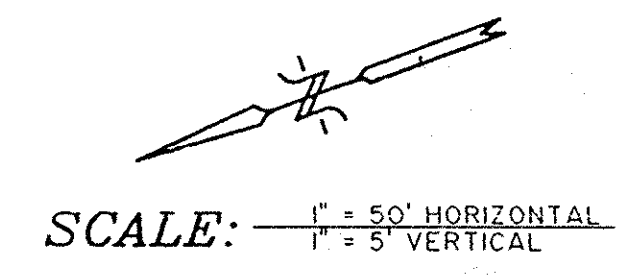


BENCHMARK:
 EXISTING INVERT (12" NW.) SAN. M.H. "T.A.L.X."
 TWINSBURG ROAD STA. 24+06.81, 25.68"RT.
 EX. INV. ELEV. 964.07-12"NW.

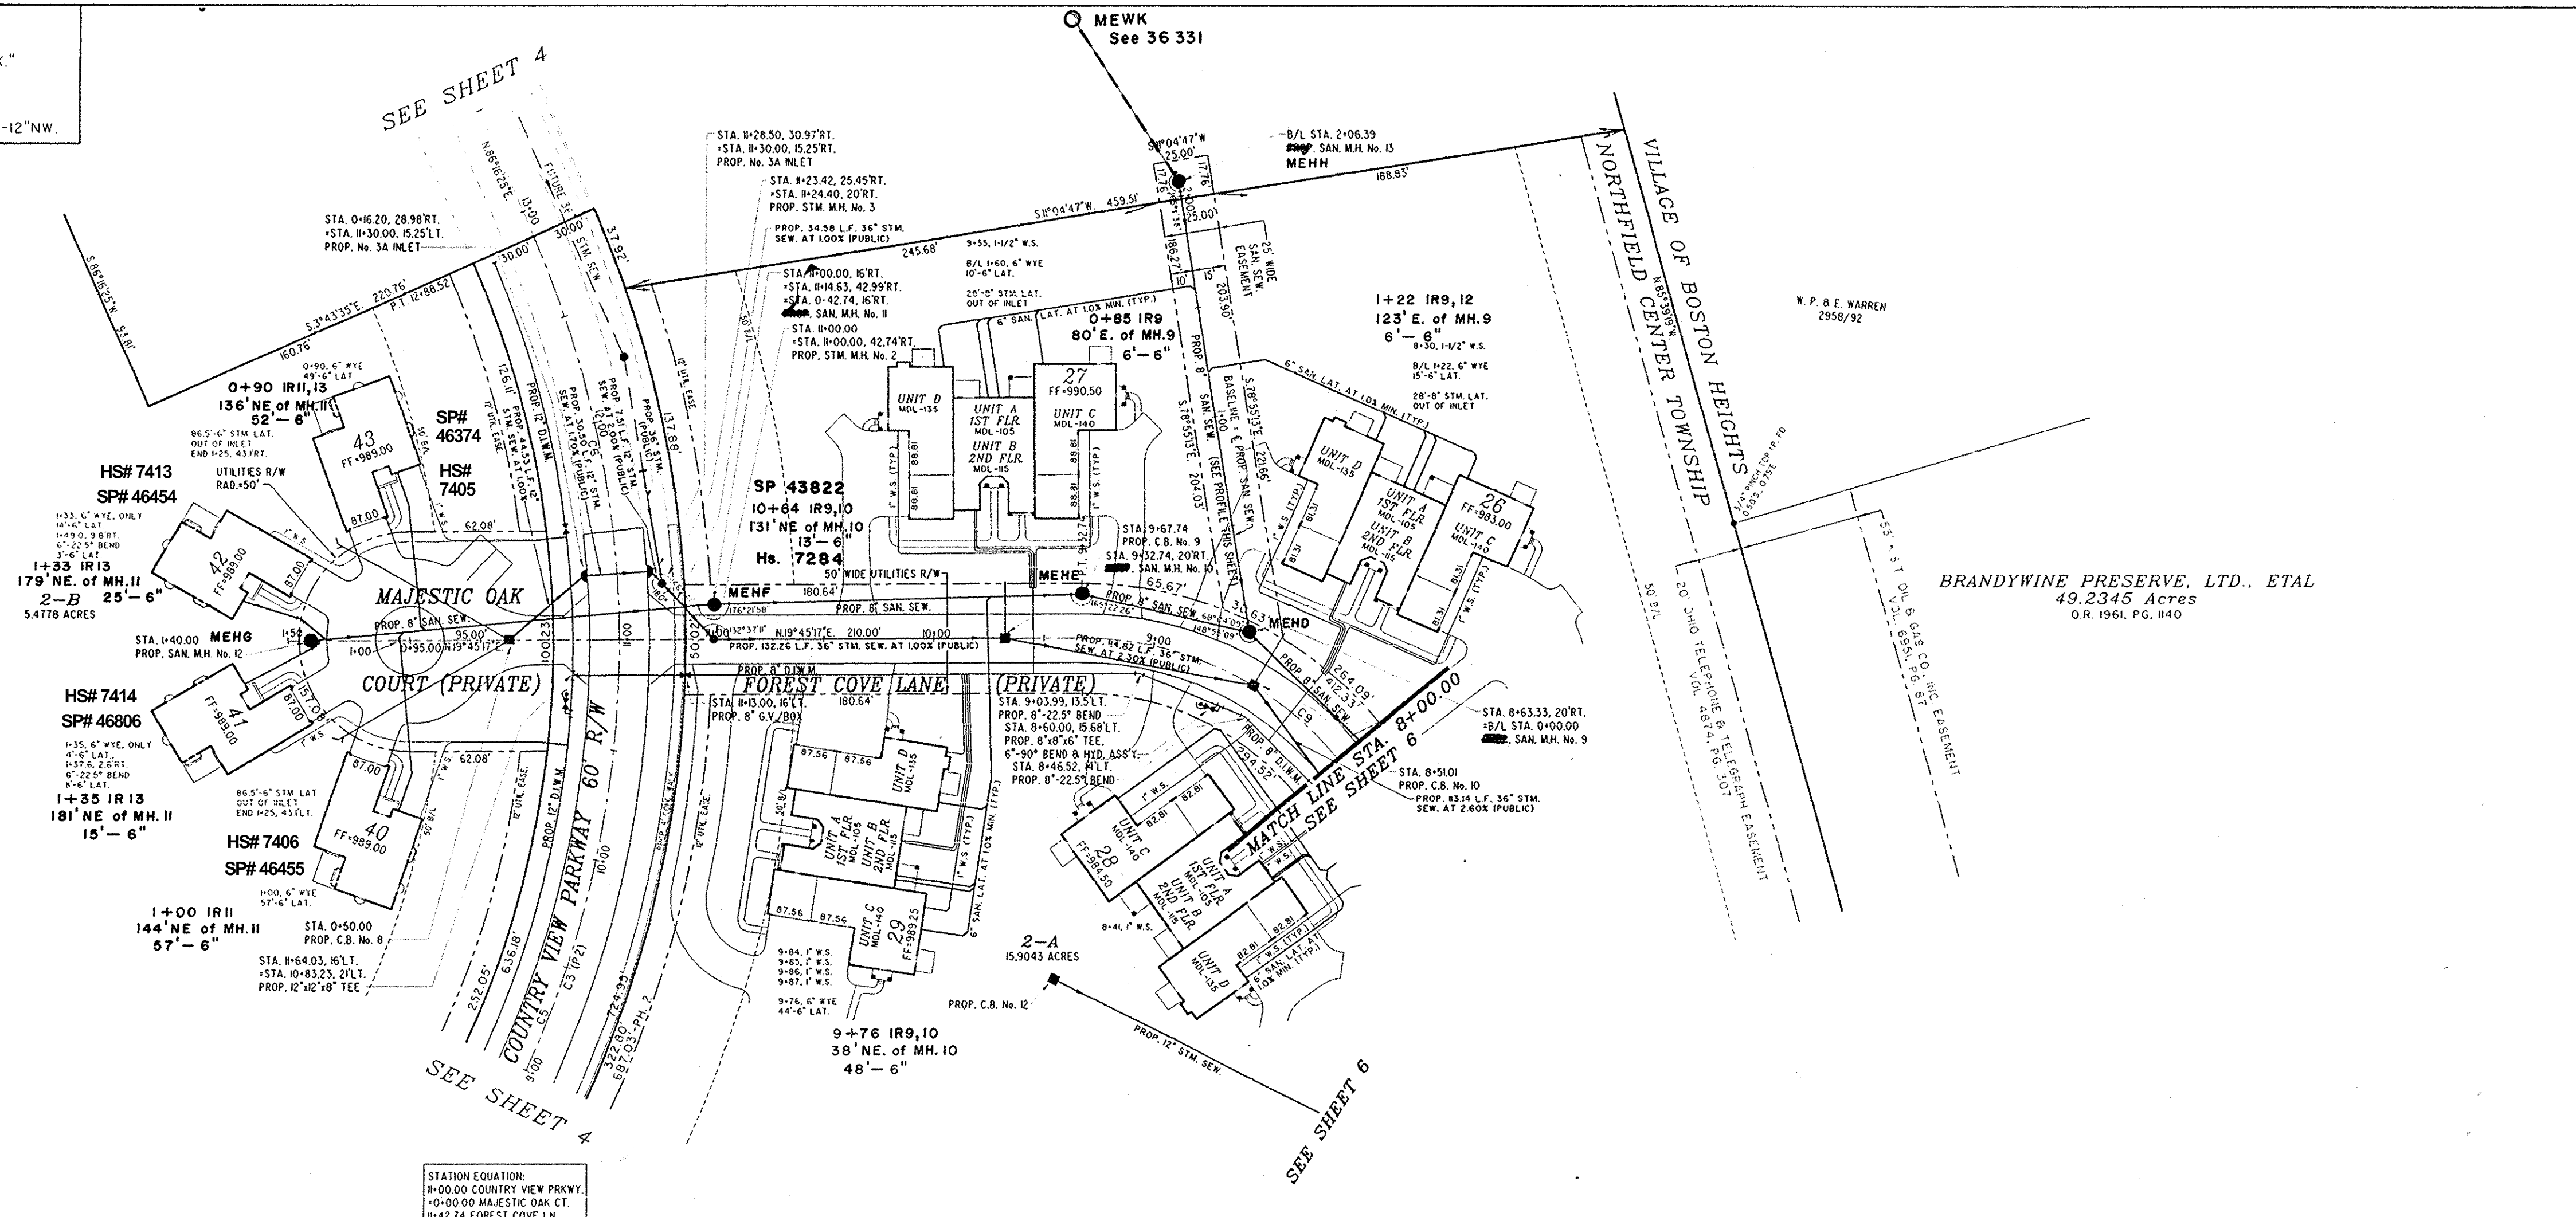

SCALE: 1" = 50' HORIZONTAL
 1" = 5' VERTICAL

SERVICE CONNECTION NOTES:
 ALL SANITARY SEWER LATERALS SHALL BE Laid AT 100% MIN. GRADE AND LOCATED AS SHOWN HEREON.
 EACH 4-PLEX BUILDING SHALL HAVE 4 EACH 1" TYPE "K" COPPER WATER SERVICES (2 EACH PER UNIT), AND LOCATED AS SHOWN HEREON.
 WHEN THE 4-PLEX BUILDING IS ON THE SAME SIDE OF THE STREET AS THE WATER MAIN, CONTRACTOR SHALL PROVIDE 4 EACH 1" CORP. STOPS AND CURB SHUT OFFS FOR EACH BUILDING.
 WHEN THE 4-PLEX BUILDING IS LOCATED ON THE OPPOSITE SIDE OF THE STREET AS THE WATER MAIN, CONTRACTOR SHALL PROVIDE EACH 1/2" CORP. STOP AND 1/2" TYPE "K" COPPER WATER SERVICE TO BUILDING SIDE OF STREET WHERE A MANHOLE WILL BE INSTALLED WITH 4 EACH 1" CURB SHUT OFFS FOR THE 1" TYPE "K" WATER SERVICES.

CURVE TABLE

CURVE#	RADIUS	LENGTH	CHORD	CHORD BEARING	DELTA ANGLE	TANGENT
(PHASE 2) C3	460.00	680.56	620.17	N 5°20'32" W	84°46'6"	419.80
C5	460.00	350.00	341.62	N 48°26'53" W	43°35'41"	183.96
C6	460.00	188.52	187.20	N 81°59'09" W	23°28'52"	95.60
C9	150.00	353.43	277.16	S 87°15'17" W	135°0'0"	362.13

STATION EQUATION:
 0+00.00 COUNTRY VIEW PRKWAY
 0+00.00 MAJESTIC OAK CT
 0+42.74 FOREST COVE LN

