


Low 998.9

CATALINA


50'

2
4

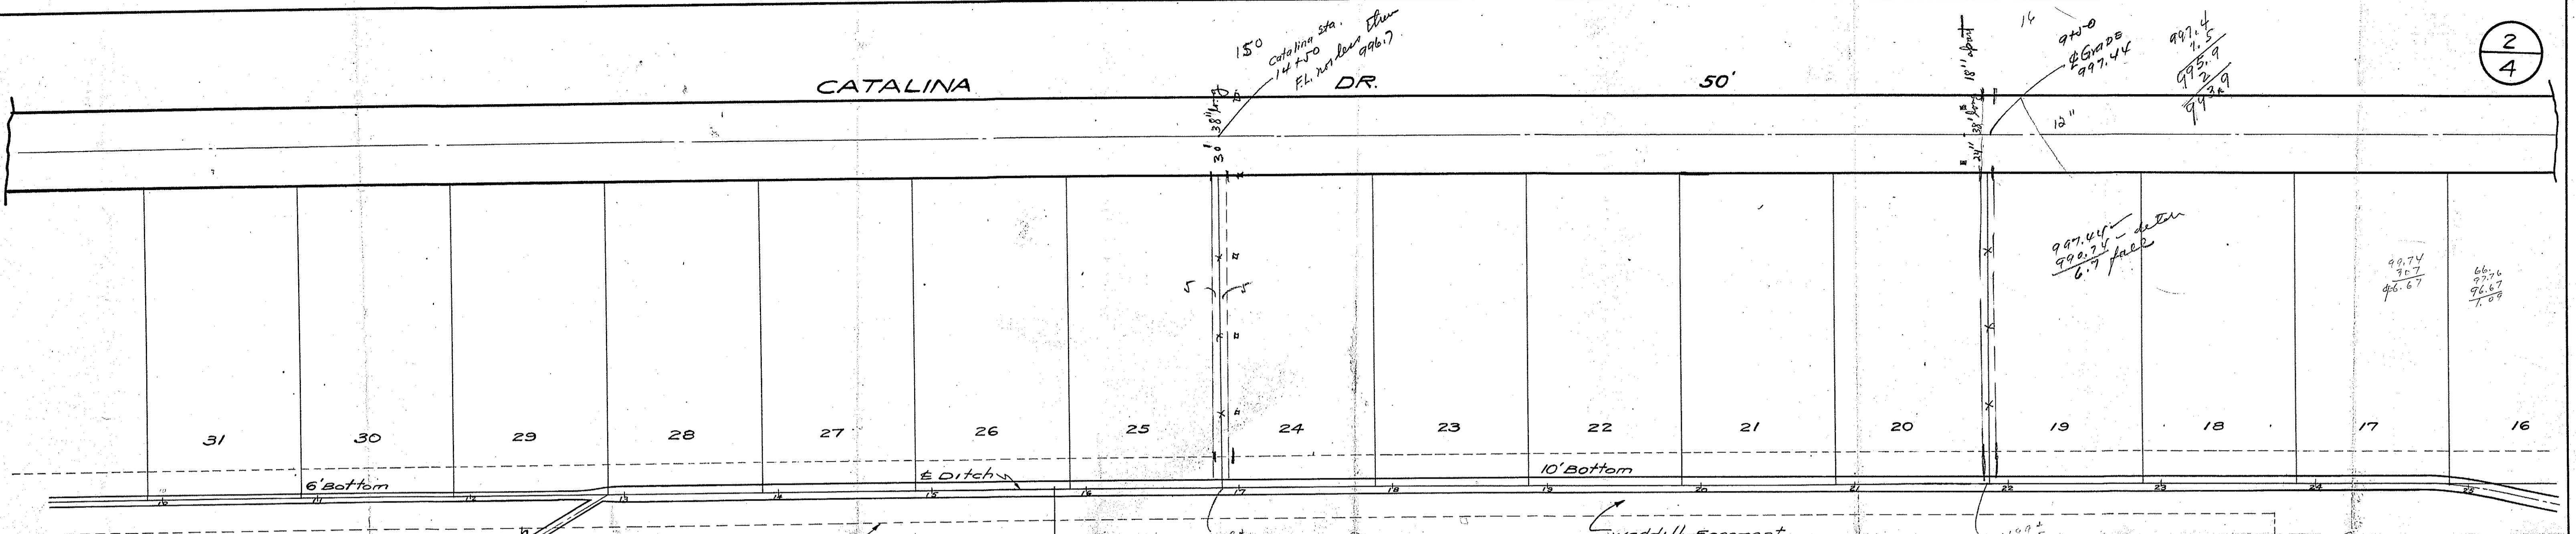

OHIO EDISON

MARTHA J. WADDILL
(ROBT. A. & ELAINE D. ABEL)
LAND CONTRACTORS

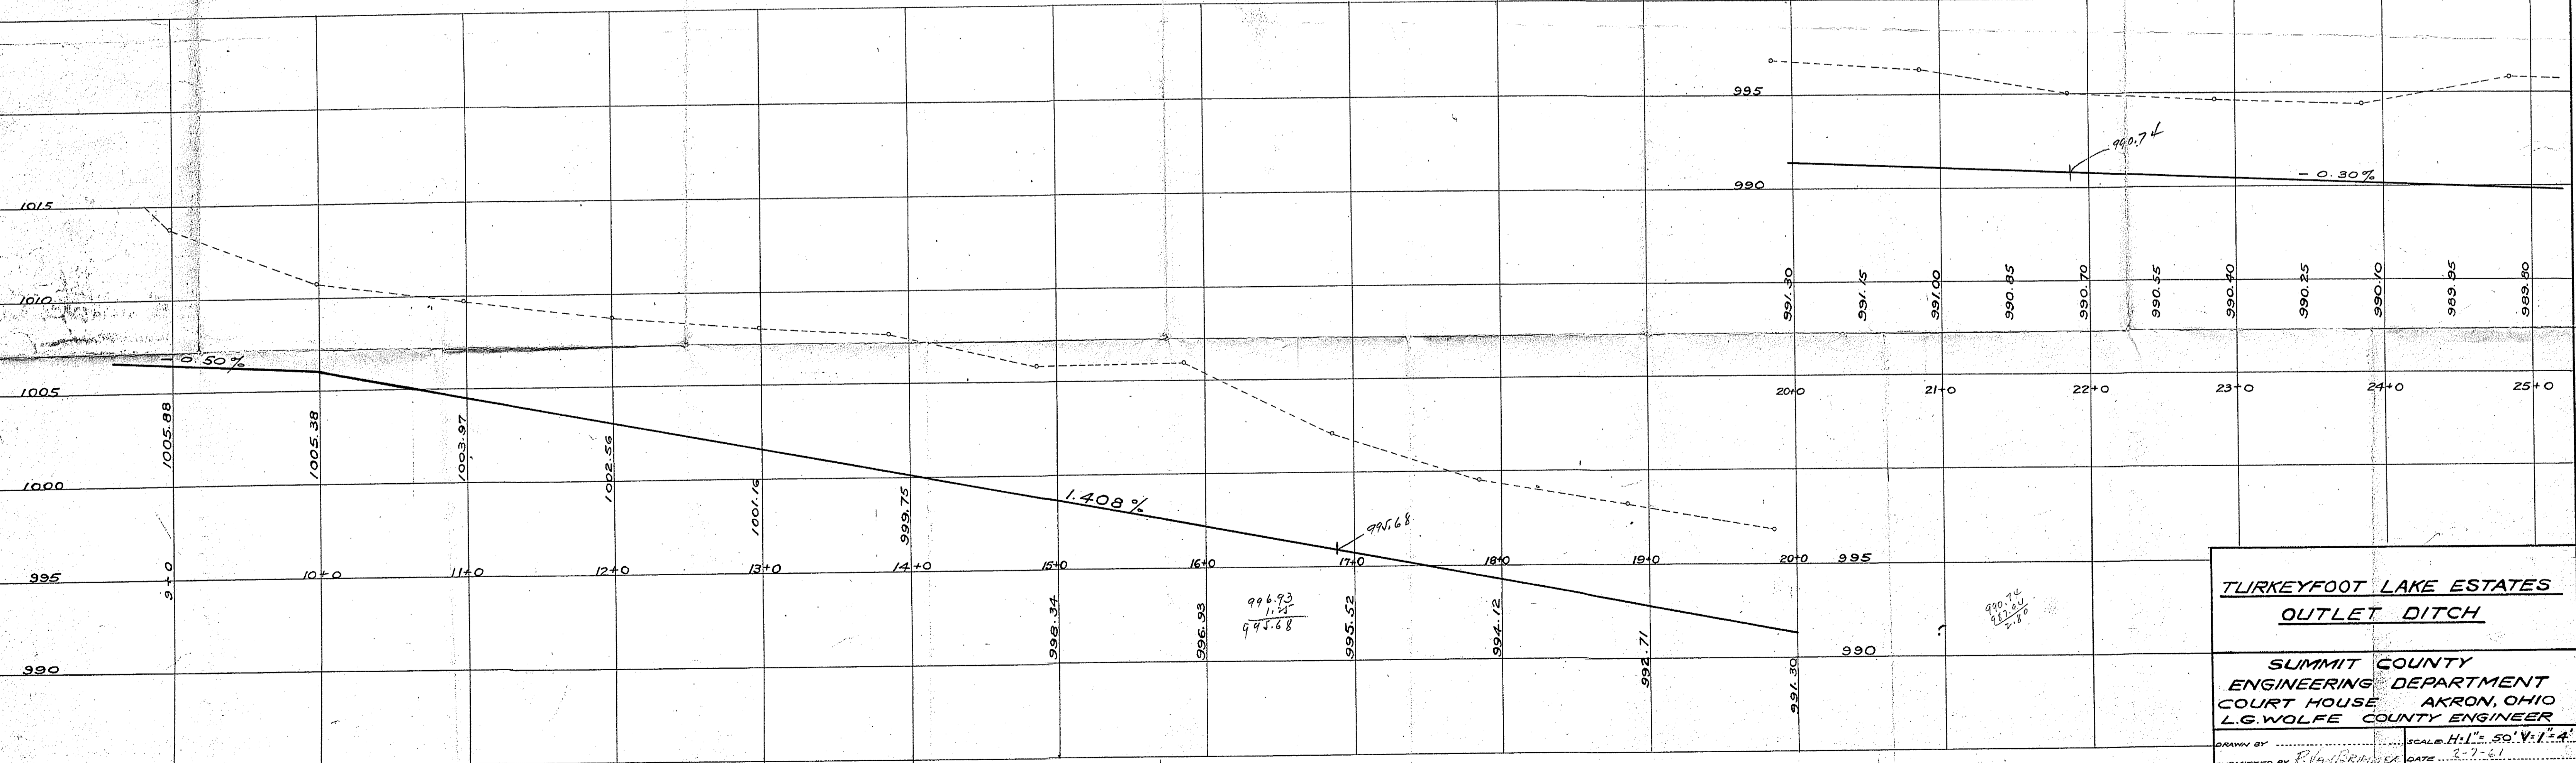

**TURKEYFOOT LAKE ESTATES
OUTLET DITCH**

SUMMIT COUNTY
ENGINEERING DEPARTMENT
COURT HOUSE AKRON, OHIO
L.G. WOLFE COUNTY ENGINEER

DRAWN BY	SCALE H:V = 50':1"
SUBMITTED BY	DATE 3-7-61
DESIGNING ENGINEER	FIELD BOOK 812
APPROVED BY	TRACED BY