GPD GROUP
Glaus, Pyle, Schomer, Burns & DeHaven, Inc.
520 South Main Street, Suite 2531
Akron, Ohio 44311
330.572.2100 Fax 330.572.2101
Copyright; Glaus, Pyle, Schomer, Burns & DeHaven, Inc. 2014

N

0 10 20 40
1"=20'
Horizontal Scale
in Feet

LEGEND
SEE GENERAL LEGEND, SHEET 4

PROPOSED DRAINAGE ACCESS EASEMENT

AS-BUILT LEGEND

- DESIGNED WATER VALVE
- DESIGNED HYDRANT
- ASBUILT ELECTRIC PULLBOX
- ASBUILT WATER VALVE
- ASBUILT HYDRANT
- STORM ASBUILT LATERAL TERMINATION
- SANITARY ASBUILT LATERAL TERMINATION
- WATER ASBUILT LATERAL TERMINATION

NOTE:
ANY SERVICE LATERAL CROSSING WATER MAIN SHALL MAINTAIN 18" MINIMUM CLEARANCE.

ALL WATER MAIN PIPE JOINTS WITHIN AREAS OF FILL MUST BE RESTRAINED.

STORM SEWER
REFER TO GENERAL NOTES SHEET 5 FOR GENERAL NOTES.
ALL RCP PIPE SHALL BE CLASS 4 PER ODOT 706.02
ALL HDPE PIPE SHALL BE SMOOTH LINED PER ODOT 707.33
ALL PVC PIPE SHALL BE SDR 35 PER ODOT 707.45

Underground Utilities

2 Working Days
Before You Dig
Call 800-362-2764 (Toll Free)
Ohio Utilities Protection Service

Non-members
Must Be Called Directly

Call 800-925-0988 (Toll Free)
Oil & Gas Producers Utility Protection Service

NOTE:
ALL OIL AND GAS WELL REMOVALS, PLUGGING/CAPPING, AND ABANDONMENTS SHALL BE IN ACCORDANCE WITH ALL ASSOCIATED REGULATIONS FOR SUCH REMOVALS, INCLUDING BUT NOT LIMITED TO, ODNR, LOCAL, STATE, AND FEDERAL.

EXISTING HIGH PRESSURE GAS MAIN SHALL BE LOCATED AND PROTECTED PRIOR TO AND THROUGHOUT CONSTRUCTION.

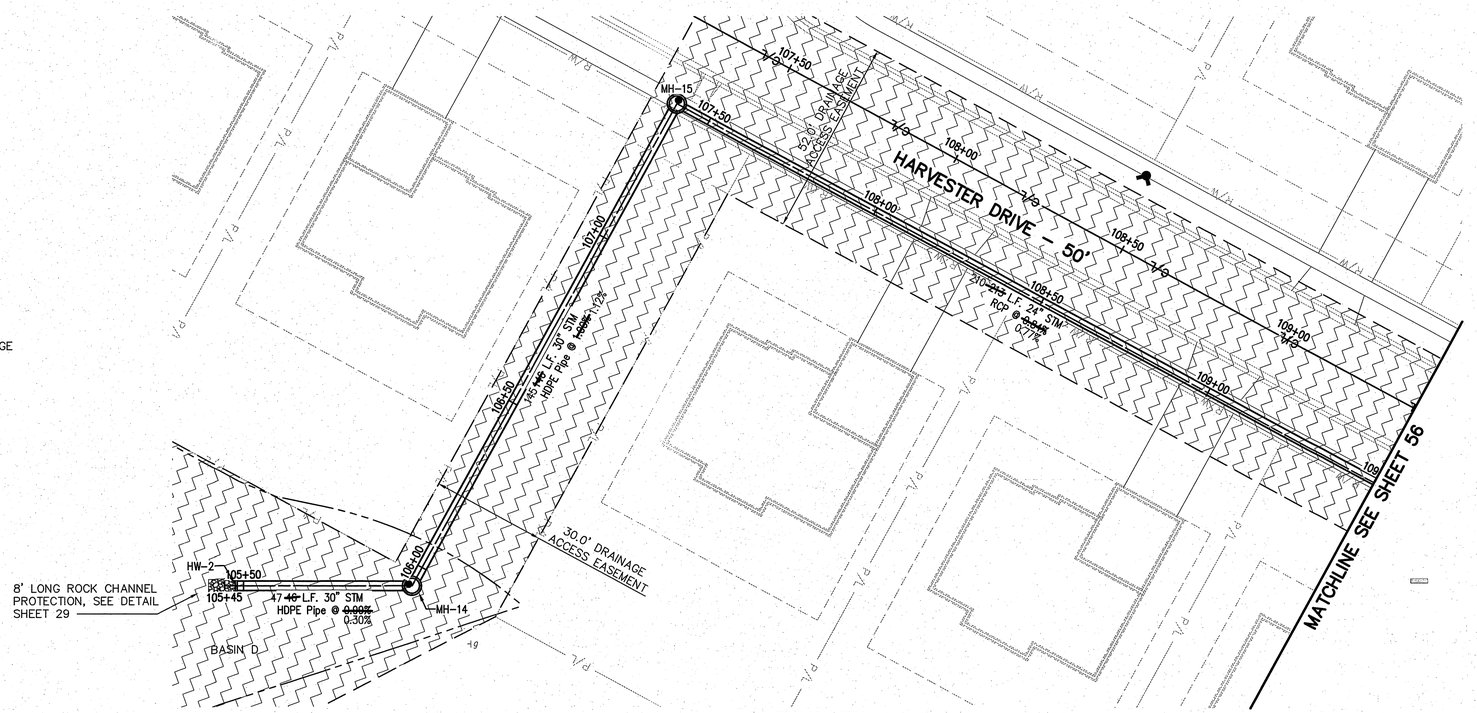

PLAN VIEW
SCALE: 1"=20'

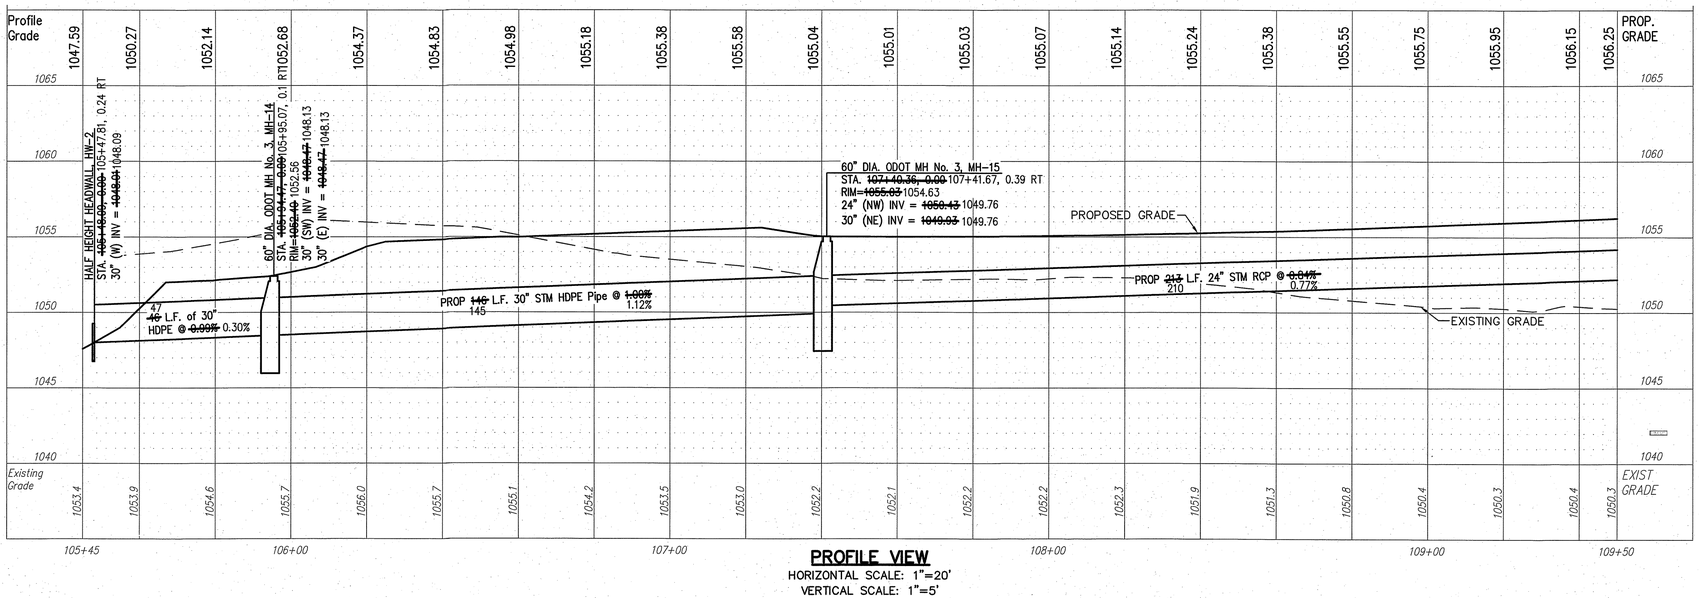

PROFILE VIEW
HORIZONTAL SCALE: 1"=20'
VERTICAL SCALE: 1"=5'

REV.	DATE	DESCRIPTION
	12/8/14	BRIDGE PLAN REVISIONS

THE PRESERVE AT MILLER'S FARM
SE CORNER OF SR 18 AND MEDINA LINE RD
COPLEY, OHIO 44321

PLAN AND PROFILE
UTILITY

ISSUED FOR:	
PERMIT	06-02-14
BID	06-02-14
CONSTRUCTION	09-16-14
AS-BUILT	02-26-15

PROJECT MANAGER	DESIGNER
MAL	KB

JOB NO.
2013258.00

55/81

Drawing Name: "C:\2013\2013258000\DWG\Construction Documents\AsBuilt 2013258000 PP Utility.dwg
March 3, 2015 8:13 AM - afister