LEGEND

SEE GENERAL LEGEND, SHEET 04

- PROPOSED ROLLED CURB AND GUTTER
- PROPOSED WALK
- PROPOSED WALK BY OTHERS
- PROPOSED WATER LATERAL
- PROPOSED SANITARY LATERAL
- PROPOSED STORM LATERAL
- PROPOSED WATER MAIN
- PROPOSED SANITARY MAIN
- PROPOSED STORM MAIN
- PROPOSED C/L OF CONSTRUCTION
- PROPOSED C/L OF RIGHT OF WAY
- PROPOSED MONUMENT BOX
- BF=XXXX PROPOSED BOTTOM OF FOOTER ELEVATION
- PROPOSED ASPHALT PAVEMENT
- EXISTING DRAINAGE ACCESS EASEMENT
- PROPOSED WATERLINE EASEMENT
- PROPOSED DRAINAGE ACCESS EASEMENT
- RIPARIAN SETBACK

AS-BUILT LEGEND

- AS-BUILT CATCH BASIN
- AS-BUILT STORM LATERAL TERMINATION
- AS-BUILT SANITARY MANHOLE
- AS-BUILT SANITARY LATERAL TERMINATION
- AS-BUILT HYDRANT
- AS-BUILT WATER LATERAL TERMINATION
- AS-BUILT WATER SERVICE VALVE

WATER MAIN FITTING SCHEDULE

ITEM	STATION	OFFSET
*6" HYD. ASSEMBLY, TYPE B	~~512+63.85~~	~~10.04' RT.~~
22.5° BEND	~~513+66.43~~	~~8.04' RT.~~

* STATION AND OFFSET TAKEN TO CENTER OF HYDRANT

NOTE: PROVIDE CONCRETE THRUST BLOCKING ON ALL WATER LINE BENDS PER DETAIL SHEET 29

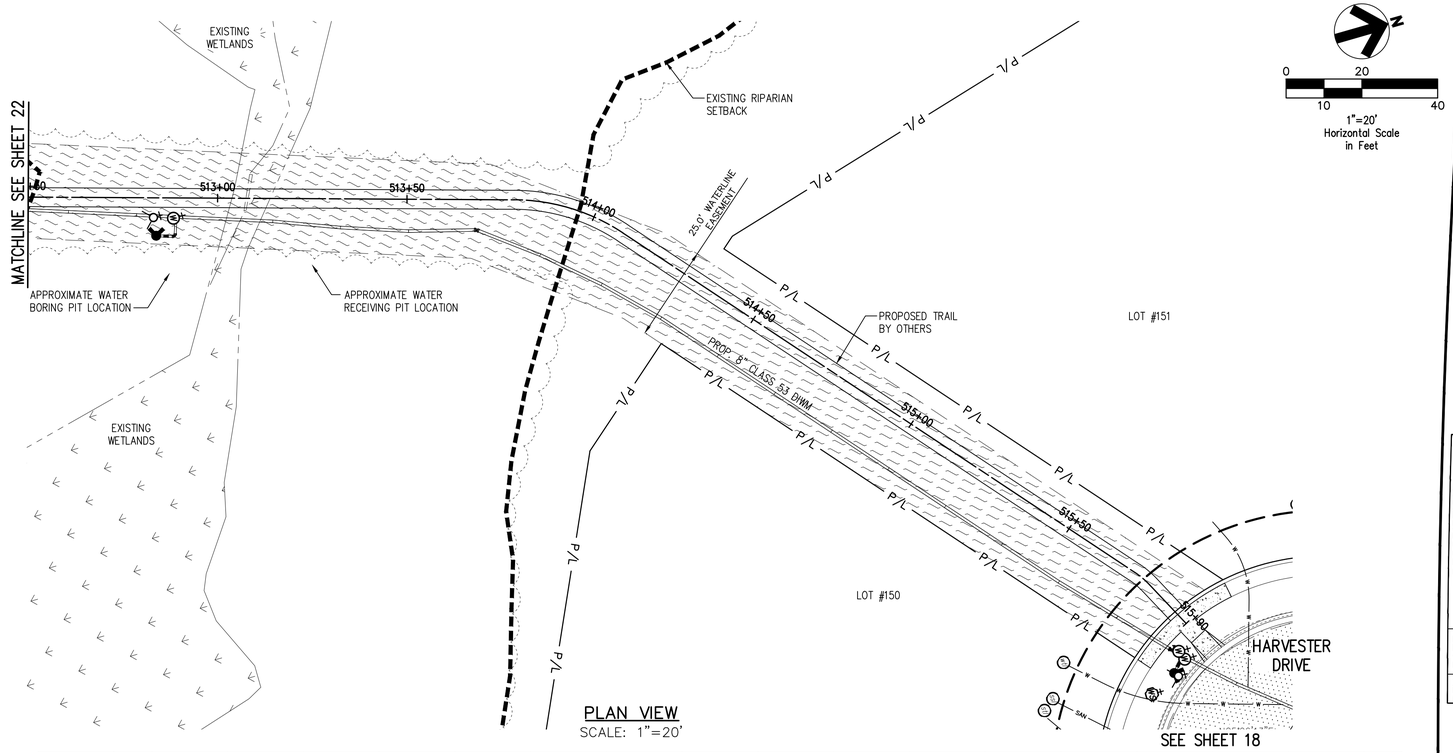

PLAN VIEW
SCALE: 1"=20'

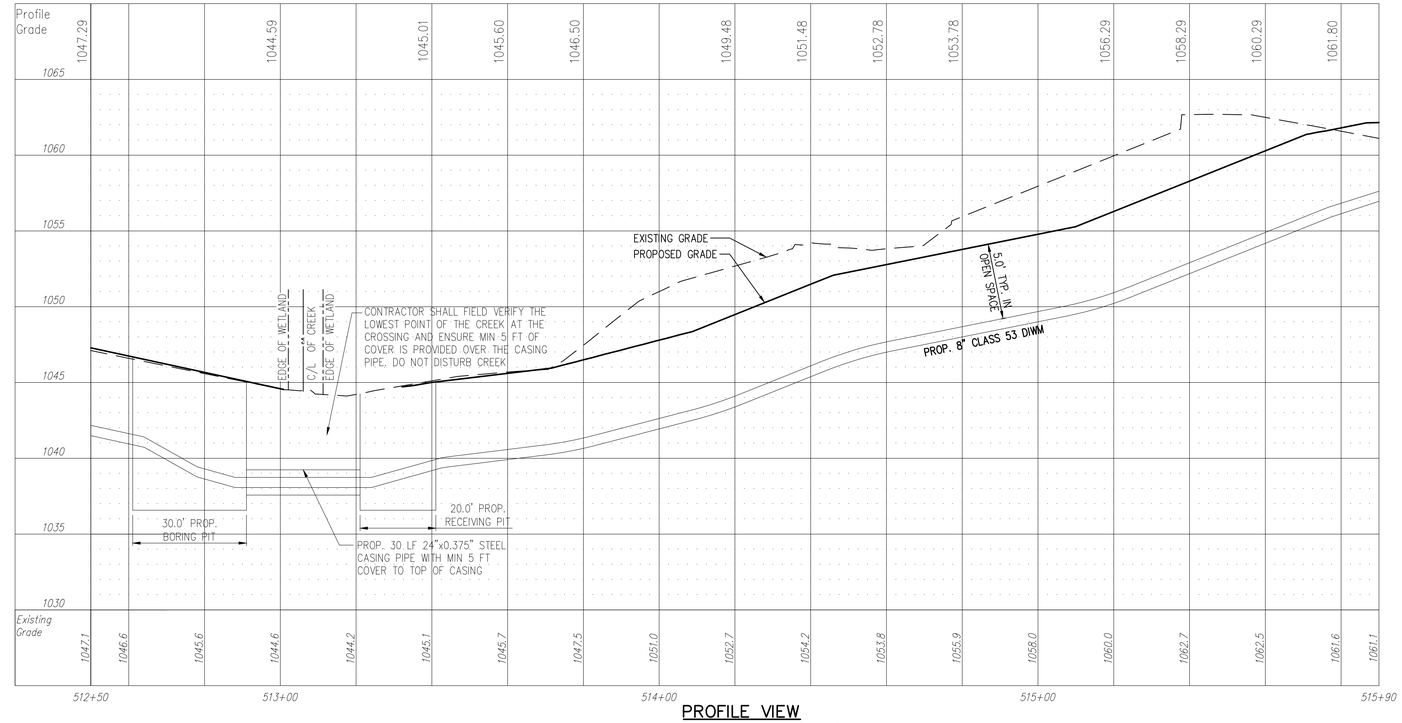

PROFILE VIEW
HORIZONTAL SCALE: 1"=20'
VERTICAL SCALE: 1"=5'

NOTE:
ANY SERVICE LATERAL CROSSING WATER MAIN SHALL MAINTAIN 18" MINIMUM CLEARANCE.

ALL WATER MAIN PIPE JOINTS WITHIN AREAS OF FILL MUST BE RESTRAINED.

STORM SEWER

REFER TO GENERAL NOTES SHEET 05 FOR CONSTRUCTION NOTES.

ALL RCP PIPE SHALL BE CLASS 4 PER ODOT 706.02

ALL HDPE PIPE SHALL BE SMOOTH LINED PER ODOT 707.33

ALL PVC PIPE SHALL BE SDR 35 PER ODOT 707.45

Underground Utilities

2 Working Days Before You Dig
Call 800-362-2764 (Toll Free)
Ohio Utilities Protection Service

Non-members Must Be Called Directly

Call 800-925-0988 (Toll Free)
Oil & Gas Producers Utility Protection Service

NOTE:
ALL OIL AND GAS WELL REMOVALS, PLUGGING/CAPPING, AND ABANDONMENTS SHALL BE IN ACCORDANCE WITH ALL ASSOCIATED REGULATIONS FOR SUCH REMOVALS, INCLUDING BUT NOT LIMITED TO, ODNR, LOCAL, STATE, AND FEDERAL.

EXISTING HIGH PRESSURE GAS MAIN SHALL BE LOCATED AND PROTECTED PRIOR TO AND THROUGHOUT CONSTRUCTION.

GPD GROUP
Glaus, Pyle, Schomer, Burns & DeHaven, Inc.
520 South Main Street, Suite 2531
Akron, Ohio 44311
330.572.2100 Fax 330.572.2101

Copyright; Glaus, Pyle, Schomer, Burns & DeHaven, Inc. 2016

REV.	DATE	DESCRIPTION

THE PRESERVE AT MILLER'S FARM
PHASE 4 AS-BUILTS
SE CORNER OF SR 18 AND MEDINA LINE RD
COPLEY, OHIO 44321

PLAN AND PROFILE
WATER MAIN

ISSUED FOR:	
PERMIT	
BID	
CONSTRUCTION	
AS-BUILT	01-19-2018

PROJECT MANAGER	DESIGNER
MAL	ALF

JOB NO.
2013258.04

Drawing Name: Q:\2013\2013258\04\Survey\Phase 4 As-Built\20132580 4 AS-BUILT PP Sheets.dwg
January 19, 2018 10:12 AM twright