

SITE BENCH MARK
 BENCH MARK #1
 TOP NUT ON HYDRANT
 IN CUL-DE-SAC ON ALLIANCE DRIVE
 ELEVATION = 911.93

SITE BENCH MARK
 BENCH MARK #2
 TOP NUT ON HYDRANT
 ON DUNHAM ROAD
 ELEVATION = 952.66

ALL OFF-SITE BORROW OR SPOIL AREAS SHALL BE REQUIRED TO BE PERMITTED BY A SEPARATE NOI AND RELATED SWP3.
 THIS PROJECT WILL HAVE NO OFF-SITE BORROW OR SPOIL AREAS. ALL MATERIALS WILL BE CONTAINED WITHIN THE SITE.

ITALICS TEXT REPRESENTS EXISTING CONDITION
 NON-ITALICS TEXT REPRESENTS PROPOSED CONDITION

FLOOD ZONE

FLOOD ZONE "X" PER FLOOD INSURANCE RATE MAP NUMBER 39153C0033E
 EFFECTIVE DATE: JULY 20, 2009

SWP3 AMENDMENT ACTIVITIES

GRADING	DATE
SITE STABILIZATION	DATE
SWP3 AMENDMENT	DATE

SWP3 RESPONSIBLE PARTY

SAGAMORE LAND PROPERTIES LLC.
 PAUL KARNOW
 756 RAVENHILL DRIVE
 SAGAMORE HILLS, OHIO 44319
 330-468-2892

ESTIMATED CONSTRUCTION DATES

START DATE	04-01-2016
END DATE	10-01-2016

SWP3 PREPARED

02-02-2016


TAG HATCH/SYMBOL SWP3 BMP

CL LC		CLEARING LIMITS, LIMITS OF CONSTRUCTION
TCE		TEMPORARY CONSTRUCTION ENTRANCE
CTW VF TW DMP		CEMENT TRUCK WASHOUT, VEHICLE FUELING, TOXIC WASTE AND DUMPSTER LOCATION
IP		INLET PROTECTION (SEE DETAIL ON SHT. C108C)

SF		SILT FENCE
CFS		COMPOST FILTER SOCK MAY BE SUBSTITUTED FOR SILT FENCE AT CONTRACTORS DISCRETION (12" MIN. DIAMETER)
TCD		TEMPORARY CHECK DAM
OP		OUTLET PROTECTION
TDC		TEMPORARY DIVERSION CHANNEL
TSB		TEMPORARY SEDIMENT BASIN
OBF		ORANGE BARRICADE FENCE

OHIO Utilities Protection SERVICE
 Call Before You Dig
 800-362-2764 or 8-1-1
 www.oups.org


OGPUPS
 Ohio Oil & Gas Producers Underground Protection Service
 800-925-0988 or 8-1-1
 www.ogpups.org

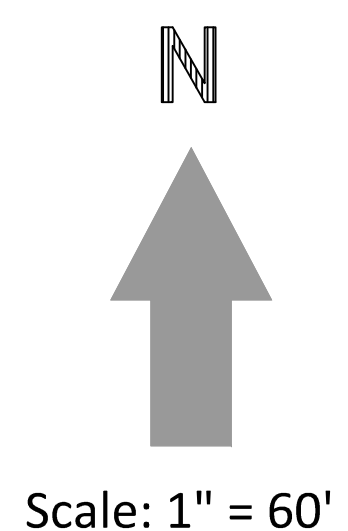

INSPECTION CHECKLIST

INSPECTIONS SHALL BE MADE ONCE EVERY SEVEN (7) CALENDAR DAYS AND WITHIN 24 HOURS AFTER ANY STORM EVEN GREATER THAN ONE-HALF INCH OF RAIN PER 24 HOUR PERIOD

DATE	INSPECTOR	WEATHER CONDITIONS	RAINFALL AMOUNT	SEDIMENT DISCHARGE	DISCHARGE LOCATION	BMPS FAILED	ADDITIONAL BMPS NEEDED	CORRECTION MADE

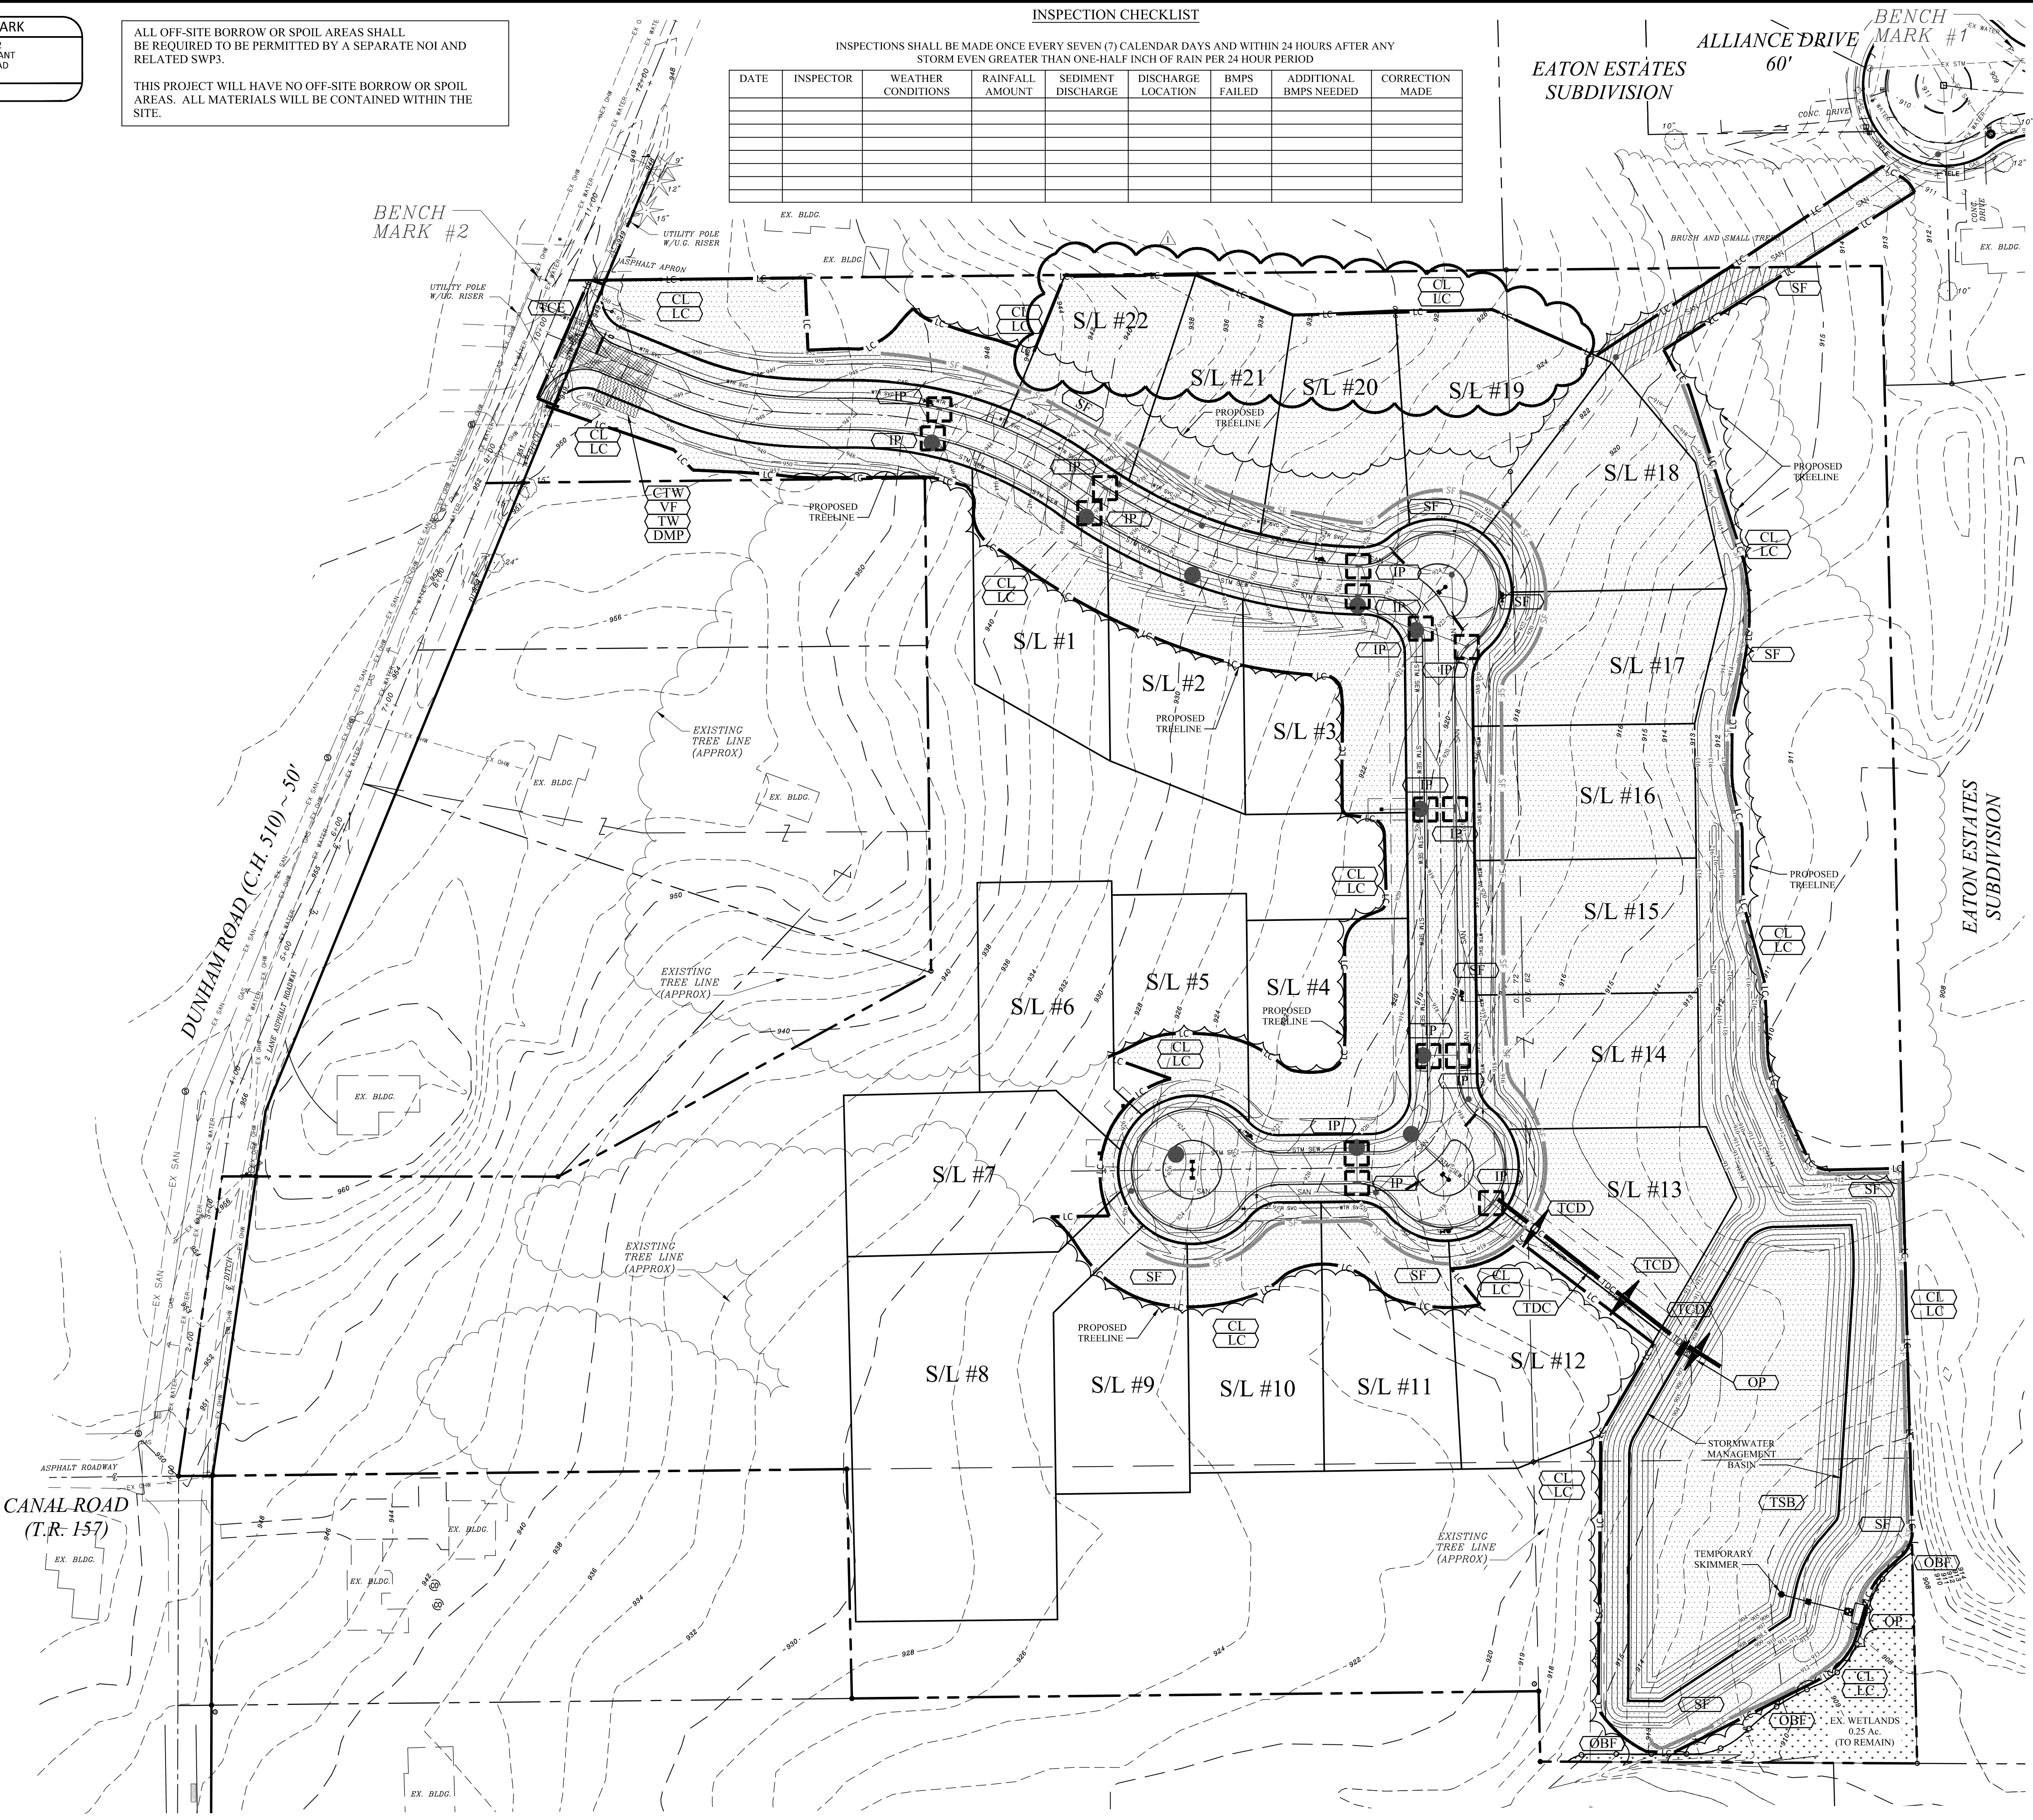

WEBER ENGINEERING SERVICES
 2555 Harville Rd., Suite B
 Rootstown, OH 44272
 www.WeberEngineeringServices.com
 330-329-2037
 matt@webercivil.com

STATE OF OHIO
 MATTHEW WEBER
 61709 REGISTERED PROFESSIONAL ENGINEER
 Reg. No.: 61709

Dunham Land Properties llc.
 756 Ravenhill Drive
 Sagamore Hills, OH 44067
 Paul Karnow
 Ph.# (330) 468-2892
 Fax# (330) 468-2892

Issue Date

01-25-2016
02-05-2016
02-11-2016
02-25-2016
06-01-2016
06-29-2016
08-10-2016
09-08-2016
10-03-2016
10-10-2016
△ 03-27-2017

HIDDEN RIDGE
 RESIDENTIAL SUBDIVISION
 DUNHAM ROAD

SWP3 PLAN

C108
 Project No. 2014-226