
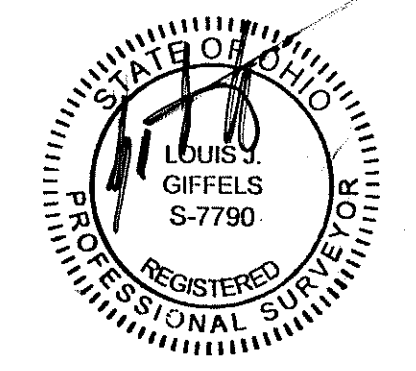
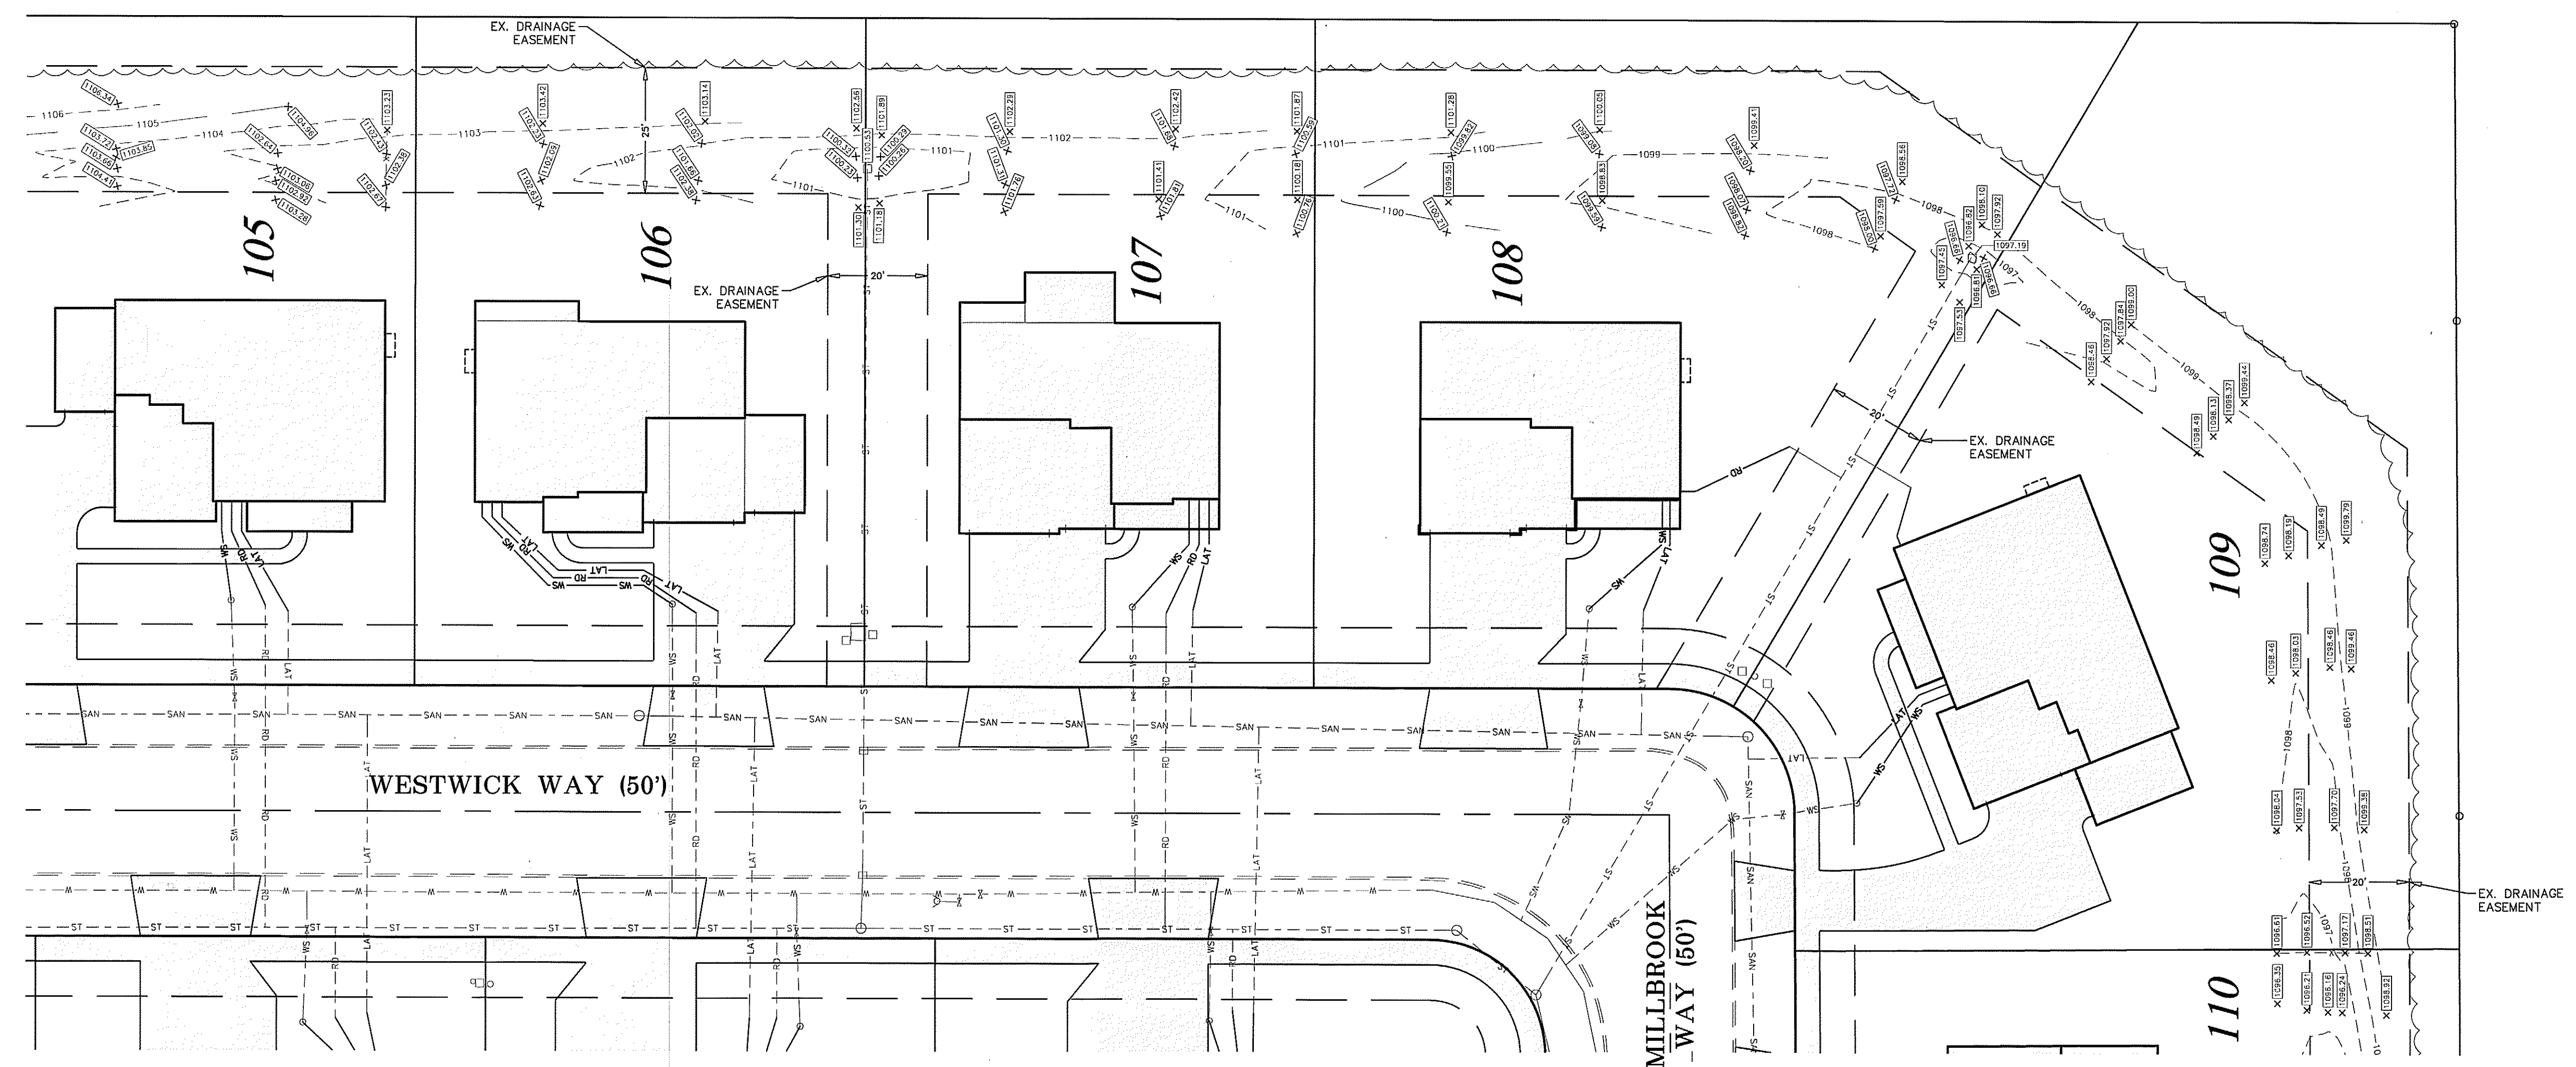


REVISIONS
12/17/2019
ADDITIONAL
TOPO

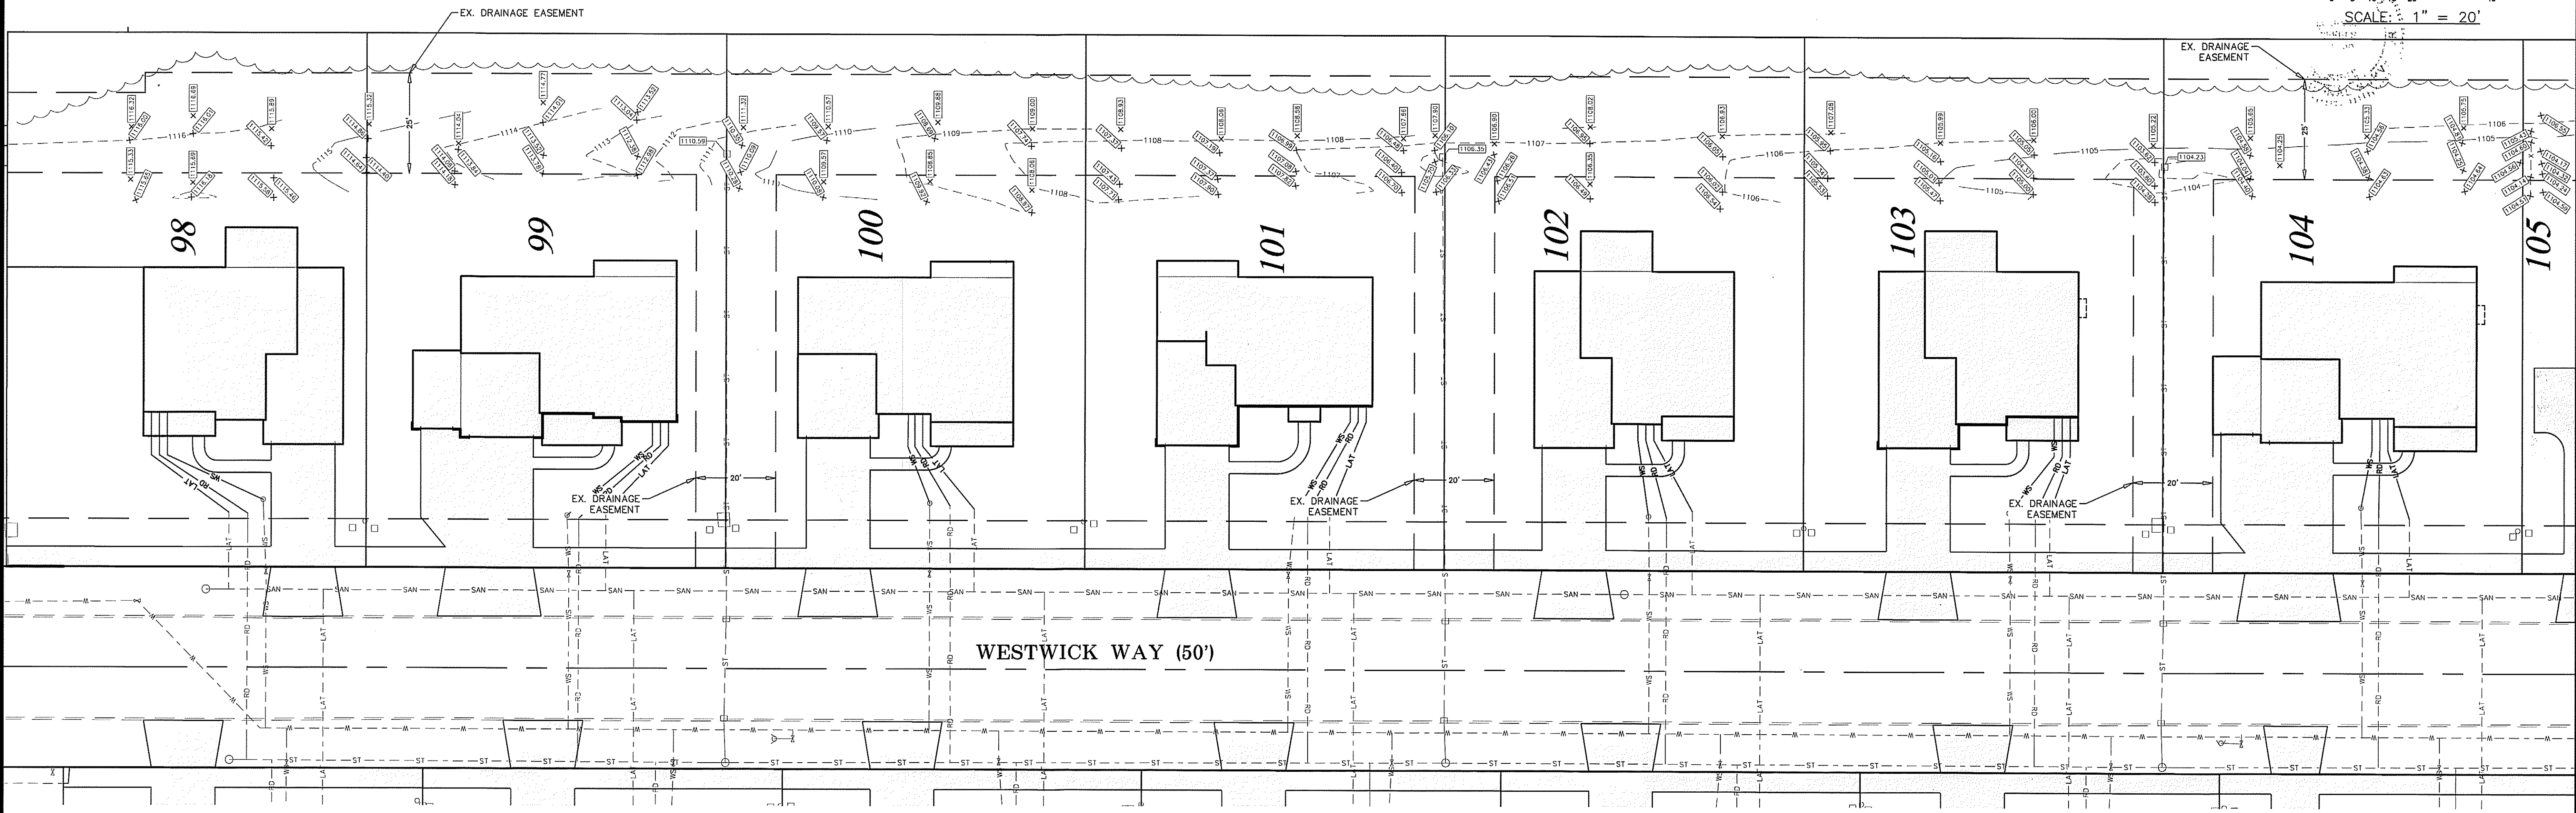

GBC DESIGN, INC.
Akron, OH 44320-1123
565 White Pond Dr.
Phone 330-836-0228
Fax 330-836-5782

RYAN HOMES
6770 SNOWVILLE ROAD, SUITE 100
BRECKSVILLE, OH 44141

HILLSIDE ESTATES PHASE 4
COPLEY TOWNSHIP
COUNTY OF SUMMIT, OHIO
REAR YARD TOPO, LOTS 98-104,
106-109 & 111-117

DRAWN BY:
B.A.W.
DATE:
12/16/2019
PROJECT NO.
50259A-F
DRAWING NO.
1 OF 2