
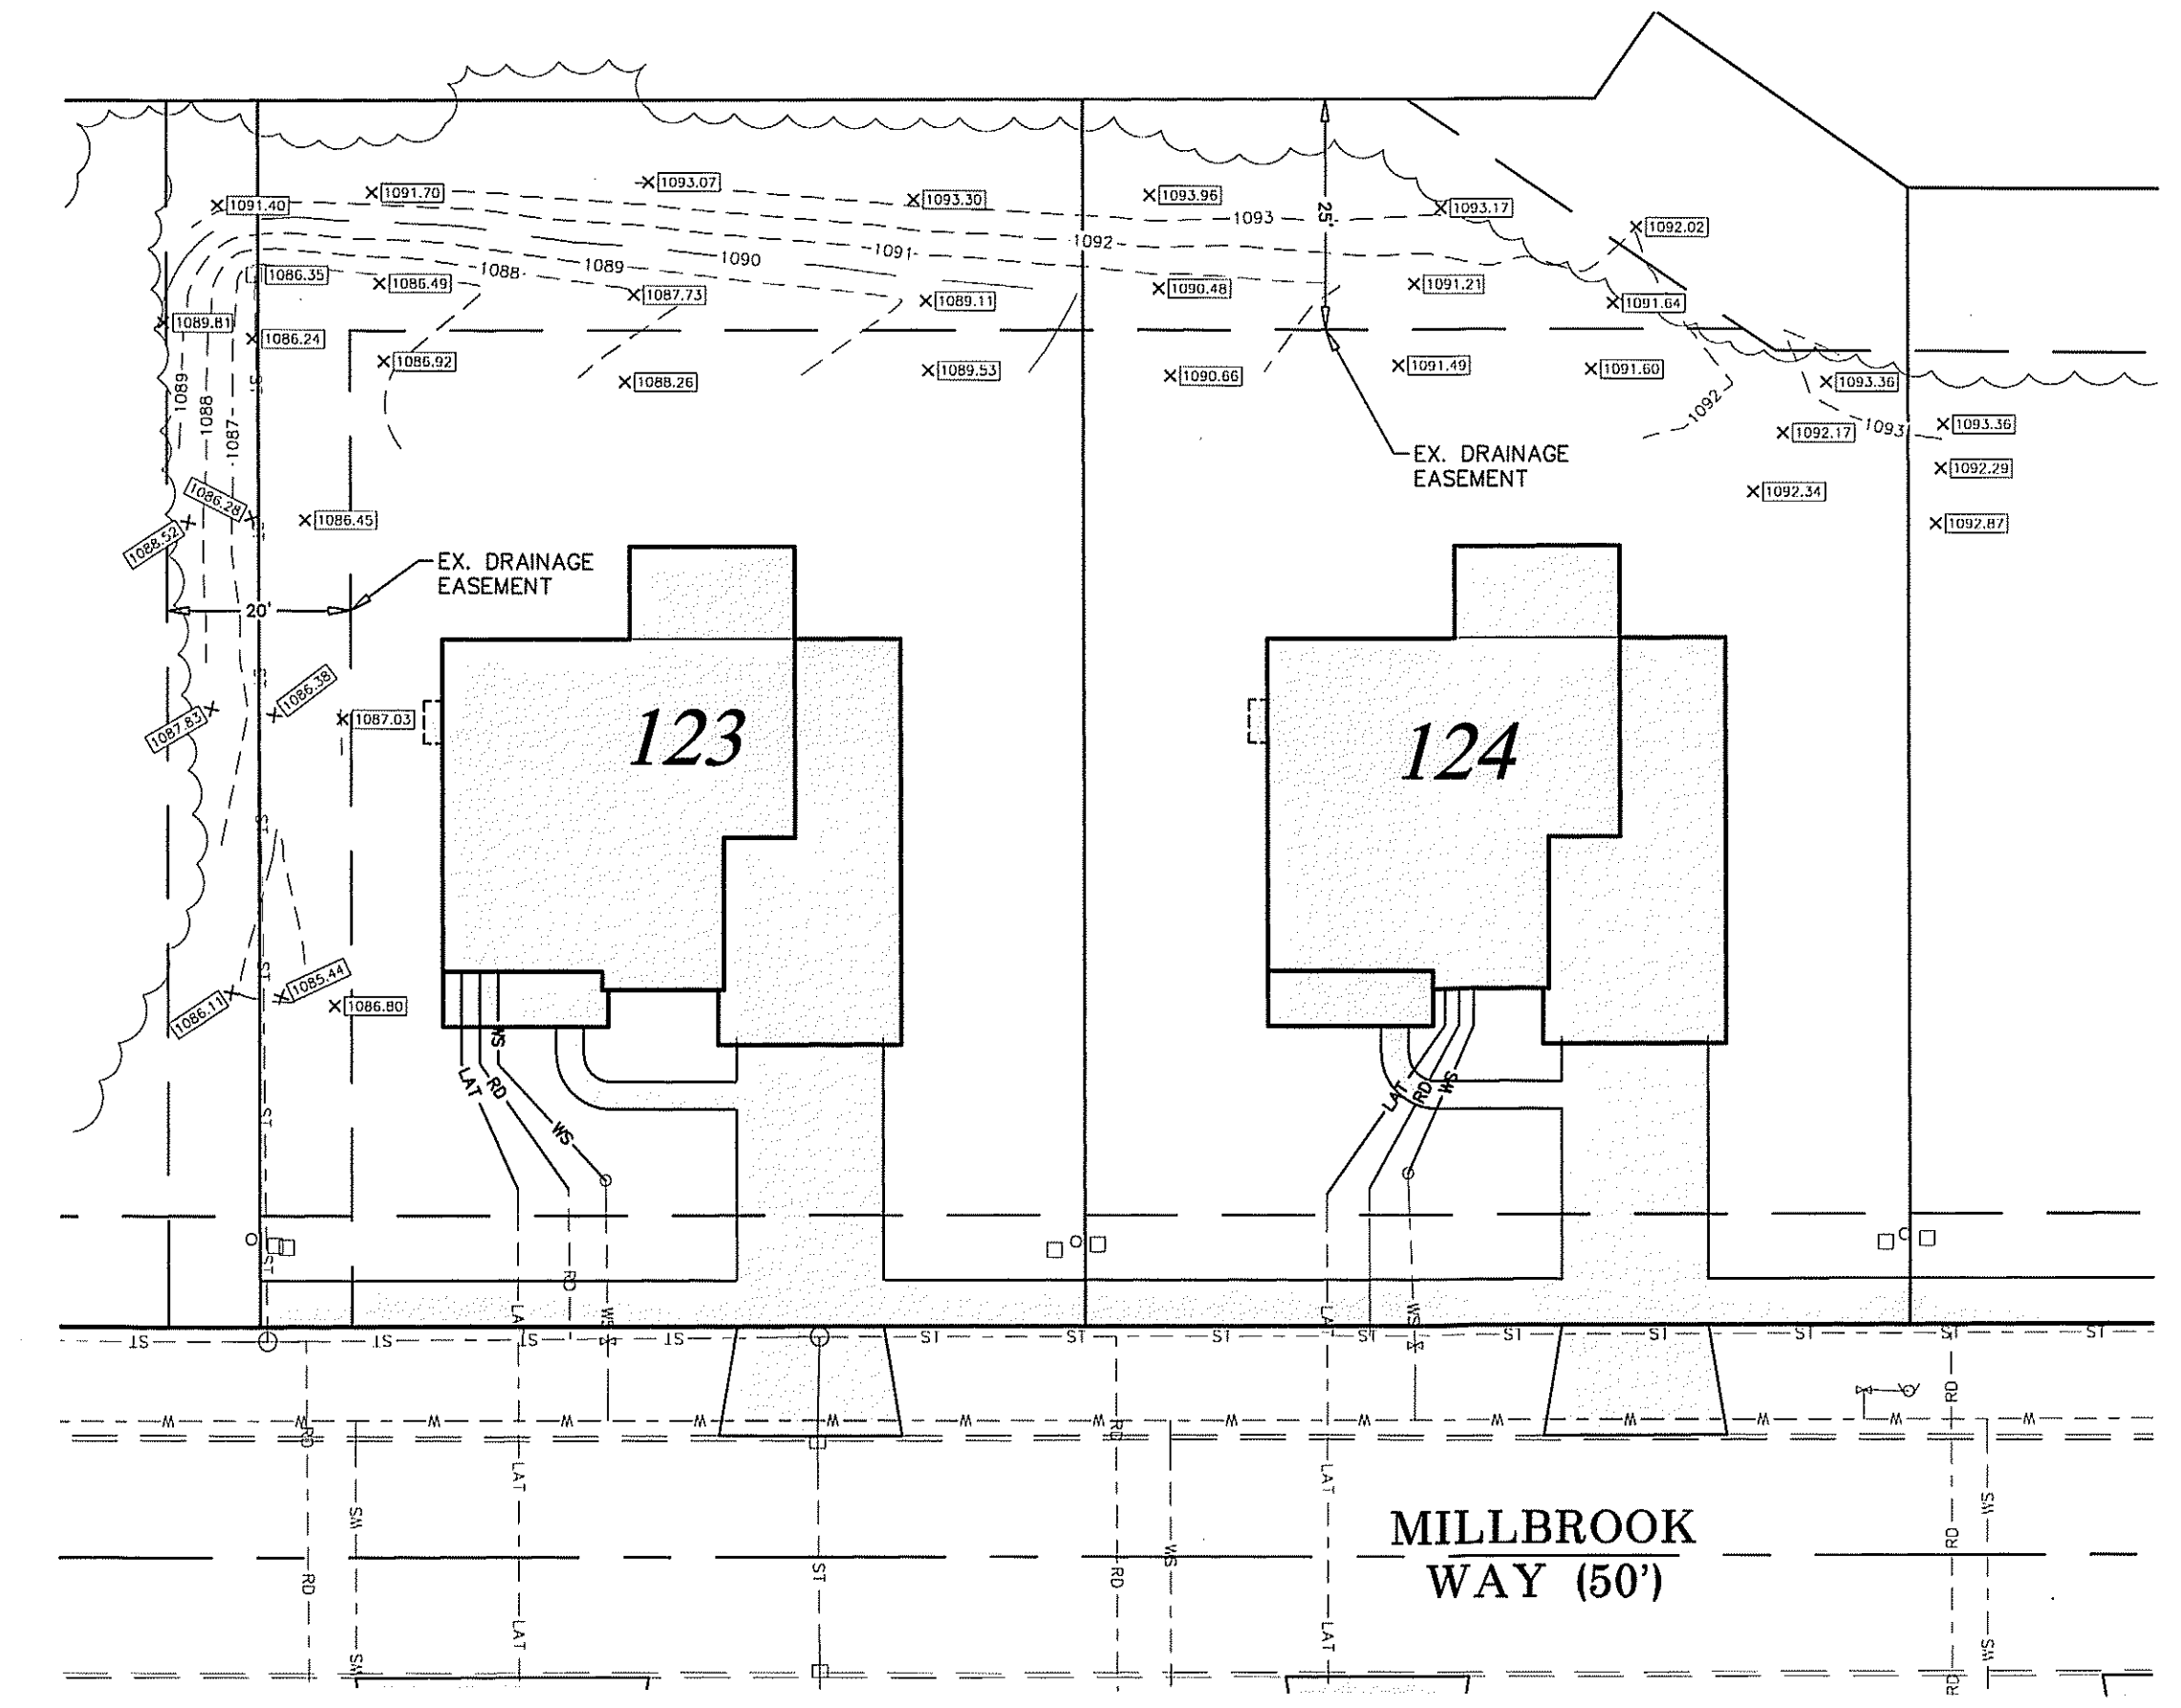


SCALE: 1" = 20'

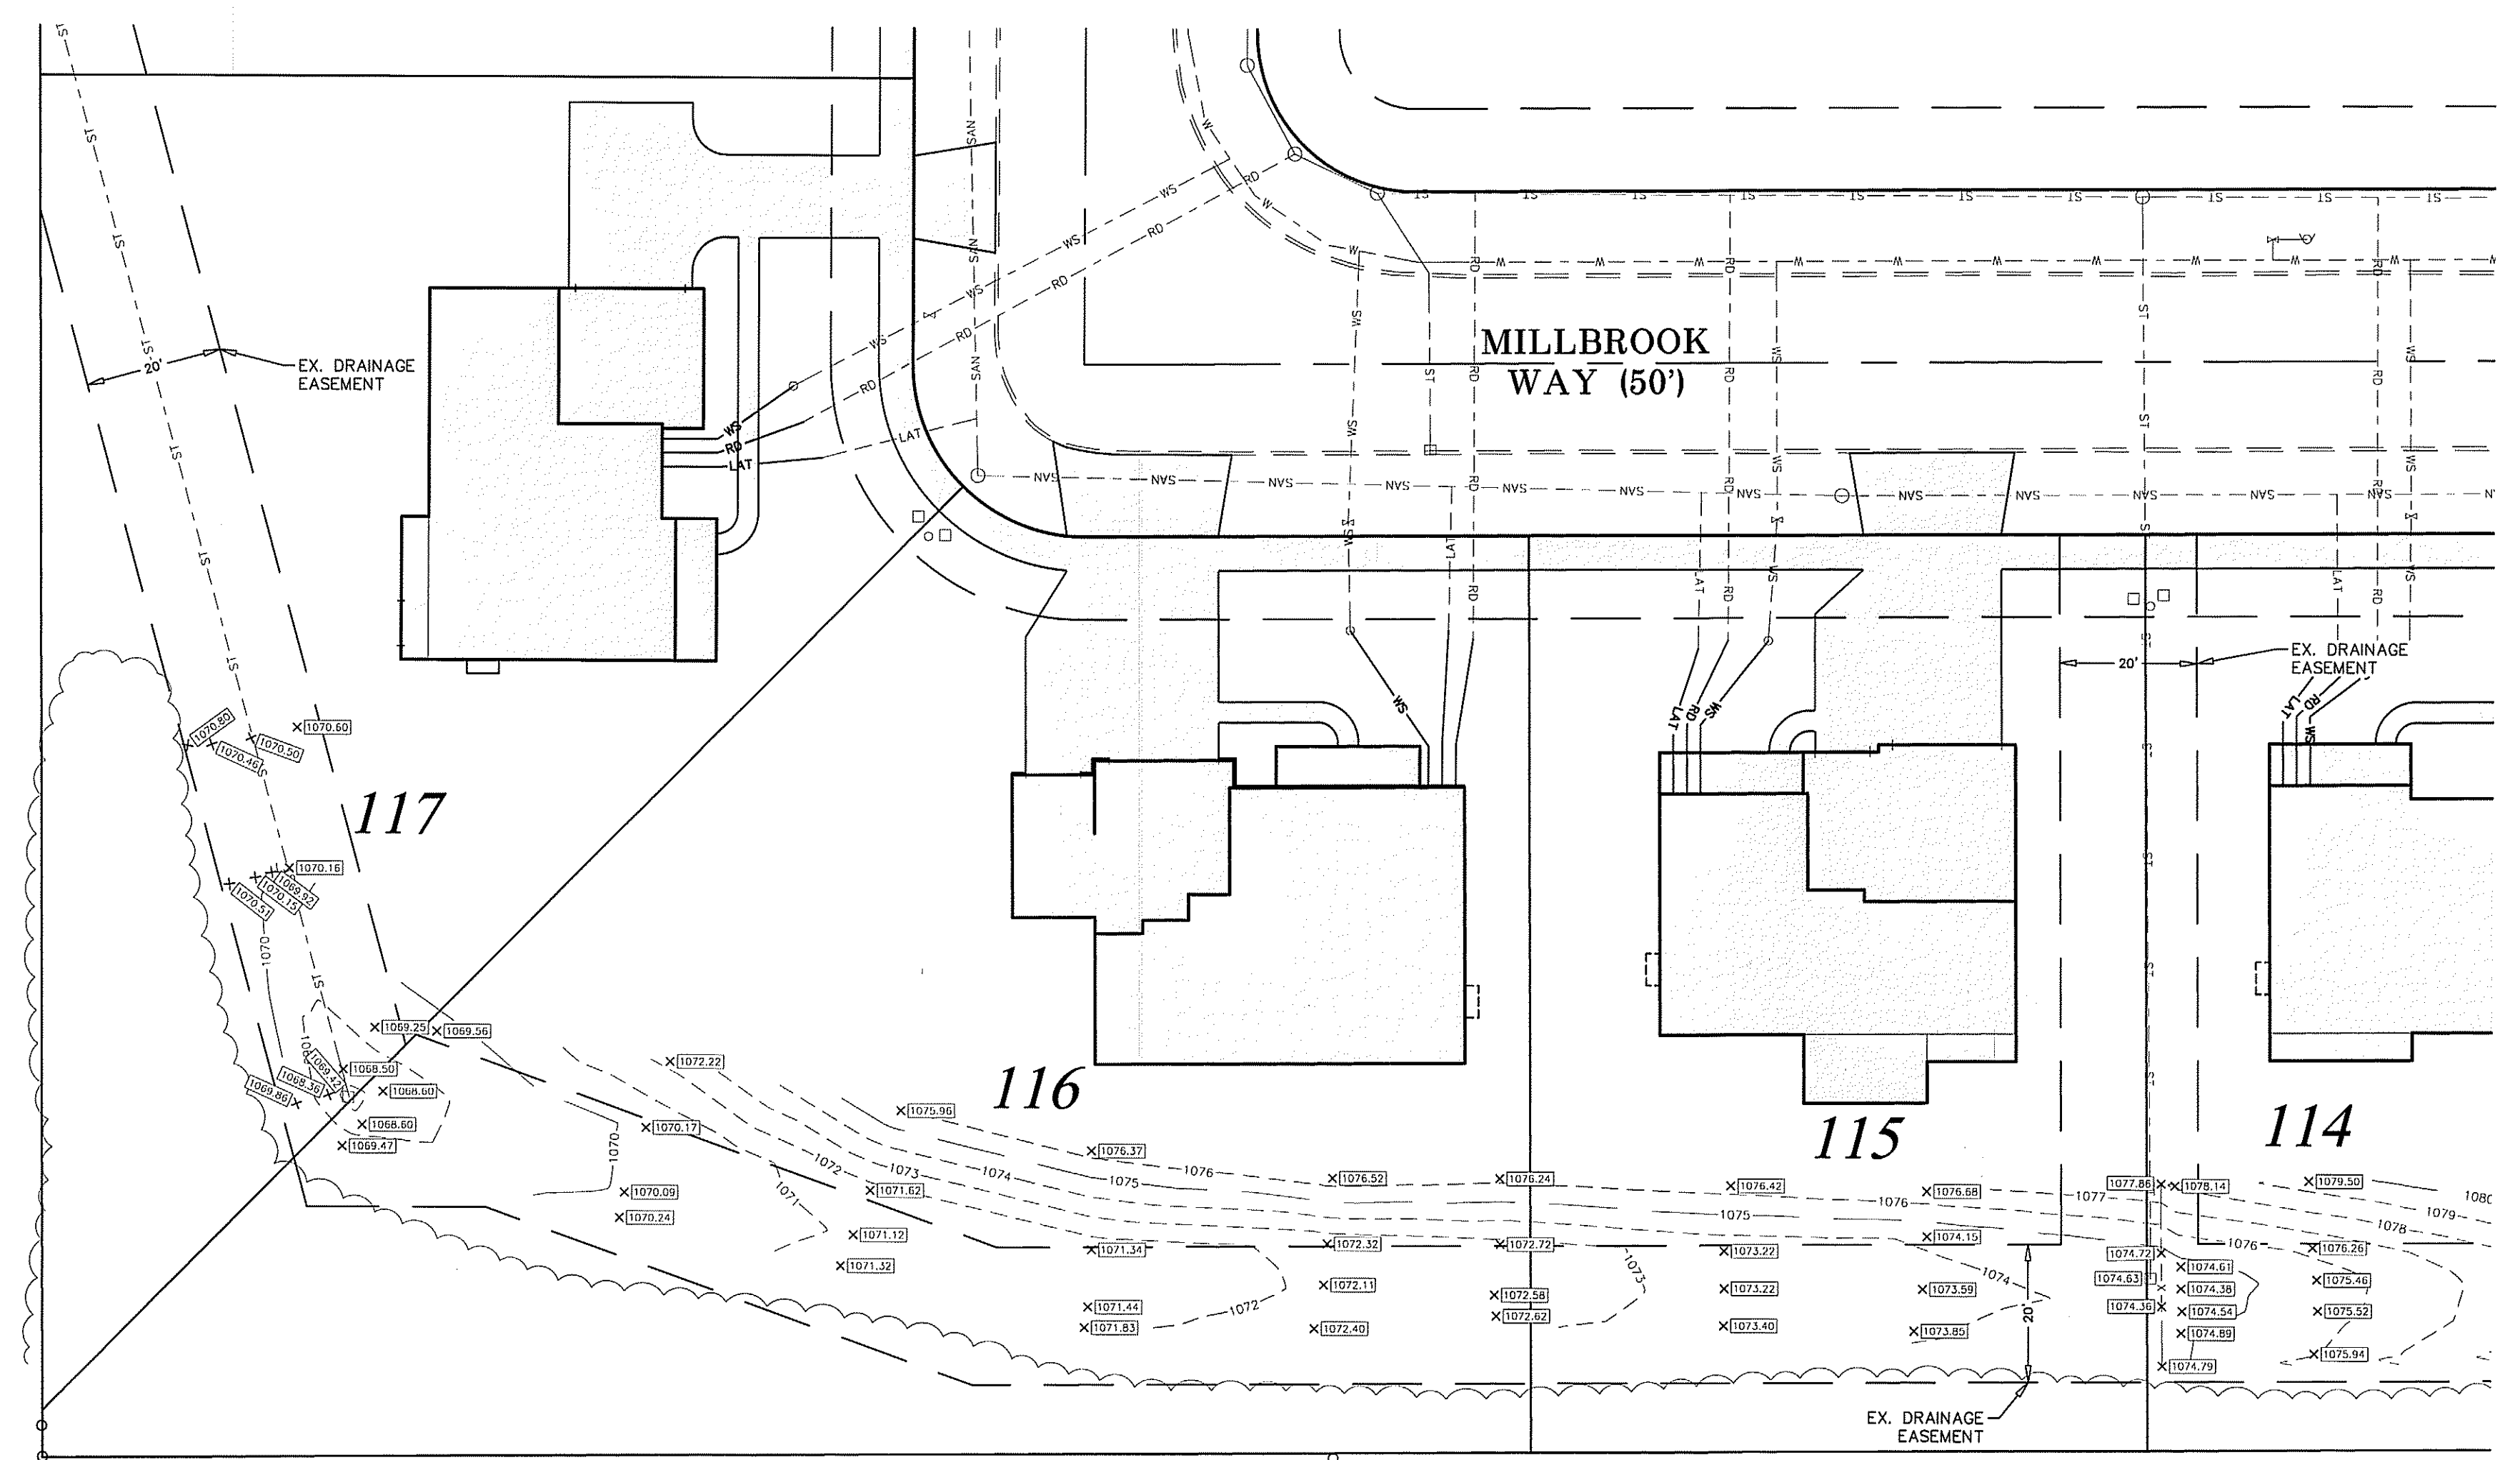

REVISIONS  
12/17/2019  
ADDITIONAL  
TOPO

**GBC DESIGN, INC.**  
Atrop, OH 44820-1128  
665 White Pond Dr.  
Phone 330-886-0228  
Fax 330-886-0782

**RYAN HOMES**  
6770 SNOWVILLE ROAD, SUITE 100  
BRECKSVILLE, OH 44141

HILLSIDE ESTATES PHASE 4  
COPLEY TOWNSHIP  
COUNTY OF SUMMIT, OHIO  
REAR YARD TOPO, LOTS 98-104,  
106-109 & 111-117

DRAWN BY:  
B.A.W.  
DATE:  
12/16/2019  
PROJECT NO.  
50259A-F  
DRAWING NO.  
2 OF 2