


INTERSECTION DETAIL

1 IN. = 10 FT.

STA. 26+04.18, 43.00' LT. WOOD FERN DR.=
 STA. 61+42.45, 37.46' LT. PORTAGE LINE RD
 $\Delta = 88^{\circ}44'20''$
 $R = 30'$
 $L = 46.46$
 $T = 29.35$
 $C = 41.96$
 $CB = N 44^{\circ}27'45'' E$

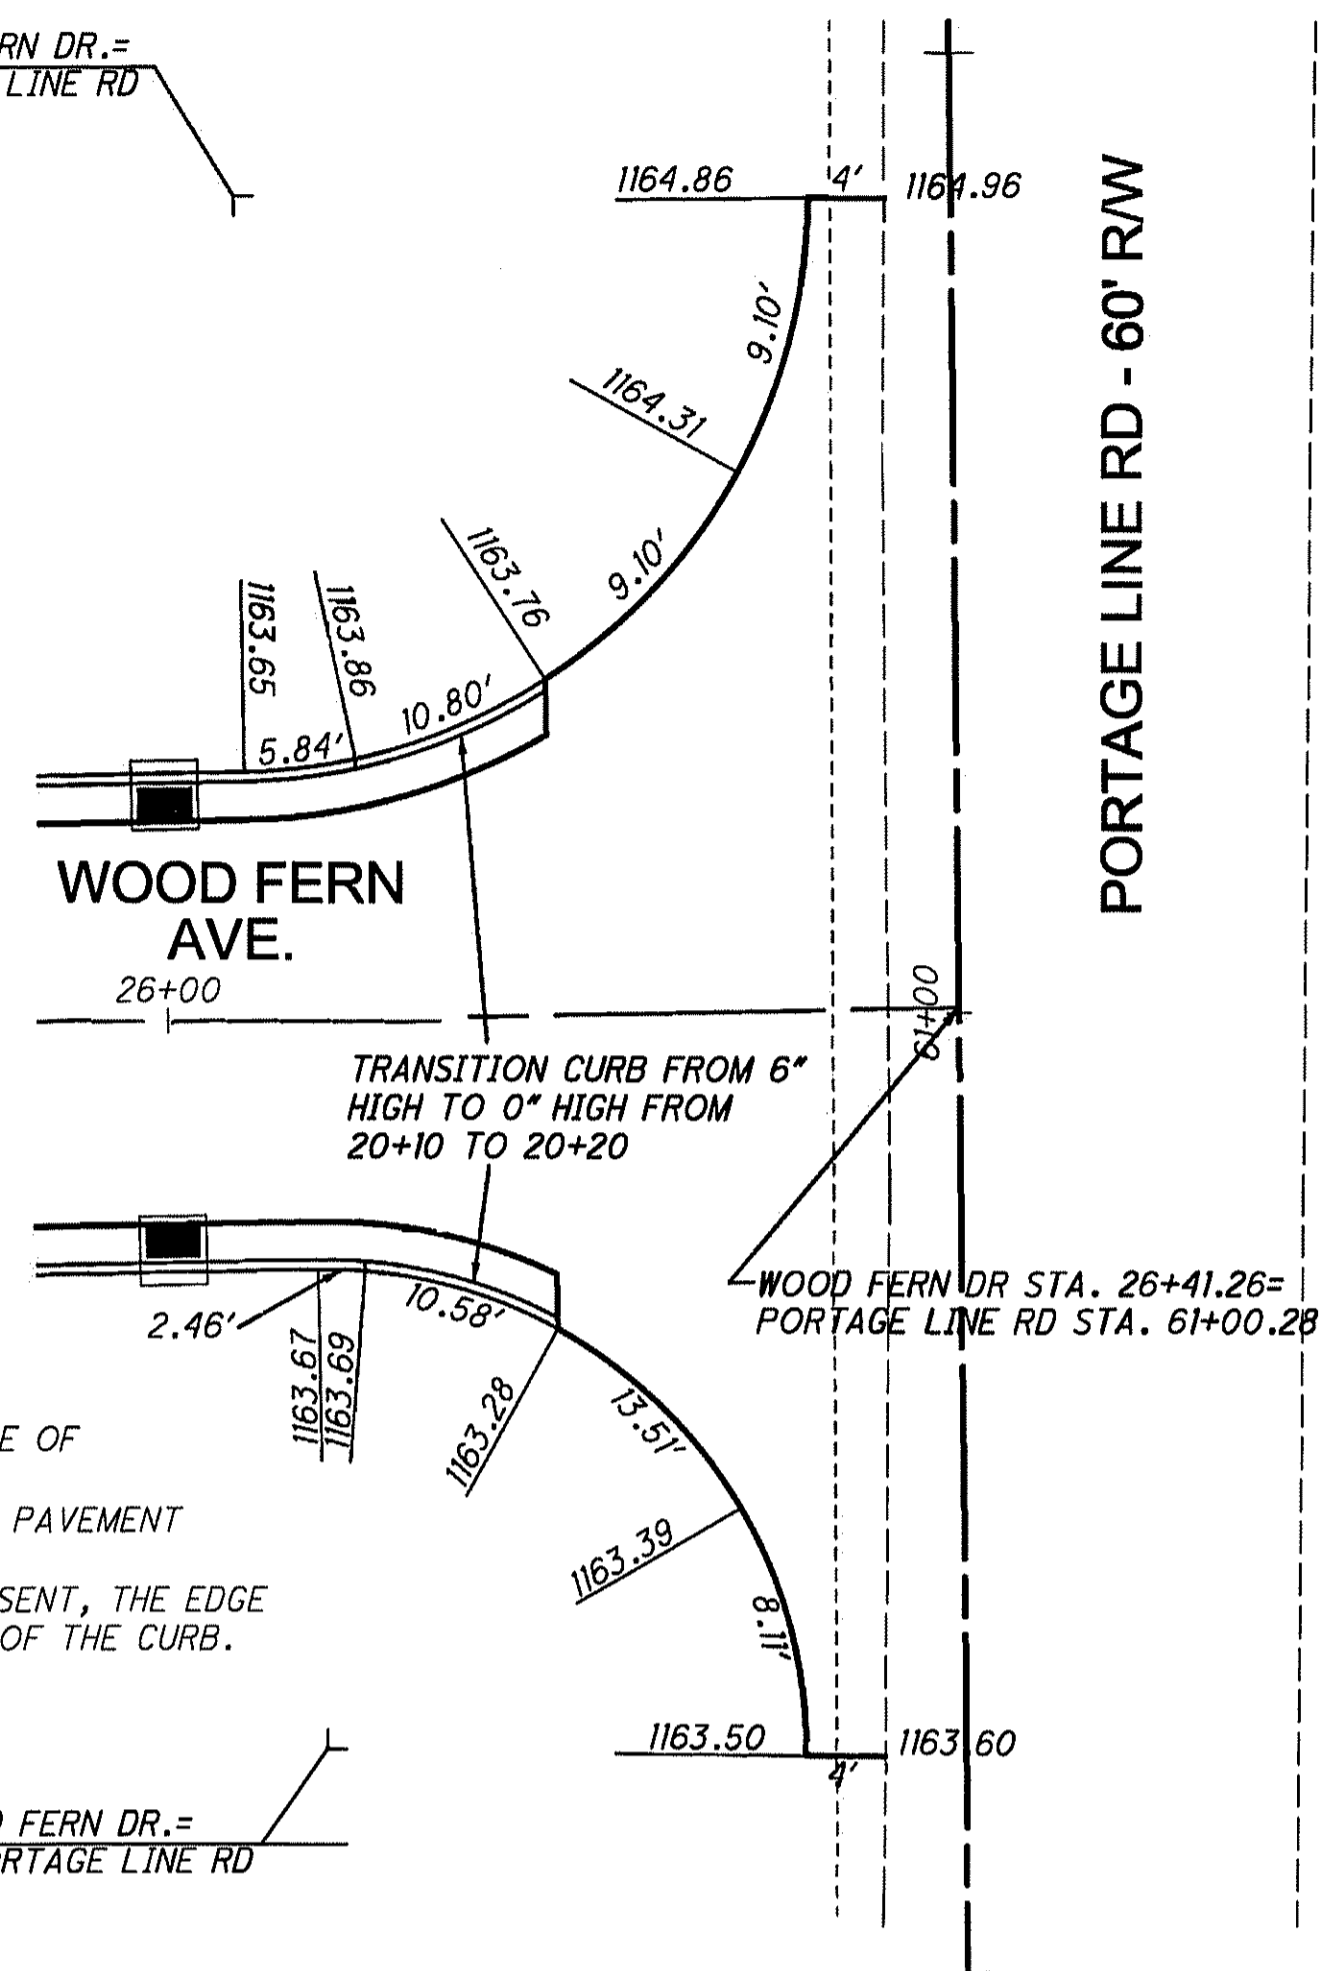


NOTES:

1. ALL ELEVATION ARE OF THE EDGE OF PAVEMENT (SEE NOTE 3 BELOW)
2. CURVE DATA IS OF THE EDGE OF PAVEMENT (SEE NOTE 3 BELOW)
3. WHERE CURB AND GUTTER IS PRESENT, THE EDGE OF PAVEMENT IS THE TOP EDGE OF THE CURB.


STA. 26+09.32, 38' RT. WOOD FERN DR.=
 STA. 60+61.59, 33.37' LT. PORTAGE LINE RD
 $\Delta = 91^{\circ}49'32''$
 $R = 25.0'$
 $L = 40.07$
 $T = 25.81$
 $C = 35.91$
 $CB = S 45^{\circ}15'19'' E$

DRAINAGE PROFILE - 15+56 to 15+57



*THE ODOT CB-3A MODIFIED IS A 4" DIAM. MH BASE (ODOT TYPE 3) WITH A CB-3A CASTING SET ON TOP.

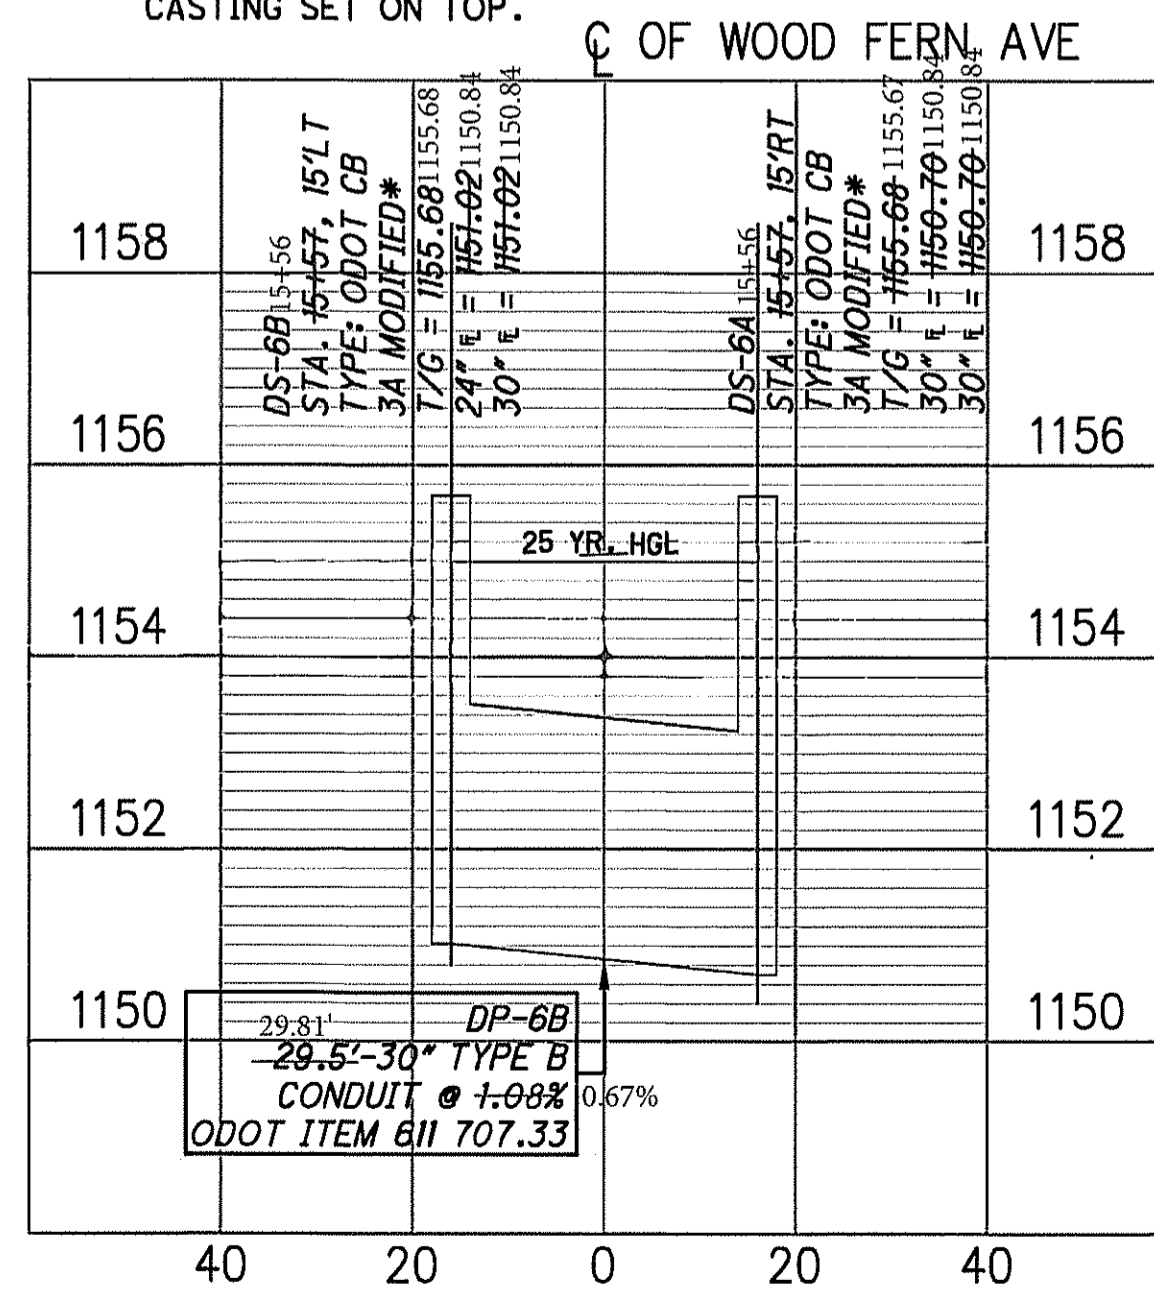

DRAINAGE PROFILE - 18+00

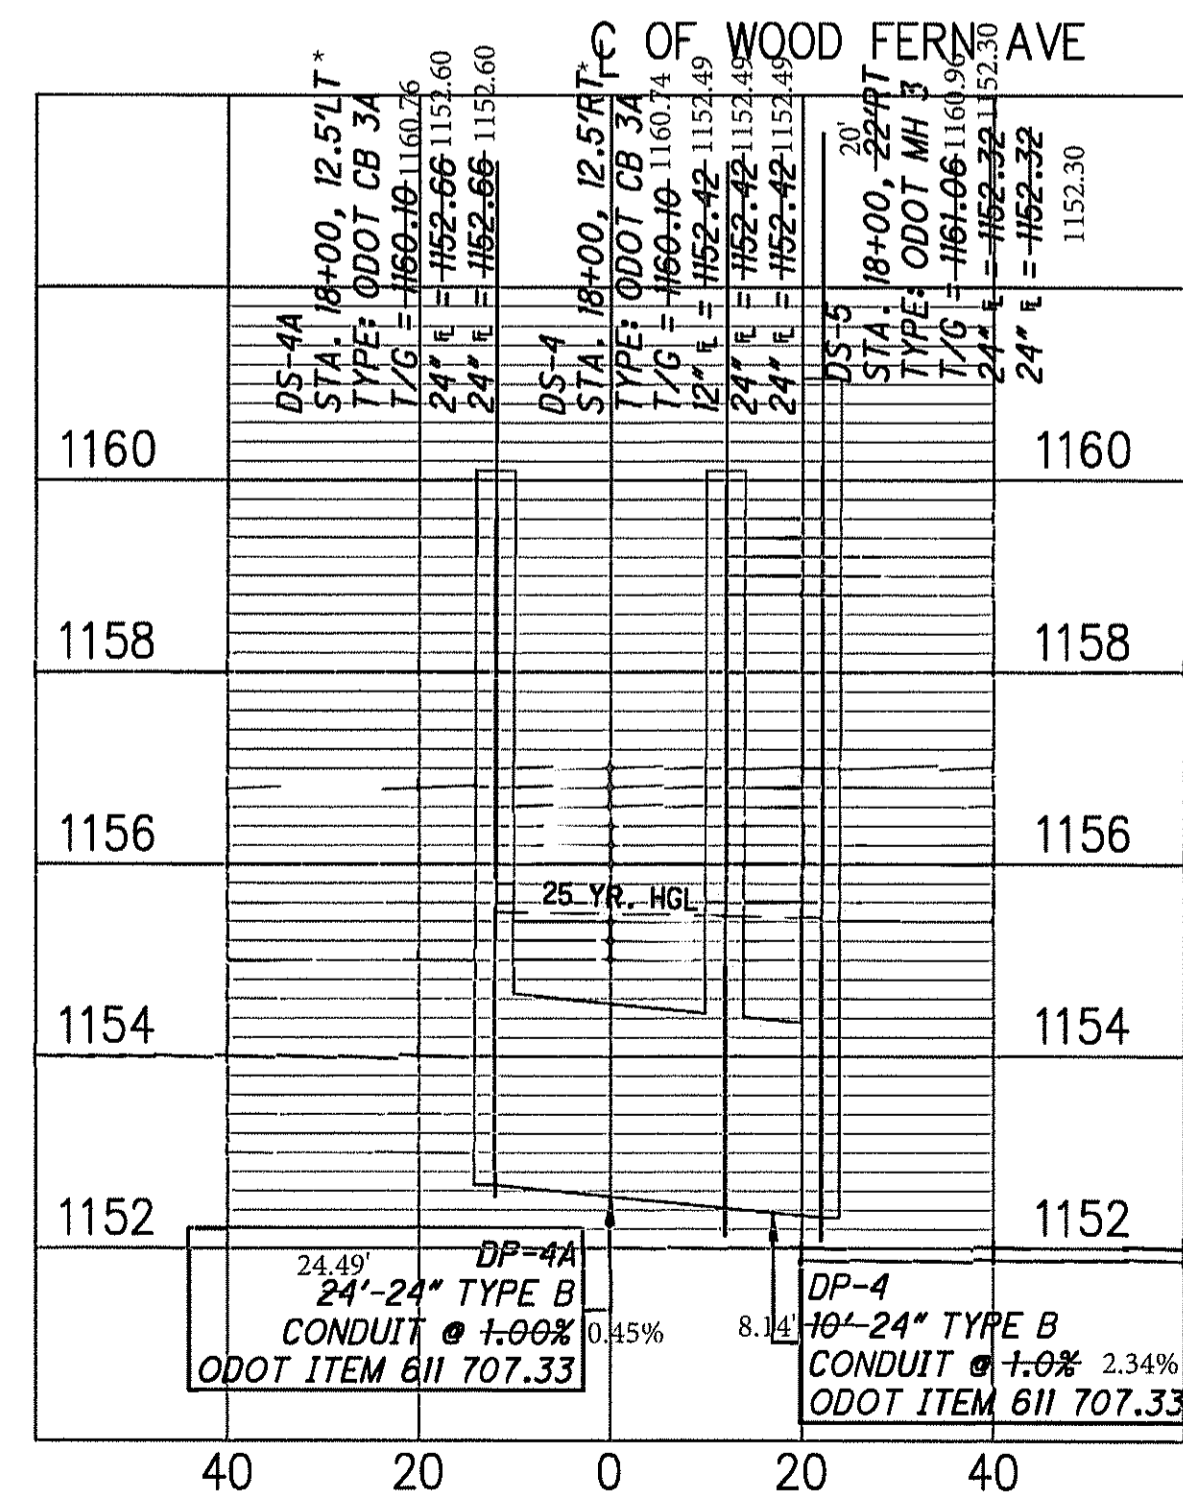

DRAINAGE PROFILE - 20+40

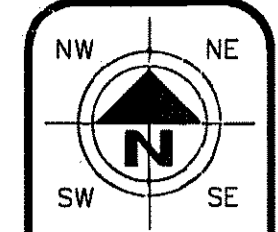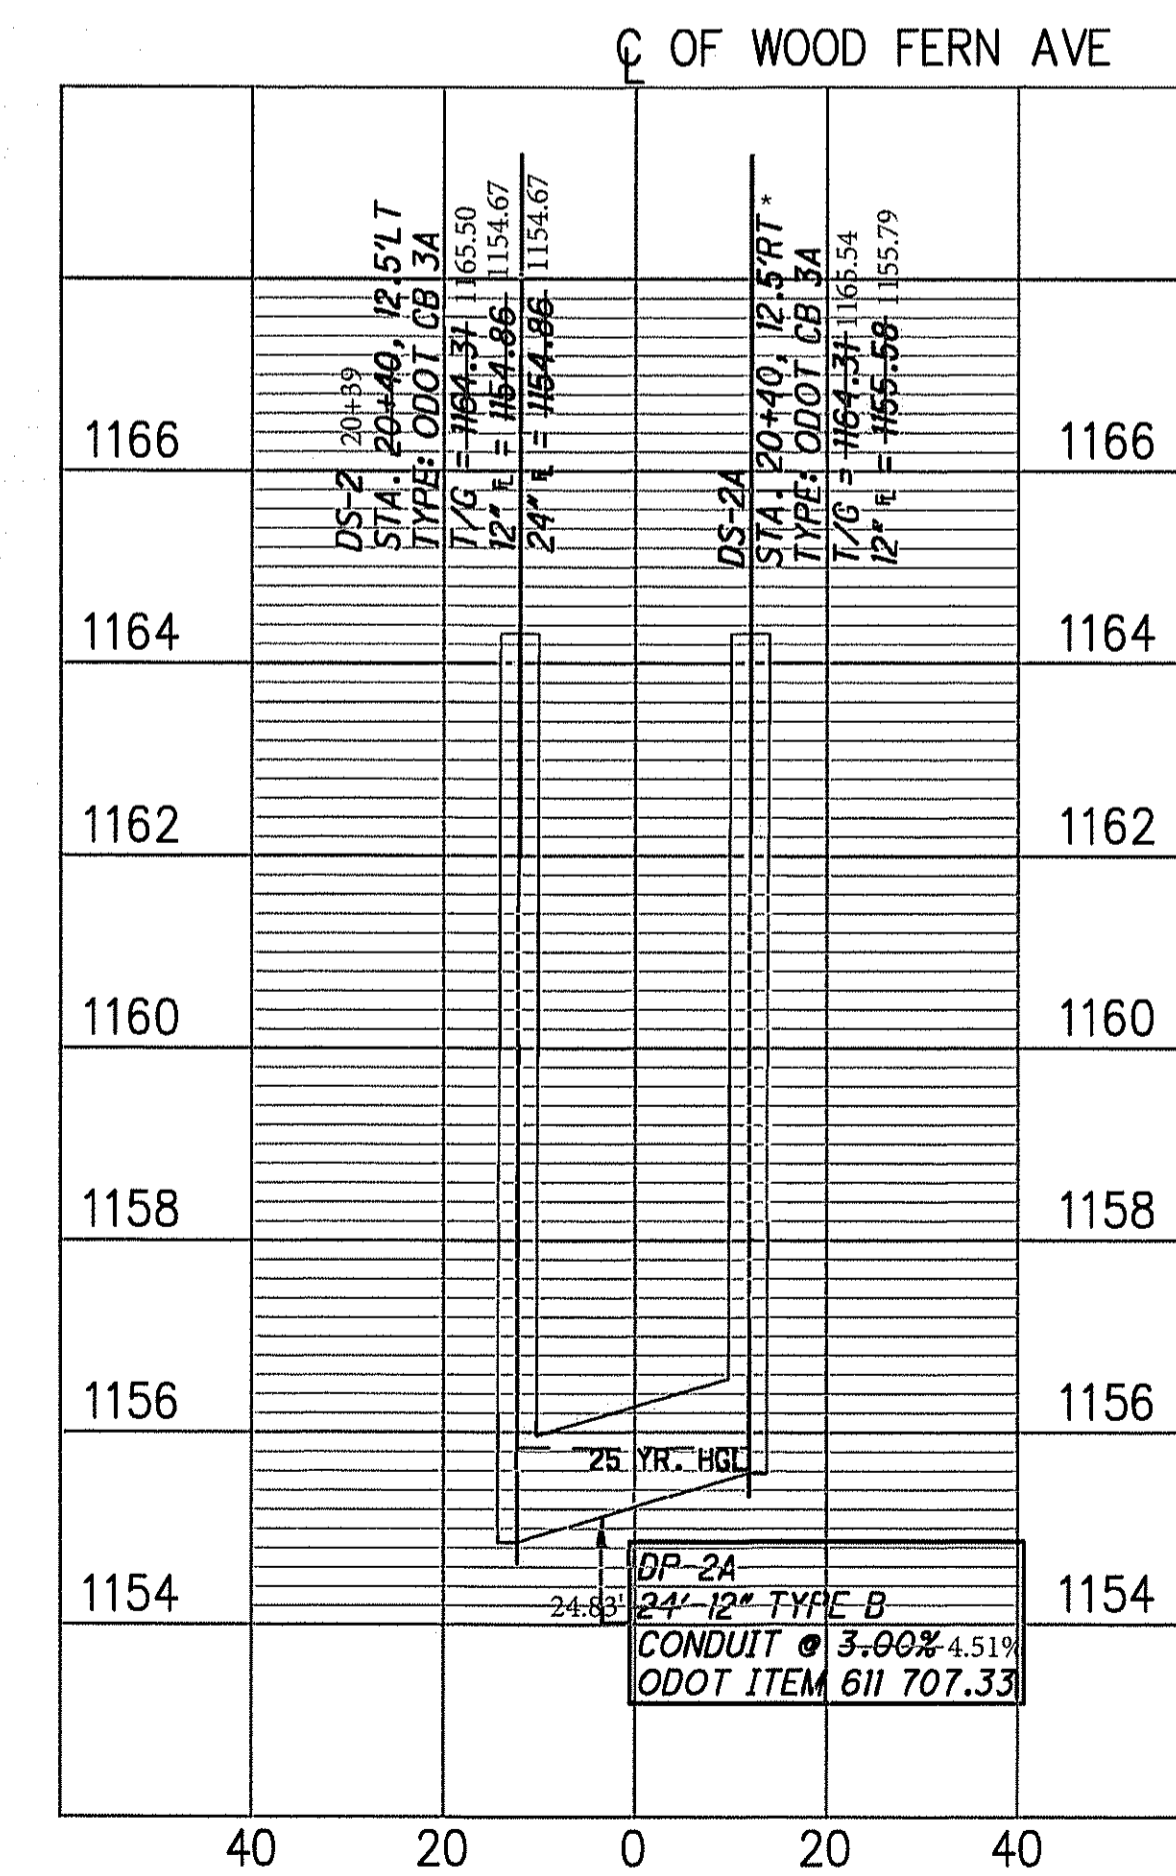


HORIZONTAL SCALE IN FEET
 0 5 10

CHECKED BY: KAD
 DATE: Feb, 2021
 DRAWN BY: BMH
 DATE: Feb, 2021

REVISIONS:	DATE	DESCRIPTION

Meadows of Wintergreen Phase 3
 Intersection Details and Drainage Sections
 Springfield Township
 Summit County, Ohio

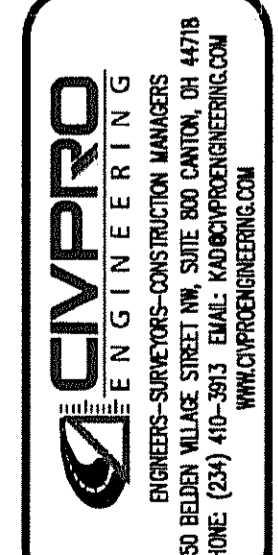

DRAWING NAME: SHT116-W3in1det.DWG
 REF NUMBER: