

NOTES

GENERAL: Catch Basins 2-3 and 2-4 are not intended for traffic bearing applications.

GRATE: See details on SCD CB-1.1.

If necessary, bicycle safe grates will be specified in the plans. Furnish Weath No. 6-4652-C or East Jordan No. 510 Type M3 bicycle safe grates or approved equals.

Cast the following text into the top of the grate:

"DUMP NO WASTE" and "DRAINS TO WATERWAY"

Print text in bold, capital letters at least 1/2" high. "WATERWAY" may be substituted with "STREAM", "RIVER", "LAKE", etc. Actual placement and logo may vary per manufacturer.

WALLS: Construct brick or cast-in-place walls with a nominal 6" thickness. Provide precast walls at least 6" thick with sufficient reinforcing to permit shipping and handling without damage.

STEPS: Provide steps where the depth exceeds 6". Meet the requirements of SCD MH-1.1.

CONCRETE: Use 4000 psi compressive strength for cast-in-place concrete. Meet the requirements of AWS 705.13 for all precast concrete and mark with the catch basin number.

REINFORCEMENT: Provide #4 bars spaced at 6" center to center for top reinforcing. For Catch Basin No. 2-4 use twelve bars.

INLETS OVER 12 FEET DEEP: Use precast or cast-in-place concrete; reinforce with #4 bars on 12" centers both vertically and horizontally with 2" clearance from inside wall face.

PRECAST BASE: If a precast base is used, set it deep enough so that the top can be placed on the base to provide the grate elevation specified in the plans. Do not use brick layers to adjust the top elevation.


LOCATION AND ELEVATION: When given on the plans, the location and the elevation are of the top center of the grate. When side openings are provided, the elevation is of the flow line of the side inlet.

MINIMUM DEPTH: The minimum depth of CB No. 2-3 and CB No. 2-4 is the outside diameter (O.D.) of the outlet pipe plus 2".

OPENINGS: Ensure pipe openings are the O.D. of the pipe being supplied plus 2" when fabricated or field cut. Fill any voids per C&MS 611.





SIDE INLETS: Provide inlets on both sides of the No. 2-3 and 2-4 catch basin in sags and on upstream side only where the ditch has a continuous down grade past the catch basin. Do not use catch basins with side inlets within the Clear Zone.

PAYMENT: All materials and labor, including excavation and backfill, are paid for under Item 611 - Catch Basin, No. 2-4.

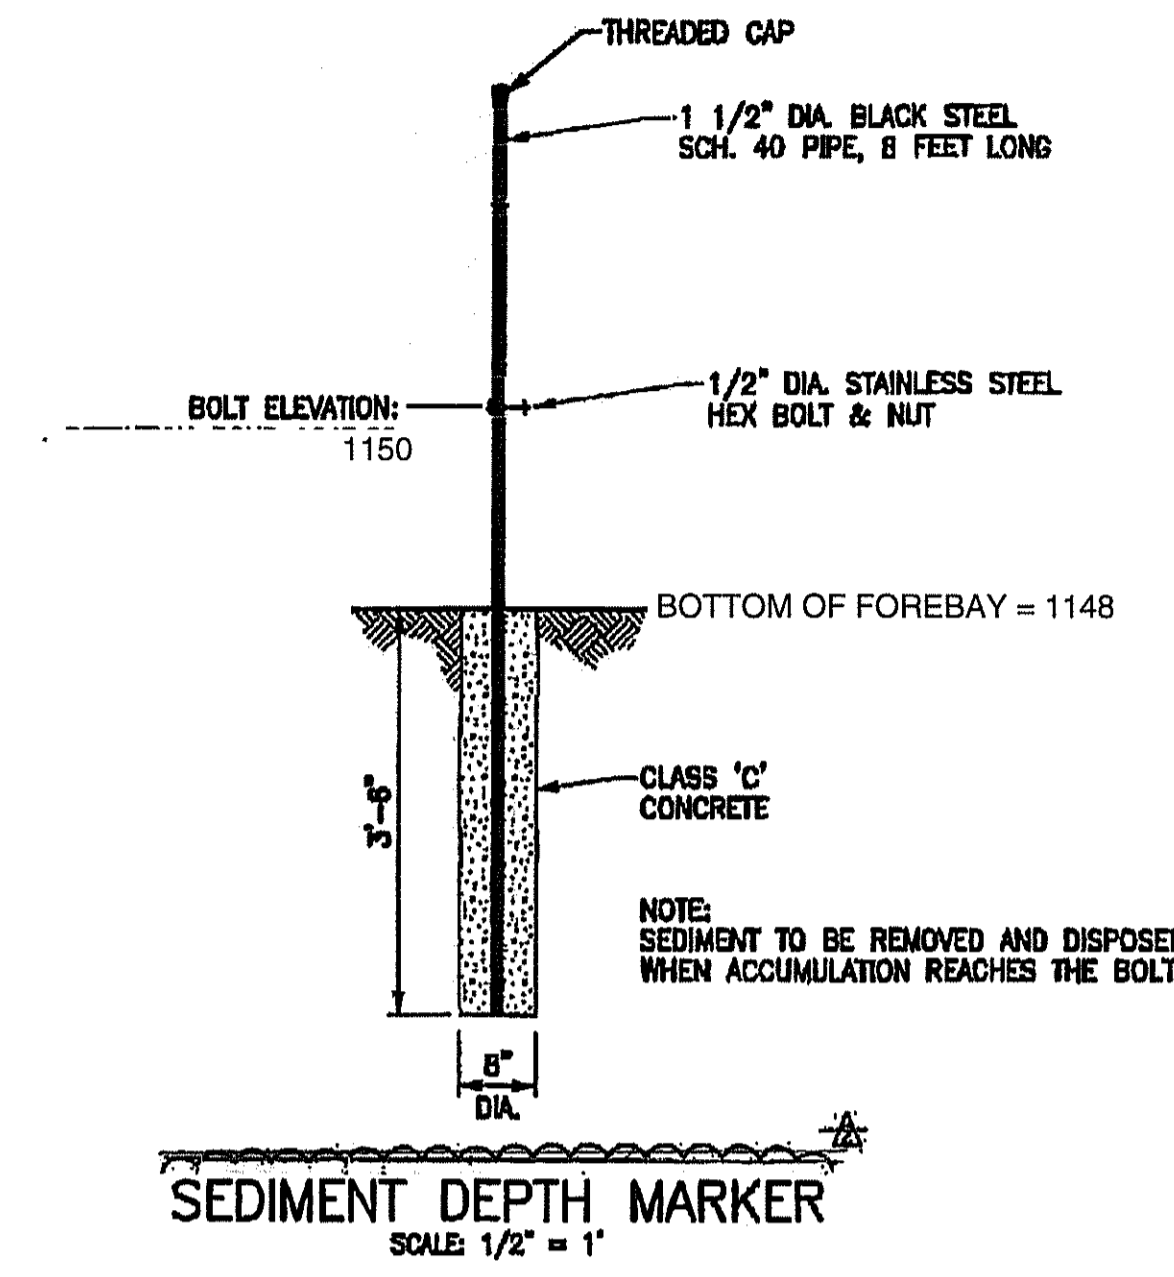

THE FAIRCLOTH SKIMMER SHALL BE USED TO CONTROL THE DETENTION POND DISCHARGE RATE UNTIL THE DRAINAGE AREA IS RESTABILIZED. THE 4" ORIFICE @ 1150.00 WILL BE USED FOR THE SKIMMER CONNECTION. WHILE THE DRAINAGE AREA IS DESTABILIZED AND THE SKIMMER IS IN USE, THE CONTRACTOR SHALL HAVE THE 6" H X 13" W ORIFICE AND THE THREE 9.2" H X 38" W ORIFICES PLUGGED. ONCE THE DRAINAGE AREA IS RESTABILIZED, THE SKIMMER SHALL BE REMOVED AND THE 4" ORIFICE SHALL BE CONVERTED TO A NON-CLOG WATER QUALITY ORIFICE (SEE NON-CLOG OUTLET DETAIL). ADDITIONALLY, WATER PLUGS SHALL BE REMOVED FROM ALL ORIFICES. THE CONTRACTOR SHALL ALSO REMOVE THE SEDIMENT THAT ACCUMULATED IN THE FOREBAY AND MICROPOOL WHILE THE DRAINAGE AREA WAS DESTABILIZED. FOREBAY AND MICROPOOL DEPTHS SHOULD BE RESTORED TO THE ORIGINAL DESIGN GRADES SHOWN ON THE PREVIOUS SHEET.

SEDIMENT BASIN DESIGN CALCULATIONS ARE PROVIDED IN THE STORMWATER REPORT.

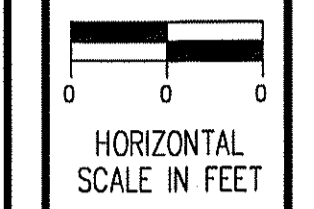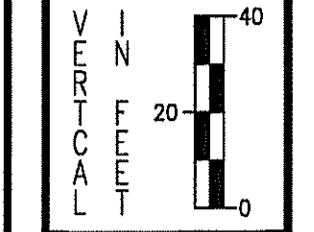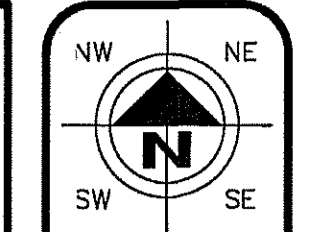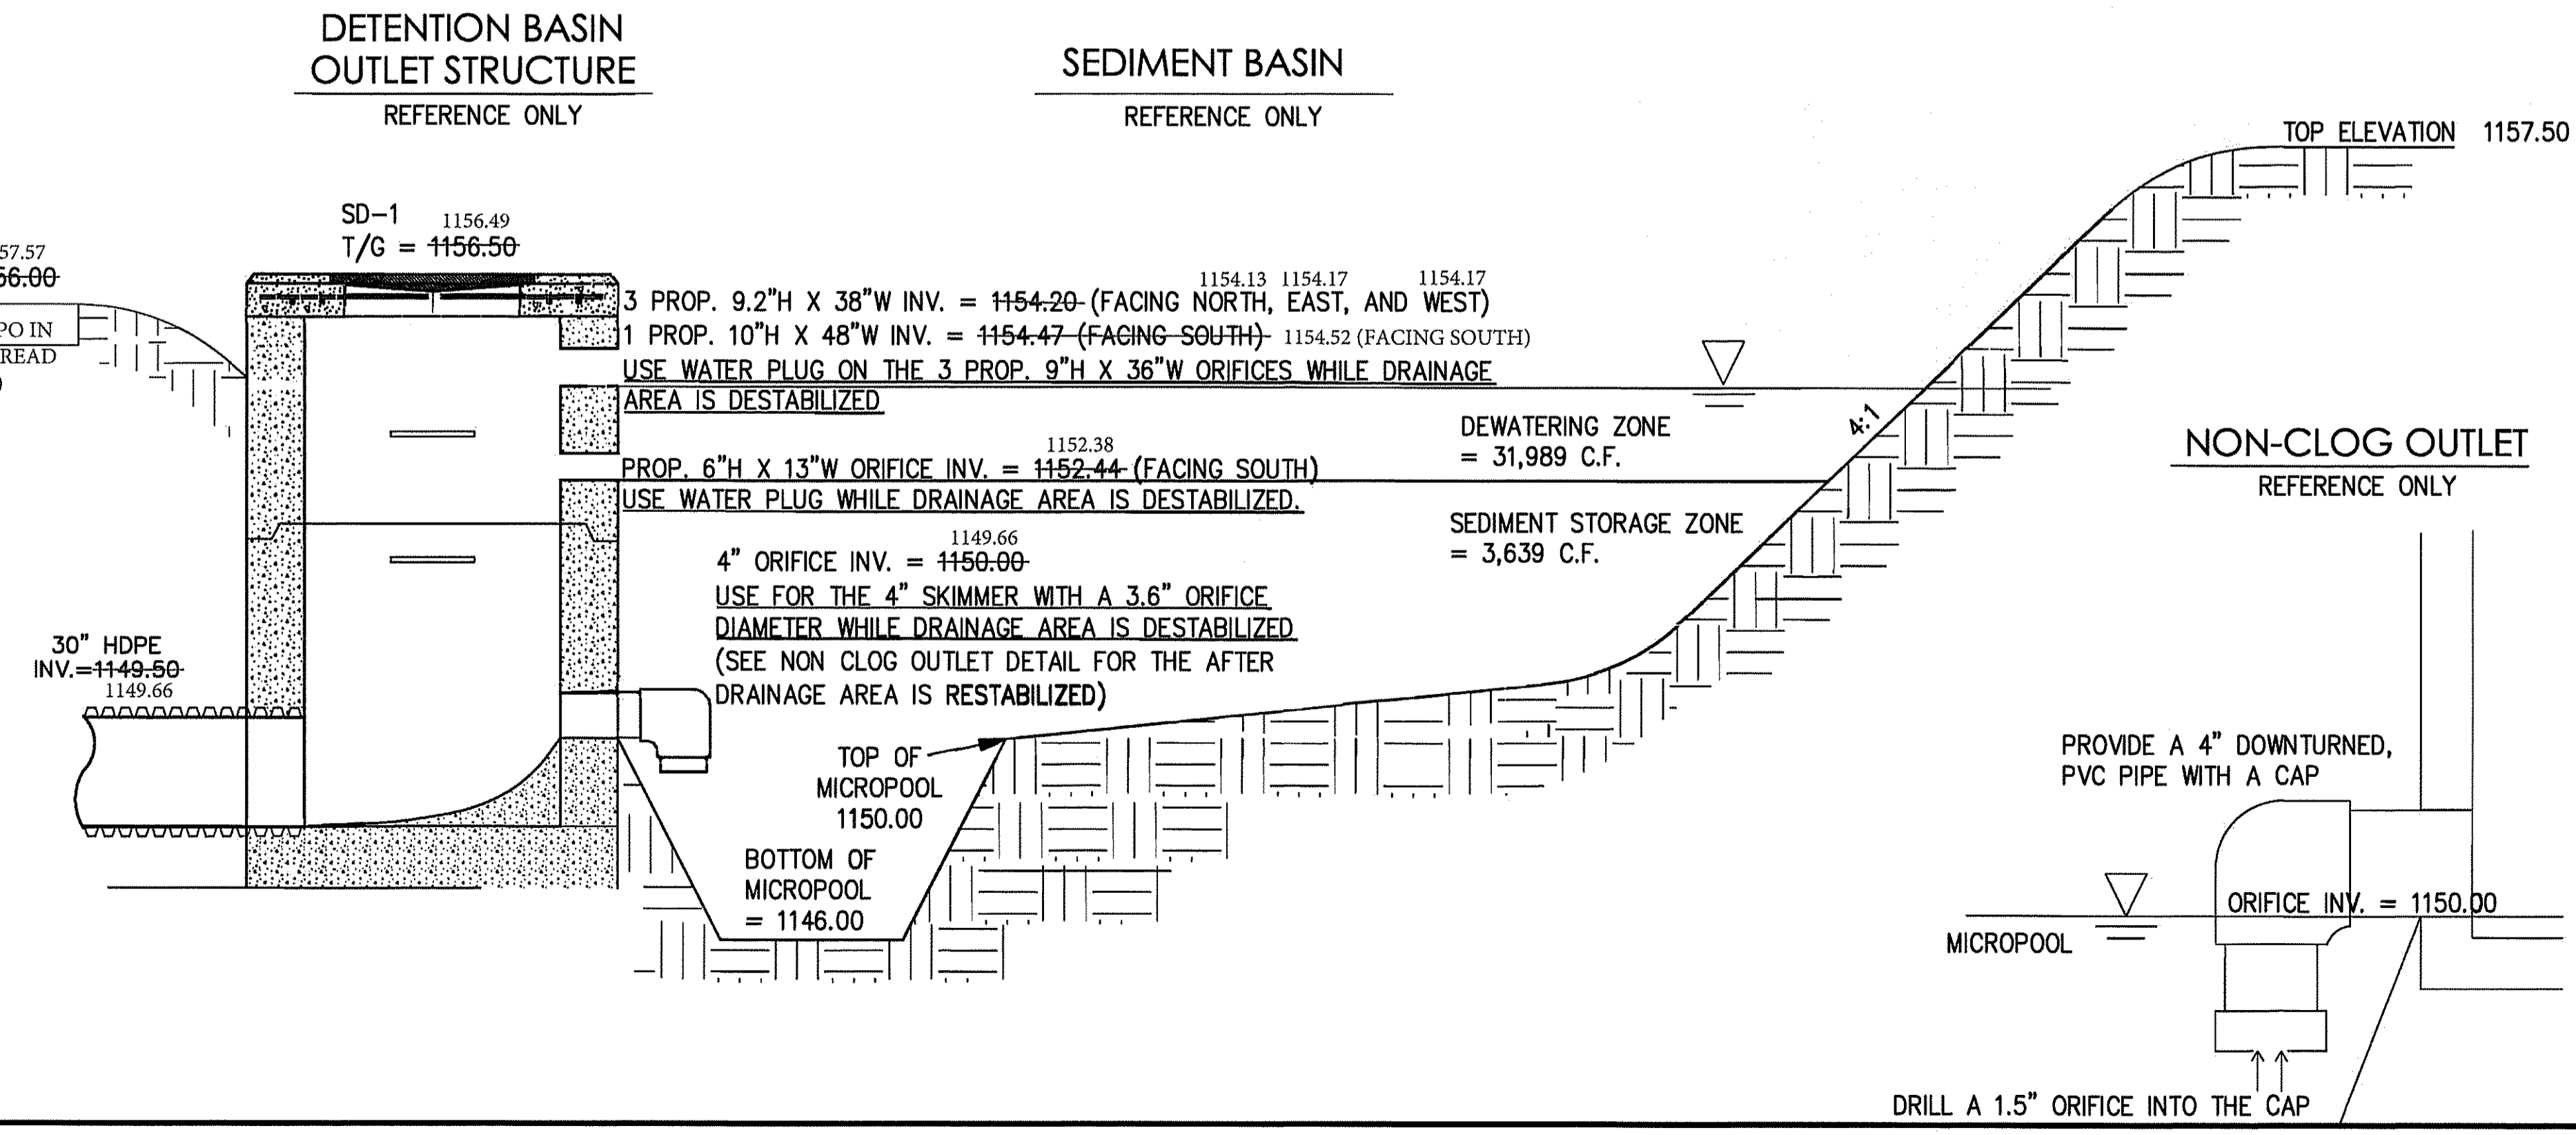

CHECKED BY:	KAD
DATE:	Mar, 2021
DRAWN BY:	BMH
DATE:	Mar, 2021
REVISIONS:	
DATE	DESCRIPTION

Meadows of Wintergreen Phase 3
 West Detention Basin Details
 Township of Springfield
 Summit County, Ohio

CIVPRO
 ENGINEERING
 ENGINEERS-SURVEYORS-CONSULTING MANAGERS
 4450 BELLEVUE VILLAGE STREET, SUITE 800 CANTON, OH 44705
 PHONE: (216) 402-3913, EMAIL: INFO@CIVPROENGINEERING.COM
 WWW.CIVPROENGINEERING.COM

DRAWING NAME:
 PROJECT NUMBER: