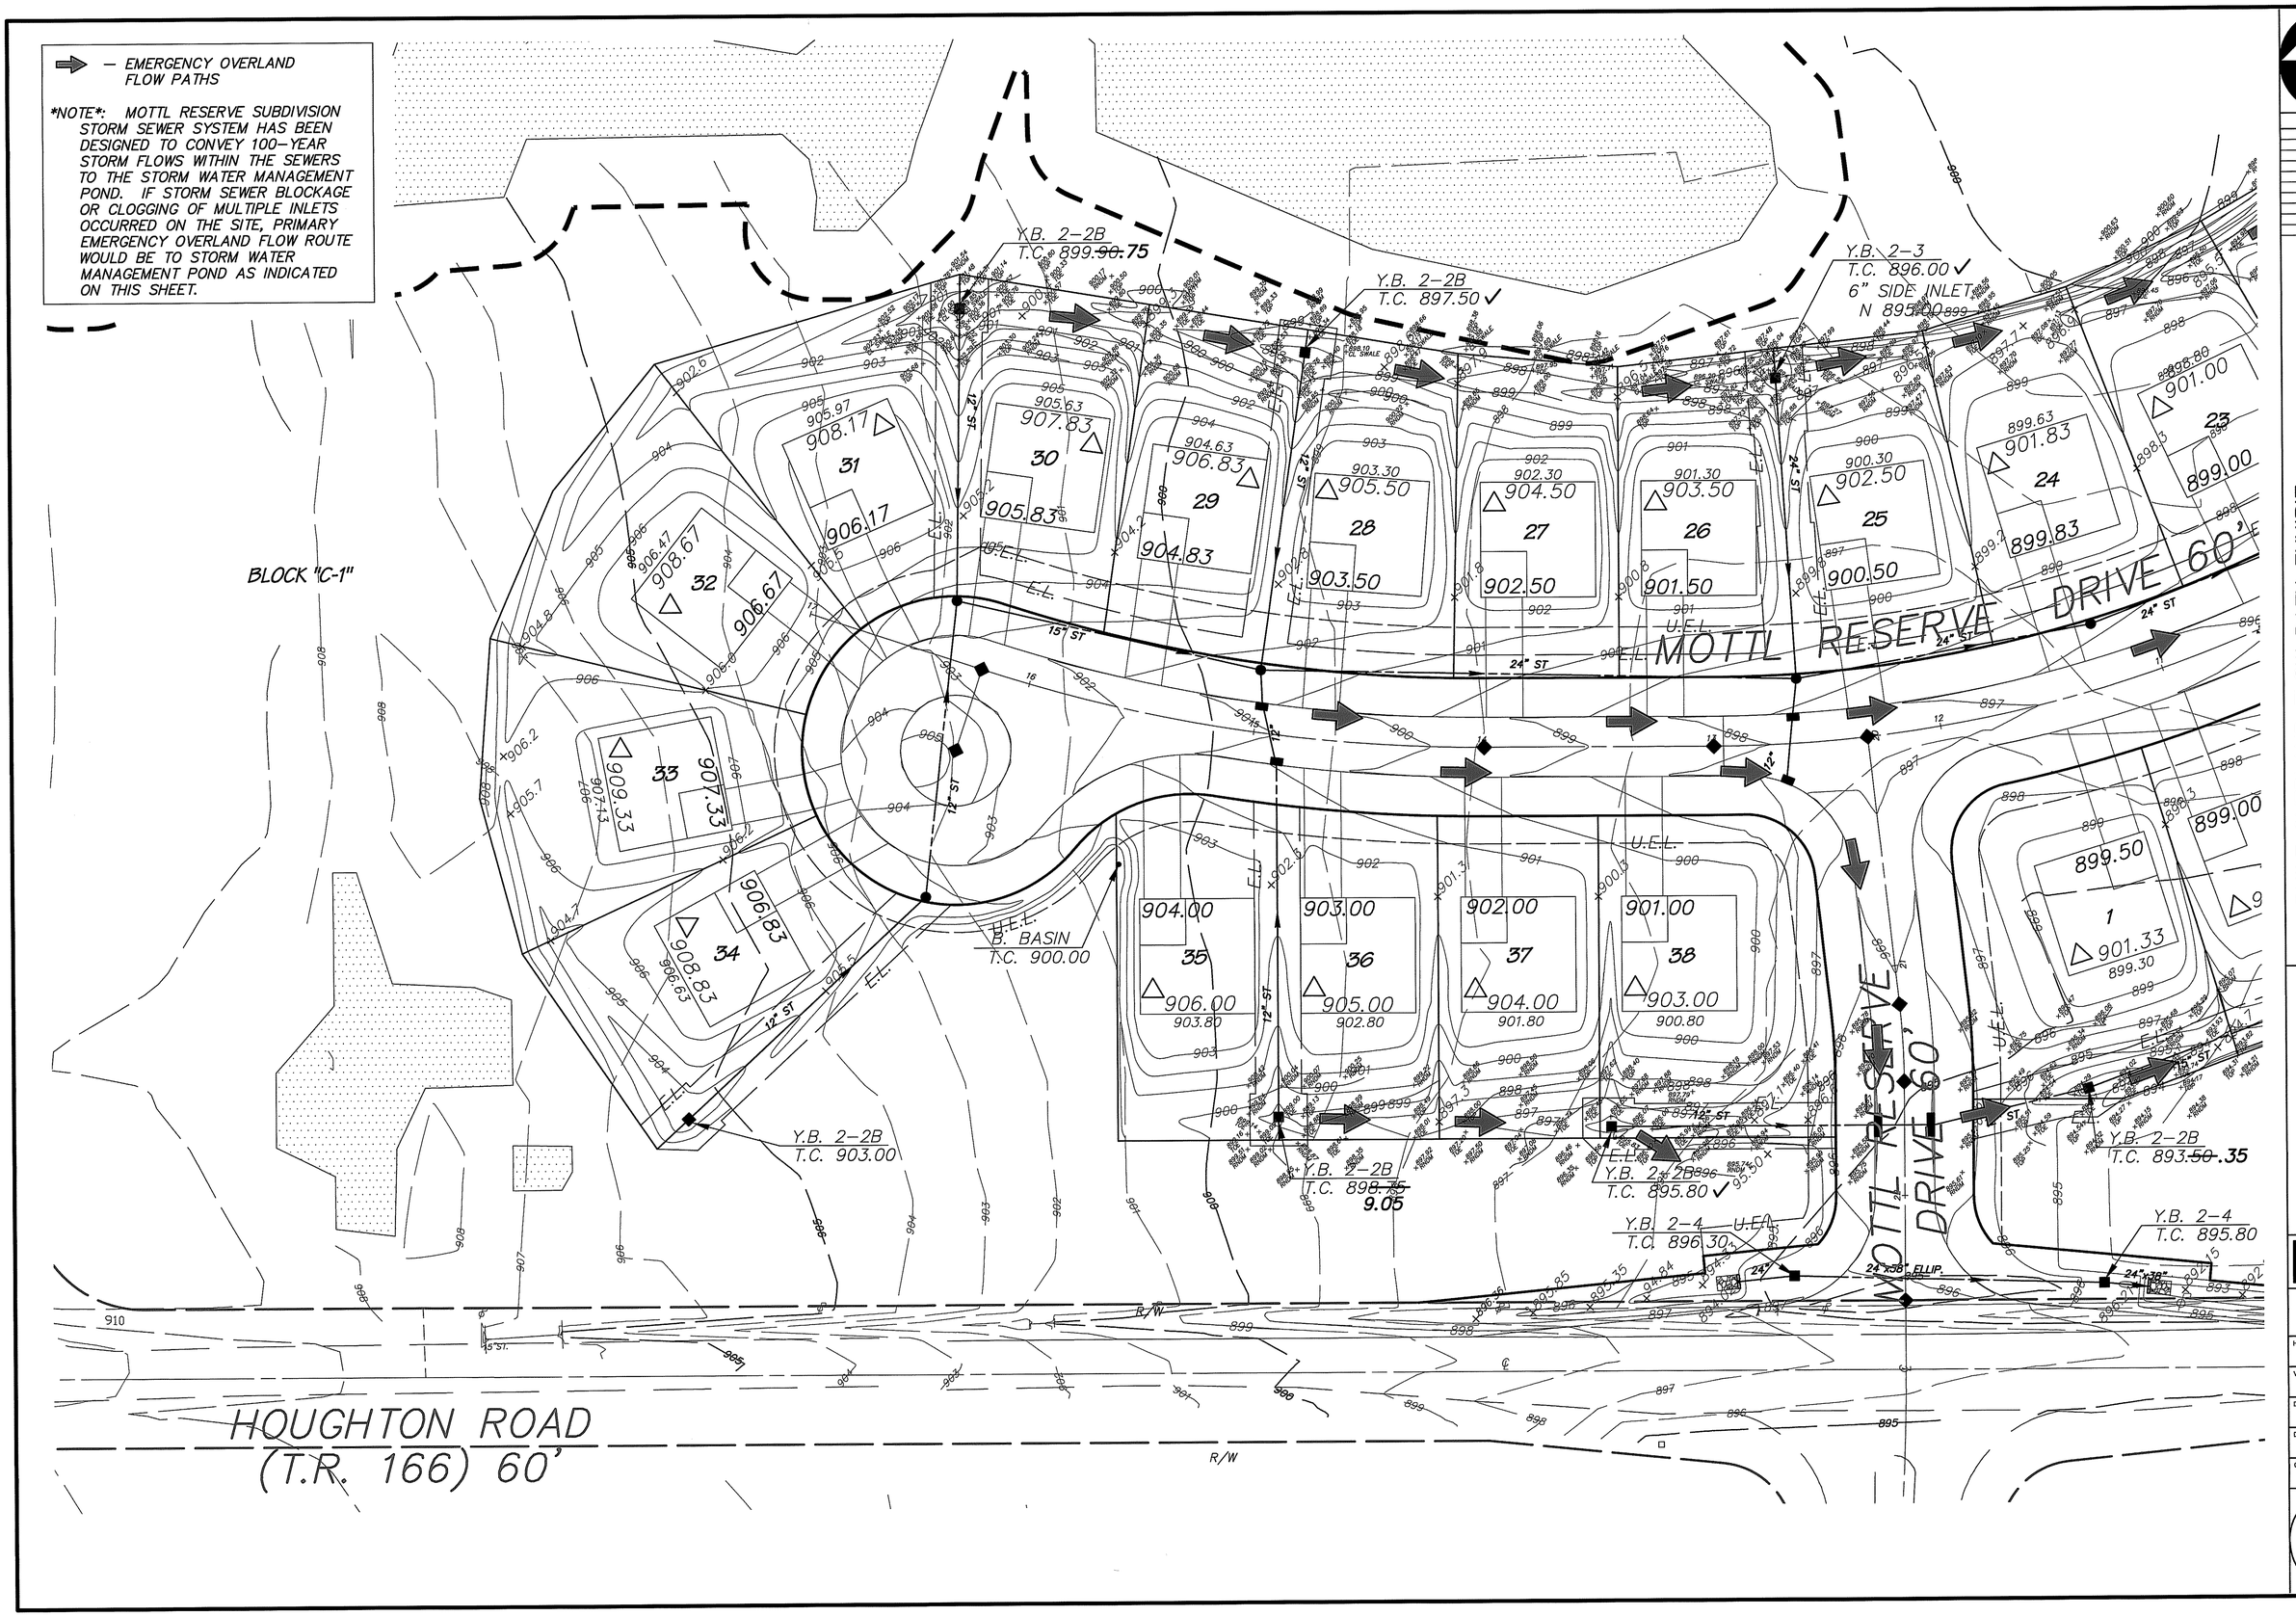

N

REVISIONS

AS-BUILT OVERLAND FLOW PATH EXHIBIT
MOTTL RESERVE SUBDIVISION
PHASES 1 & 2
SAGAMORE HILLS TOWNSHIP
SUMMIT COUNTY, OHIO

DONALD G. BOHNING & ASSOCIATES, INC.
CIVIL ENGINEERING & SURVEYING
7979 HUB PARKWAY • VALLEY VIEW, OHIO 44125
PHONE: (216) 642-1130 FAX: (216) 642-1132

GRAPHIC SCALE 0' 15' 30'

HORIZ. SCALE 1" = 30'

VERT. SCALE ----

DR'N M.D. CKD. D.G.

DATE JAN., 2022

ORDER NO. 3750-10

2/2